
PROJECT NO.	SHEET NO.	TOTAL SHEETS
472-83377	10	23

SCALE: 1" = 10'

6"x12" W4xW4 WIRE FABRIC REINFORCING SHALL BE PLACED SUCH THAT THE WIRES WITH THE 6" SPACING WILL RUN PARALLEL WITH THE LONGITUDINAL JOINT.

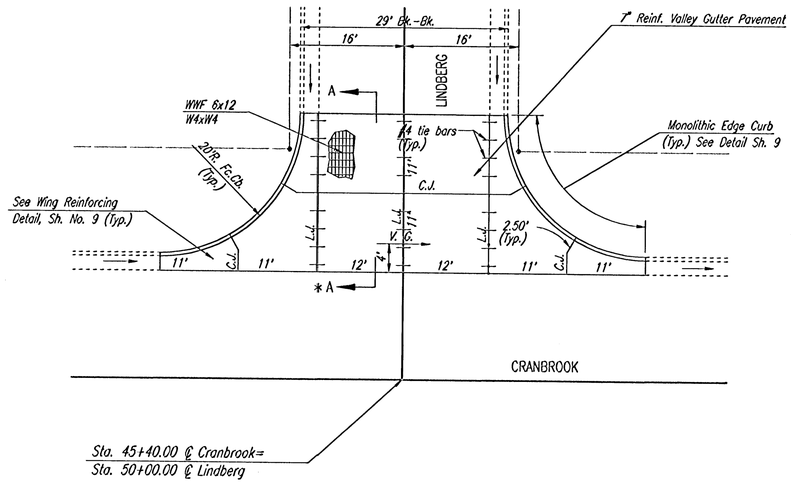


PLAN

REINFORCED VALLEY GUTTER

SCALE: 1" = 10'

6"x12" W4xW4 WIRE FABRIC REINFORCING SHALL BE PLACED SUCH THAT THE WIRES WITH THE 6" SPACING WILL RUN PARALLEL WITH THE LONGITUDINAL JOINT.

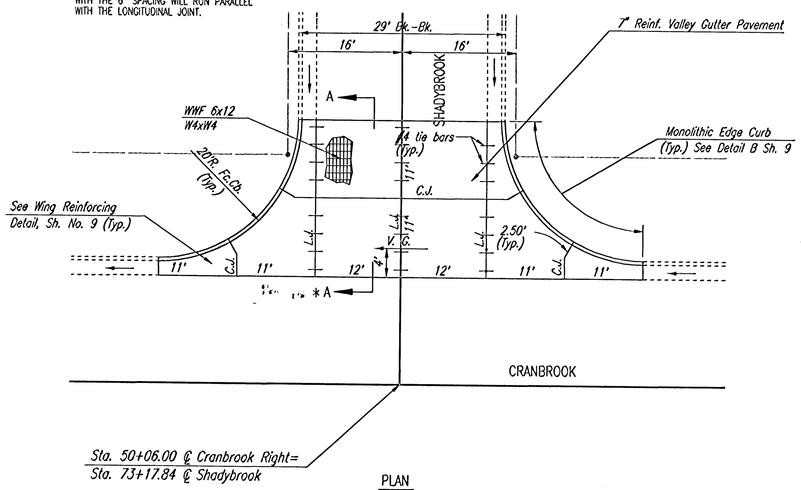


PLAN

REINFORCED VALLEY GUTTER

SCALE: 1" = 10'

6"x12" W4xW4 WIRE FABRIC REINFORCING SHALL BE PLACED SUCH THAT THE WIRES WITH THE 6" SPACING WILL RUN PARALLEL WITH THE LONGITUDINAL JOINT.

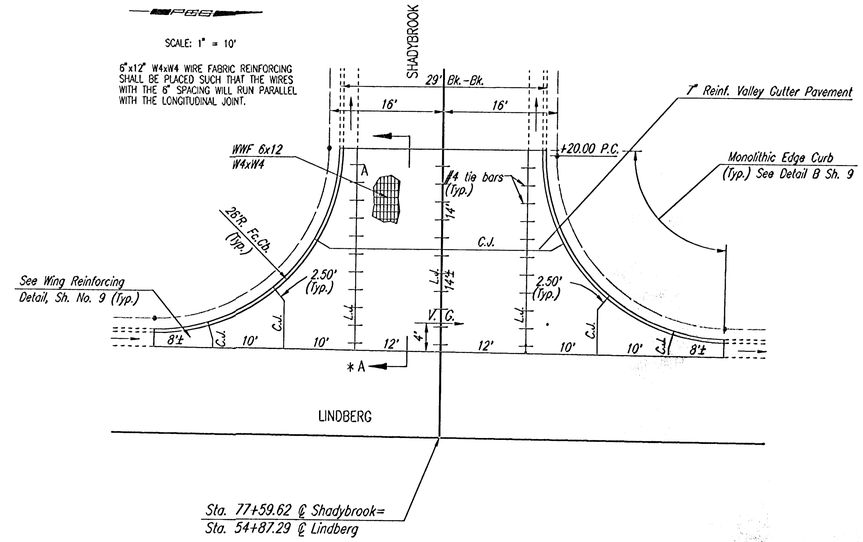

PLAN

REINFORCED VALLEY GUTTER

* See Sh. No. 9 for Section A-A

RECORD DRAWING
Brad Eaton 24 NOV 03

REMINGTON PLACE - PHASE 3

VALLEY GUTTER PLANS

Professional Engineering Consultants, P.A.
303 S. TOPEKA • WICHITA, KANSAS 67202
316-262-2691 • FAX 316-262-3003

Designed by	BER	Checked by	
Drawn by	DEP	Date DEC., 2002	Job No. 02398-004

DSNR: RRY OPER: DEP SCALE: 1=10.00
Q:\2002\02398\004\VALGUTPLAN3 12-03-2002 03:45:52 pm