REMINGTON PLACE

AN ADDITION TO WICHITA, SEDGWICK COUNTY, KANSAS


SCALE: 1" = 100'

PROJECT NO.	SHEET NO.	TOTAL SHEETS
472-83377	12	23

a MINIMUM OPENING= 203.5
b MINIMUM OPENING= 210.6
c MINIMUM OPENING= 210.5
d MINIMUM OPENING= 208.7
f MINIMUM OPENING= 207.5

(X) STD. BASEMENT
(VO) VIEW-OUT BASEMENT
(WO) WALK-OUT BASEMENT
* Match existing

21ST STREET NORTH
CRANBROOK
LINDBERG
RESERVE "A"
RESERVE "C"
SHADYBROOK
RESERVE "D"
CHURCHILL
RED OAKS
FREDERIC
19TH STREET NORTH
19TH COURT NORTH
CRANBROOK COURT
RESERVE "K"
RESERVE "L"
RESERVE "N"
RESERVE "B"
VINEGATE
HANLEY SECOND ADDITION
ST. LOUIS, WICHITA AND WESTERN RAILWAY CO.
NOW BURLINGTON NORTHERN - SANTA FE

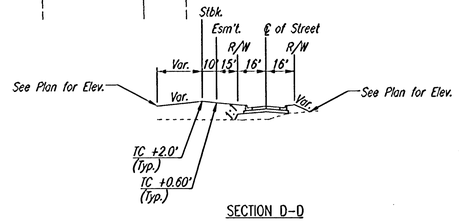

SECTION D-D

RECORD DRAWING
24 NOV 03

REMINGTON PLACE - PHASE 3

FOUR CORNER LOT GRADING

Professional Engineering Consultants, P.A.
303 S. TOPEKA • WICHITA, KANSAS 67202
316-262-2691 • FAX 316-262-3003

Designed by	BER	Checked by	
Drawn by	SAW	Date DEC., 2002	Job No. 02398-004

DSNR: SAD OPER: DEP SCALE: 1=100.00
C:\2002\02398\004\4CORNER 12-03-2002 03:44:38 pm