
PROJECT NO.	SHEET NO.	TOTAL SHEETS
472-83377	20	23

NO.	NOTE BOOK	TEMPLATE AREAS CHECKED

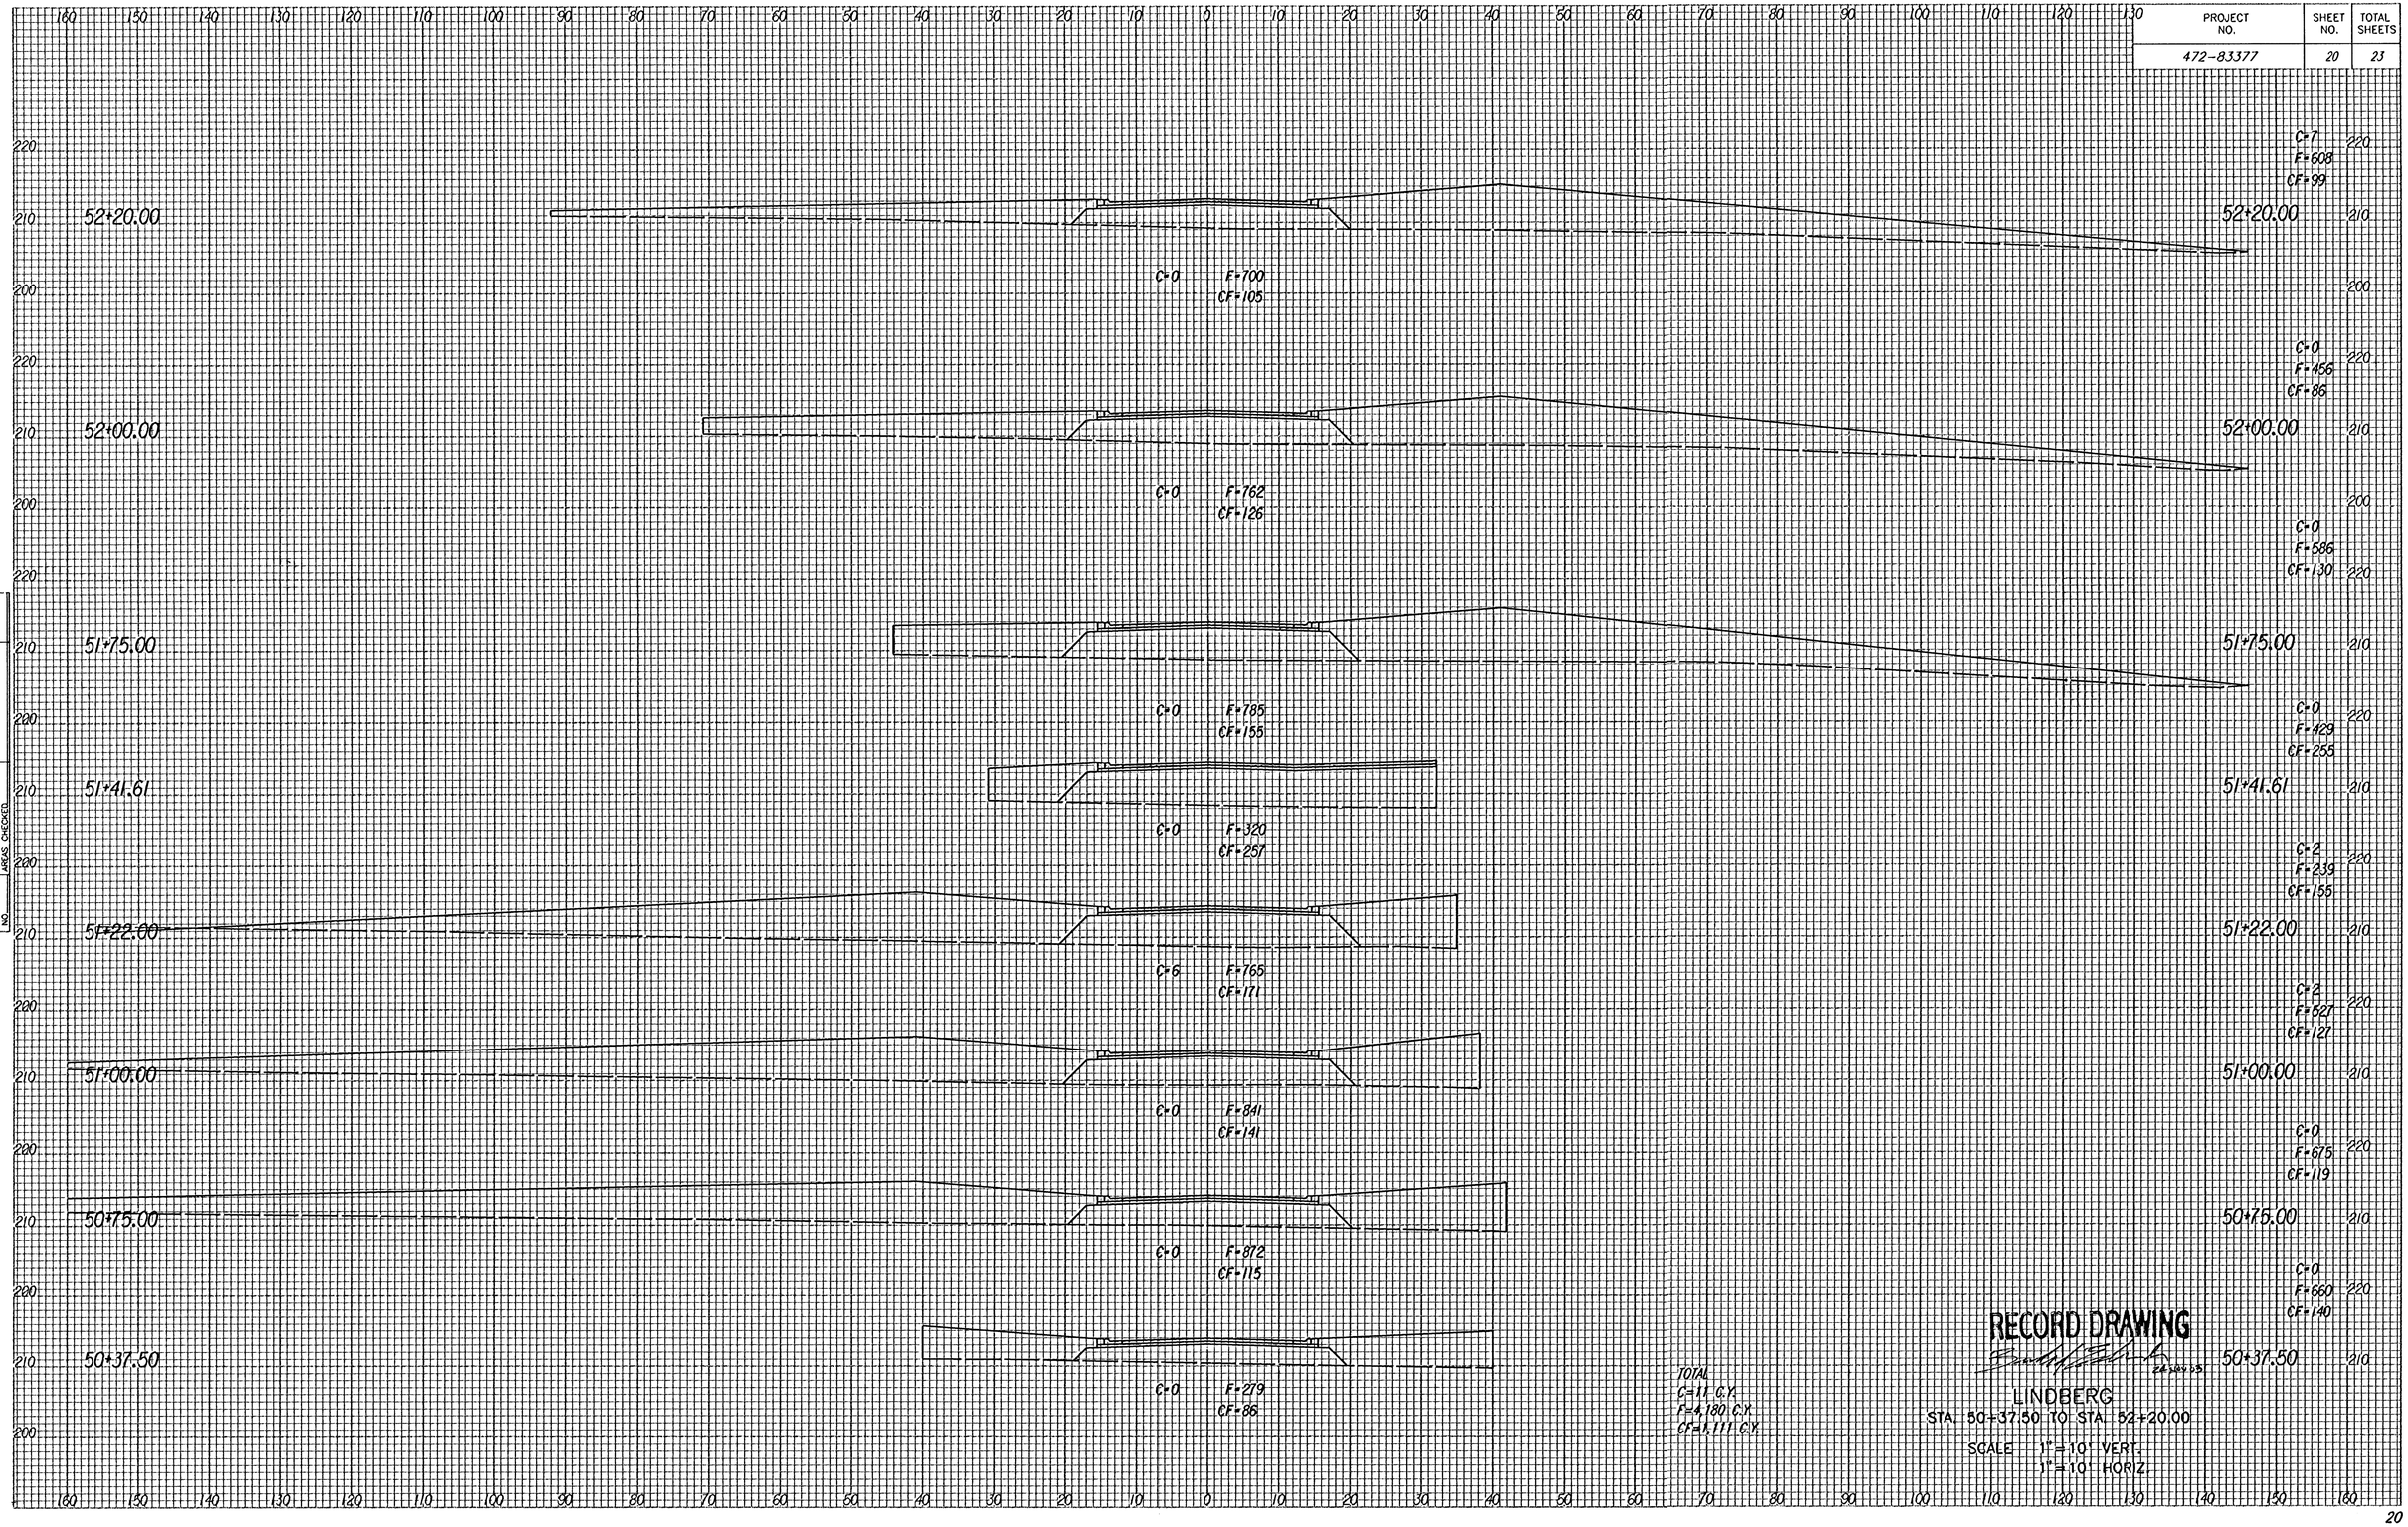

TOTAL
C=11 C.Y.
F=4,180 C.Y.
CF=1,111 C.Y.

RECORD DRAWING

LINDBERG
STA. 50+37.50 TO STA. 52+20.00

SCALE 1"=10' VERT.
1"=10' HORIZ.