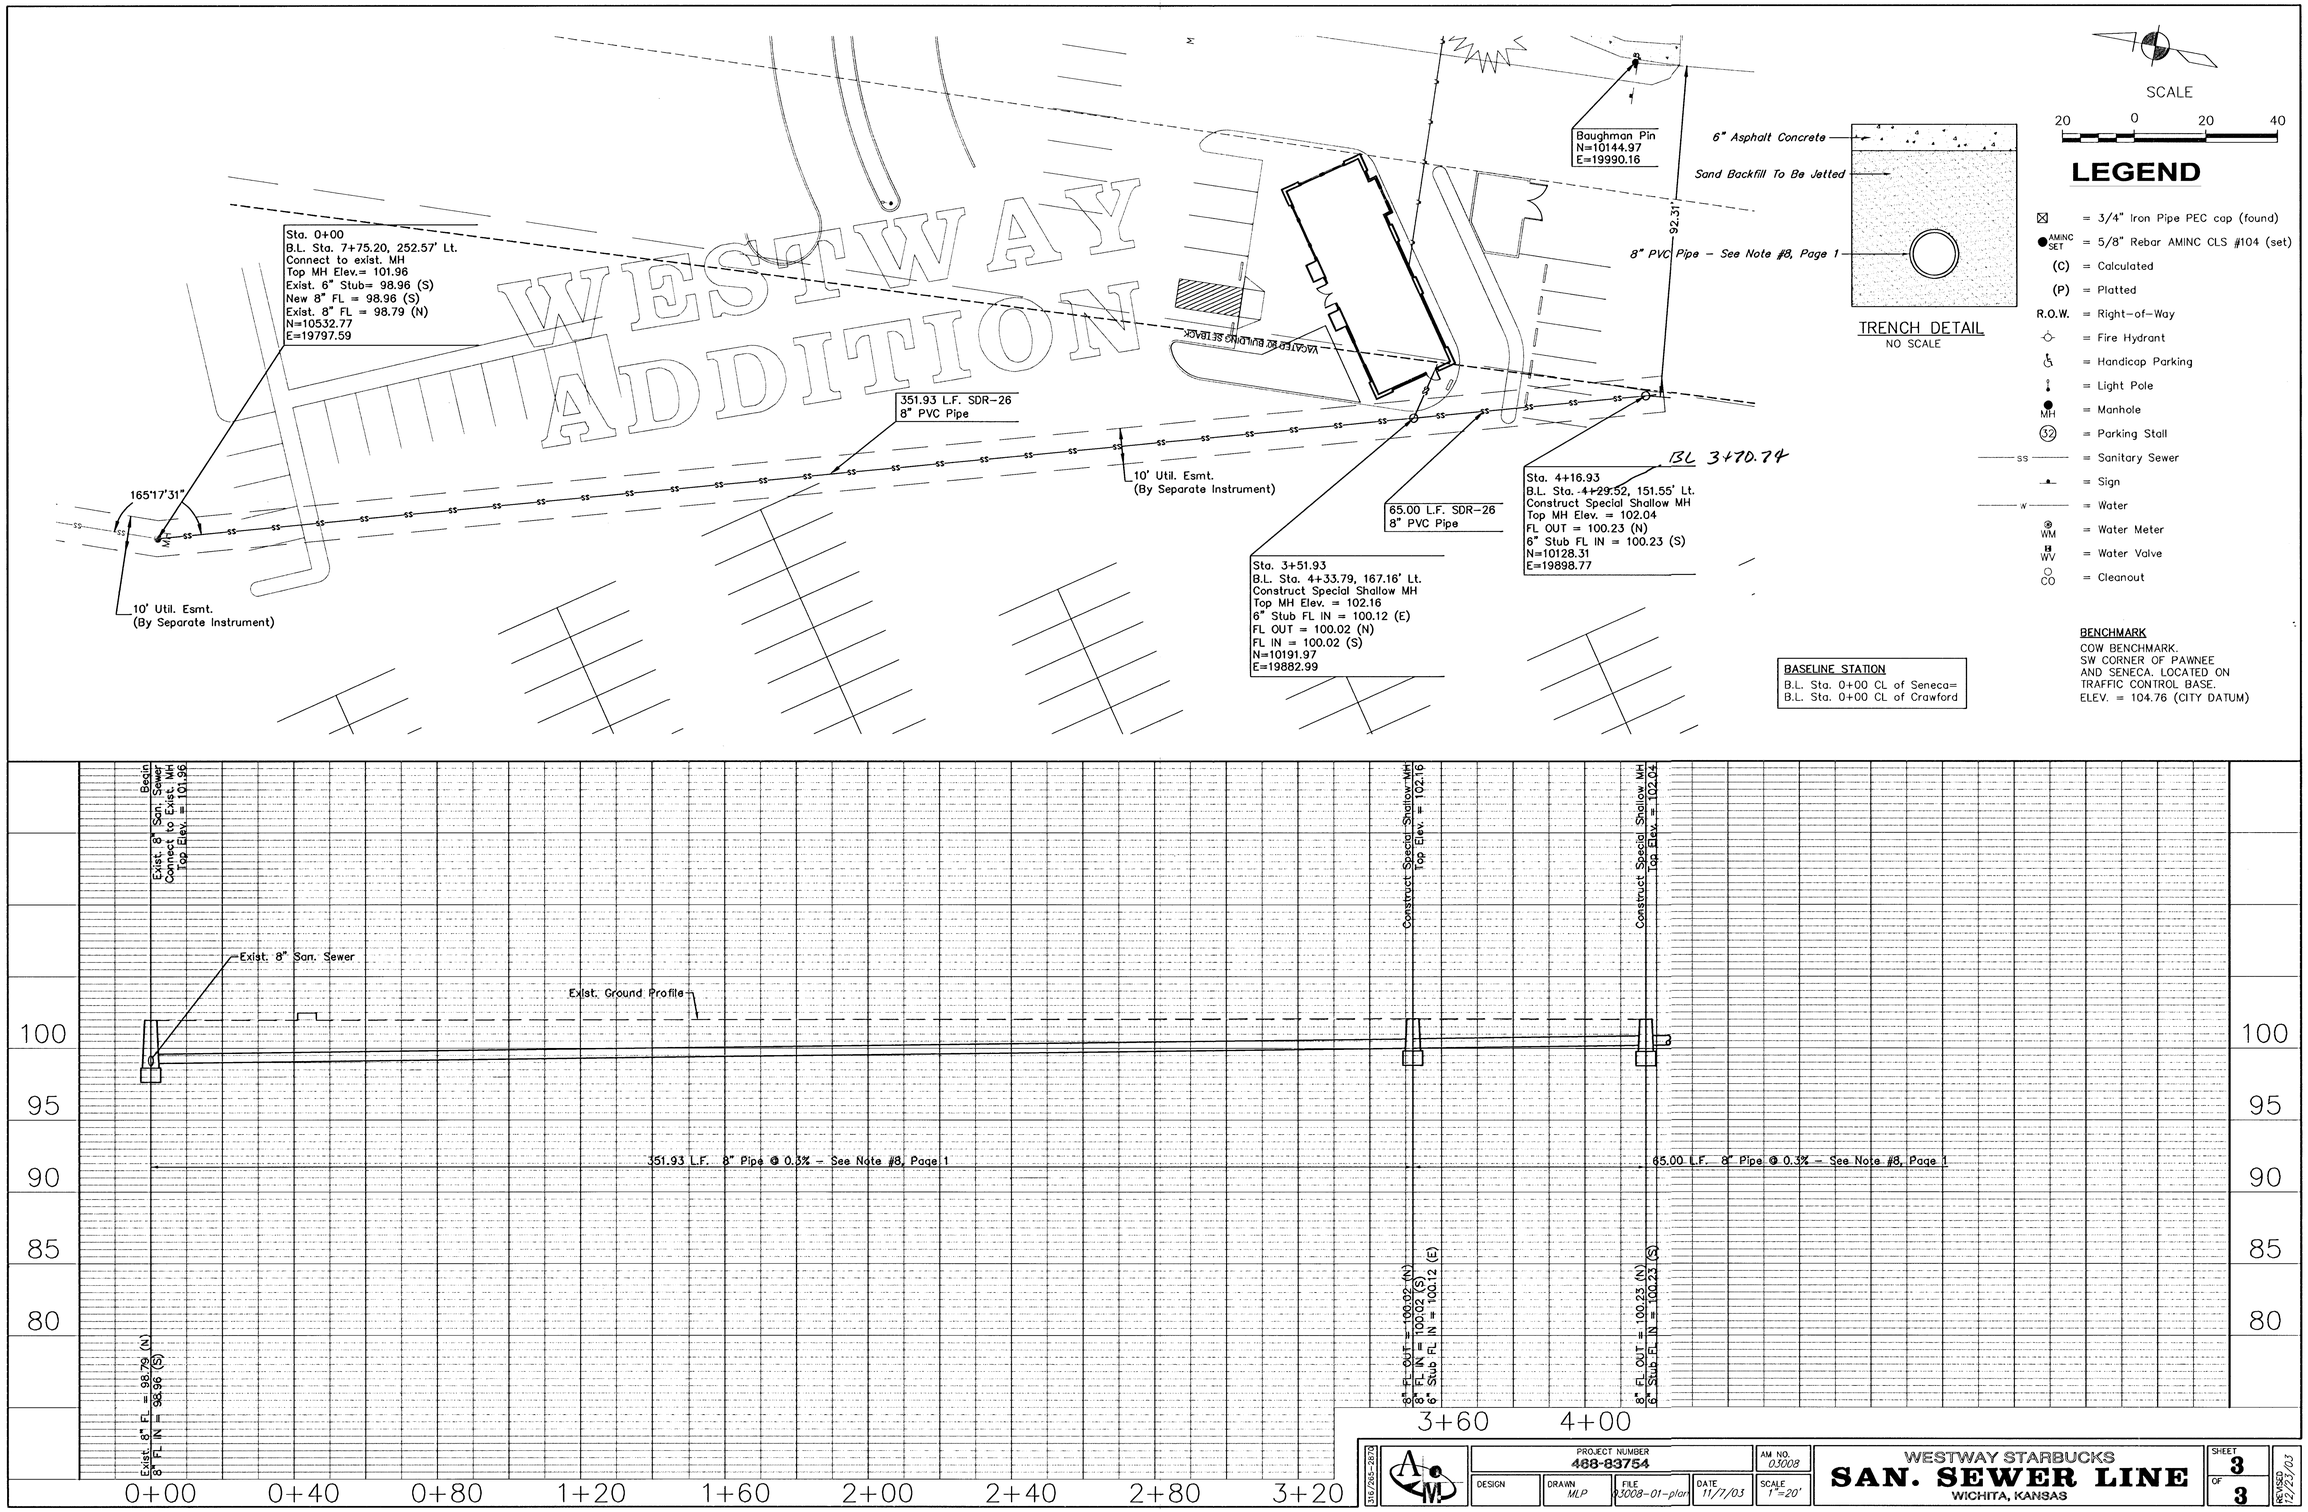

316/265-2673	PROJECT NUMBER 468-83754			AM NO. 03008	WESTWAY STARBUCKS **SAN. SEWER LINE** WICHITA, KANSAS
	DESIGN	DRAWN MLP	FILE 03008-01-plan	DATE 11/7/03	SCALE 1"=20'

SHEET 3 OF 3

REVISED 12/23/03

05-80-10-01