

WOODLAND LAKES ESTATES THIRD ADD. - ZELTA PHASE
PROJ. NO. 468-83593

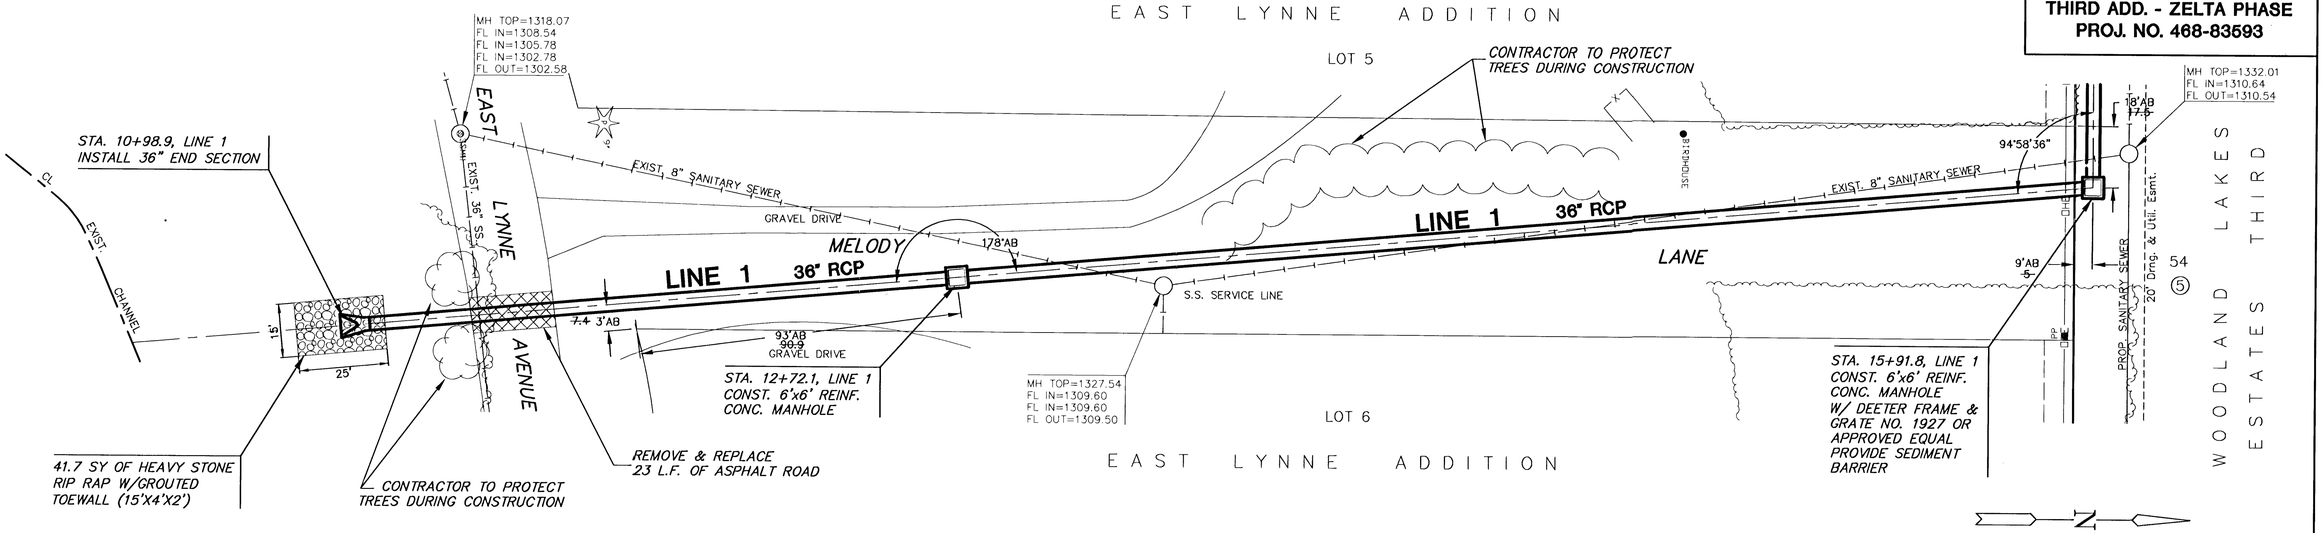

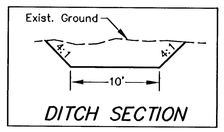

DITCH SECTION

FOR INFORMATION ONLY:


ESMT. GRADING: LINE 1	
CUT	26 C.Y.
FILL	0 C.Y.

PLAN LINE 1

AS-BUILT FEBRUARY 2004

PROFILE LINE 1

SCALE: HORIZ. 1"=20'
SCALE: VERT. 1"=5'

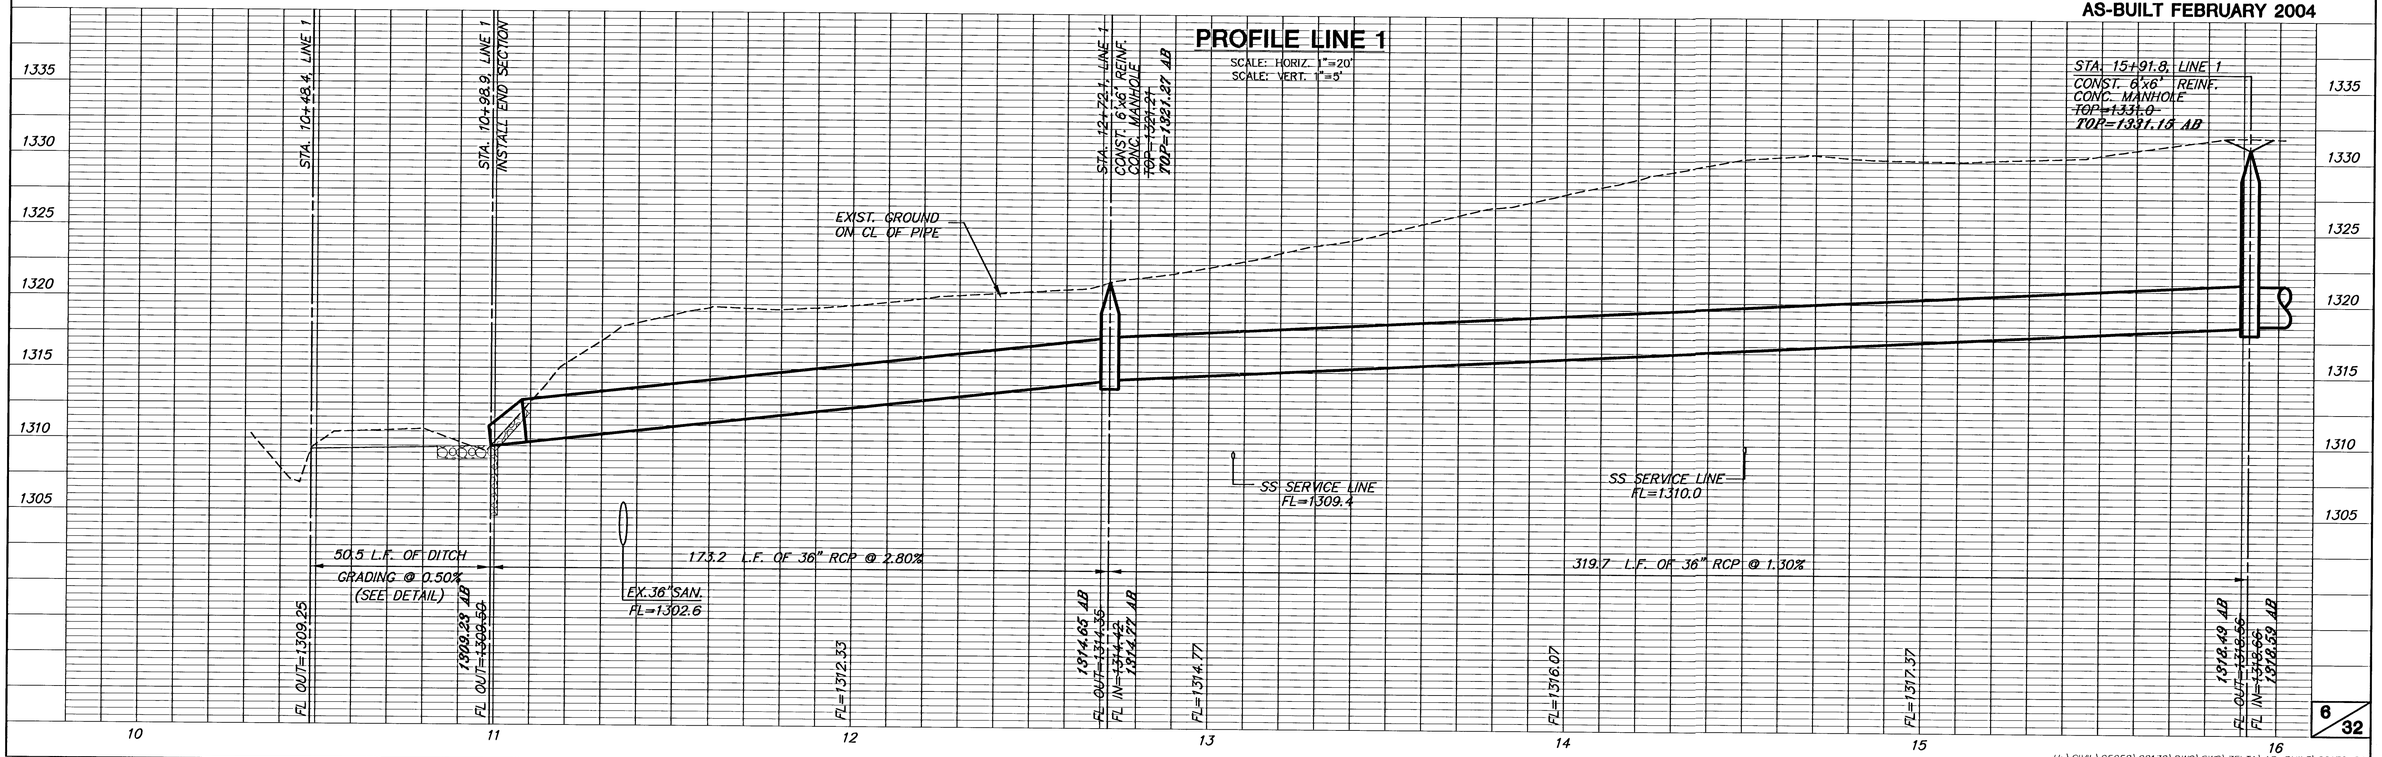

H:\CIVIL\95058\02172\DWG\SWS\ZELTA\AS-BUILT\02172_D1