
WOODLAND LAKES ESTATES THIRD ADD. - ZELTA PHASE
PROJ. NO. 468-83593

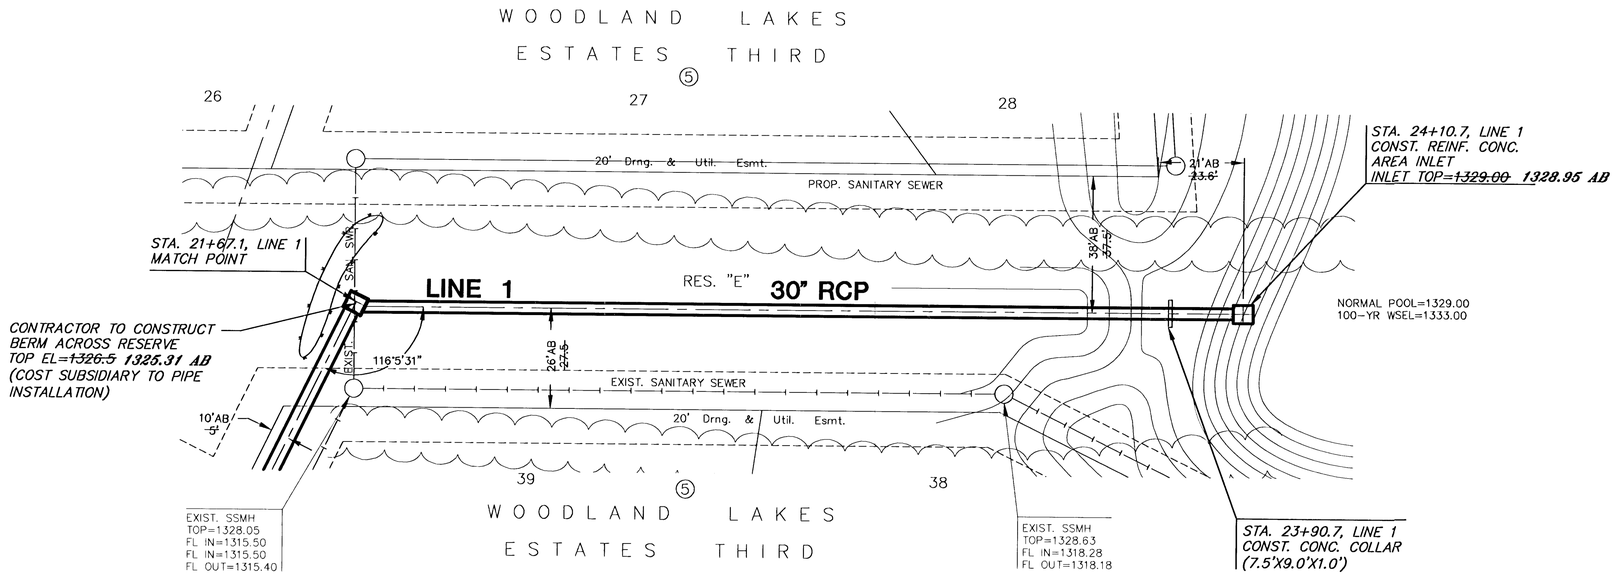

PLAN LINE 1


SCALE: 1"=20'

= TREE REMOVAL

AS-BUILT FEBRUARY 2004

PROFILE LINE 1

SCALE: HORIZ. 1"=20'
SCALE: VERT. 1"=5'

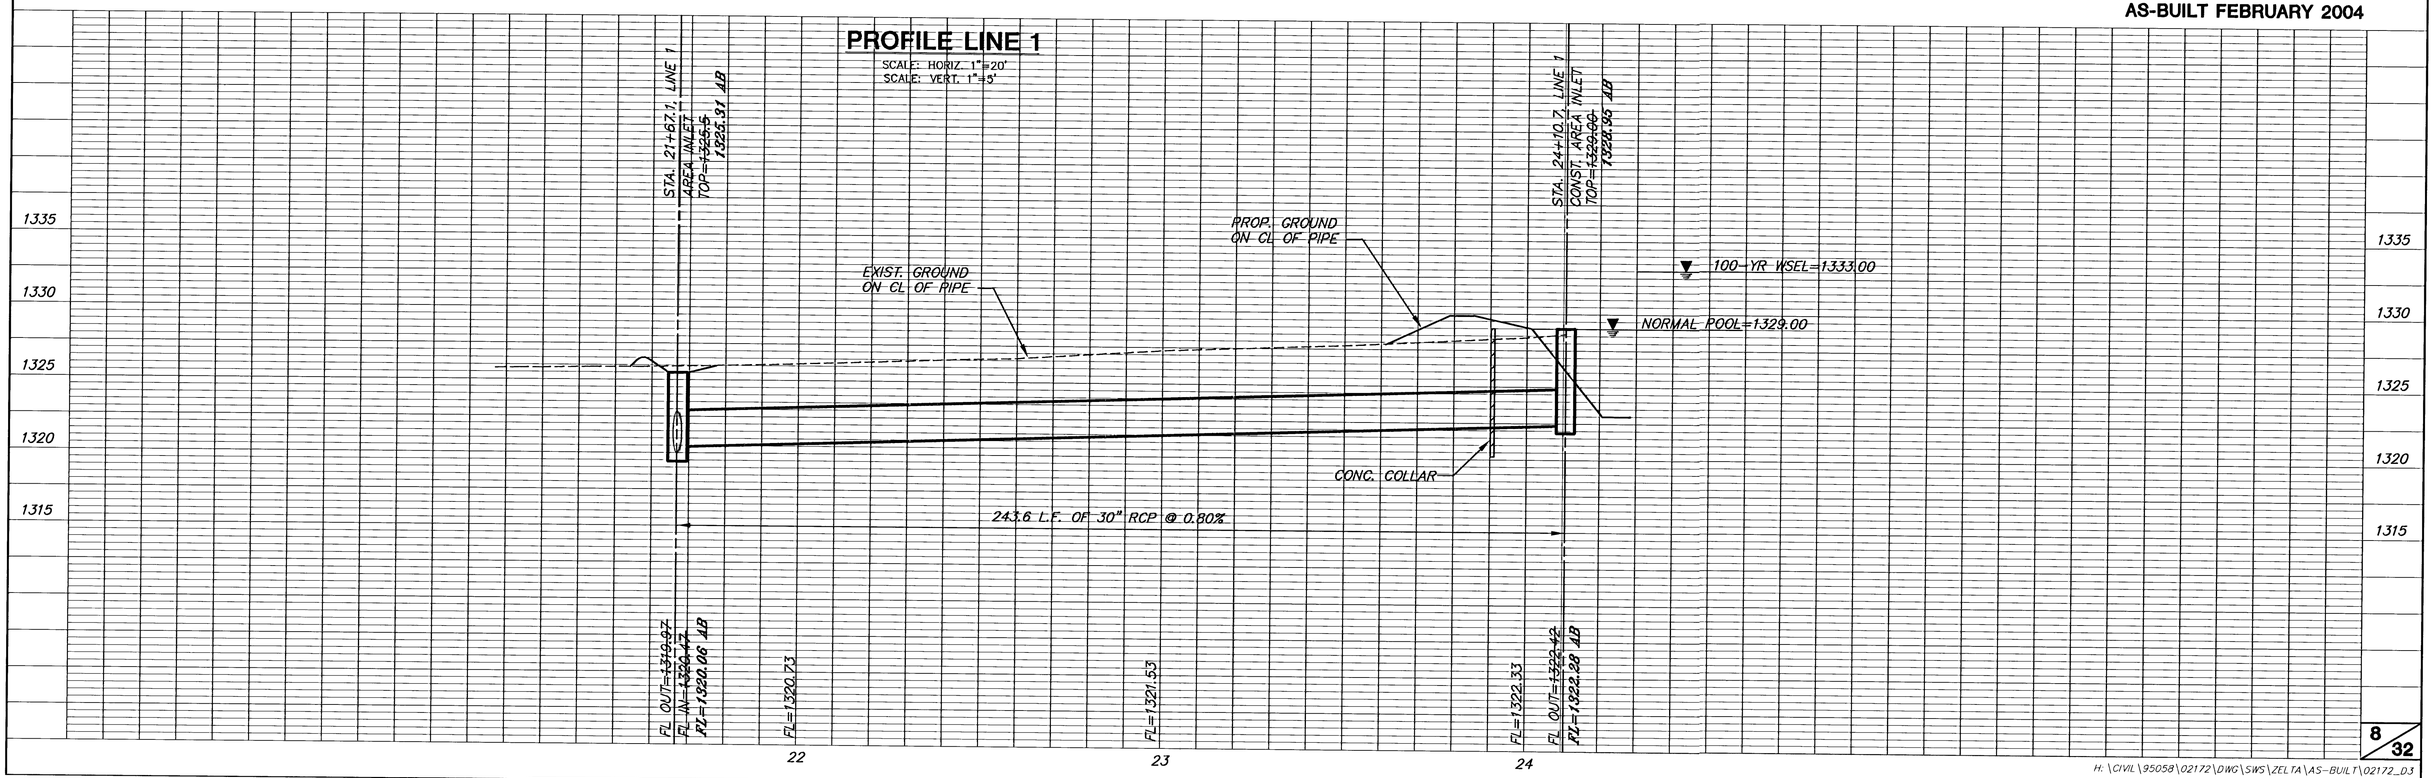

H:\CIVIL\95058\02172\DWG\SWS\ZELTA\AS-BUILT\02172_03