
WOODLAND LAKES ESTATES THIRD ADD. - ZELTA PHASE
PROJ. NO. 468-83593

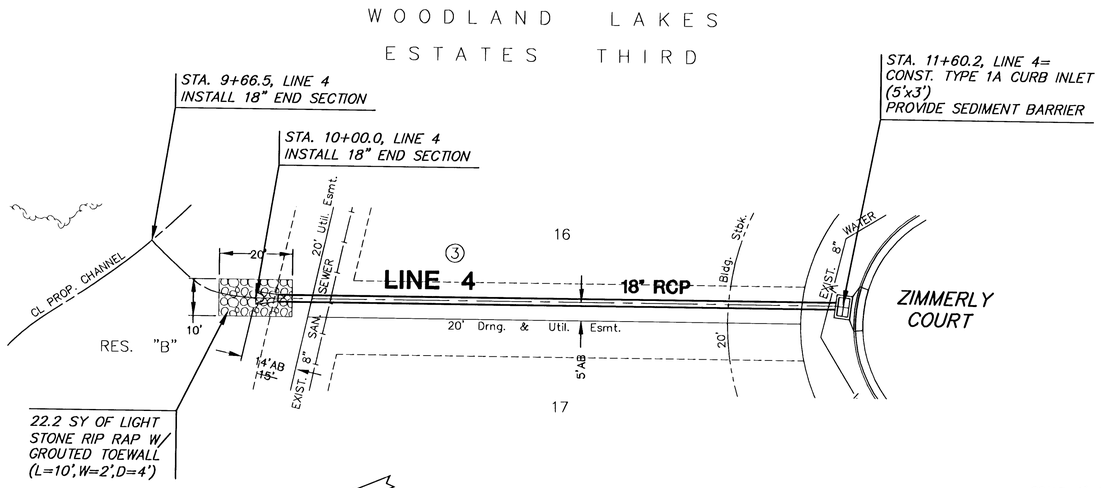


PLAN LINE 4

FOR INFORMATION ONLY:

ESMT. GRADING: LINE 4	
CUT	21 C.Y.
FILL	0 C.Y.

SCALE: 1"=20'
20 10 0 20

= TREE REMOVAL

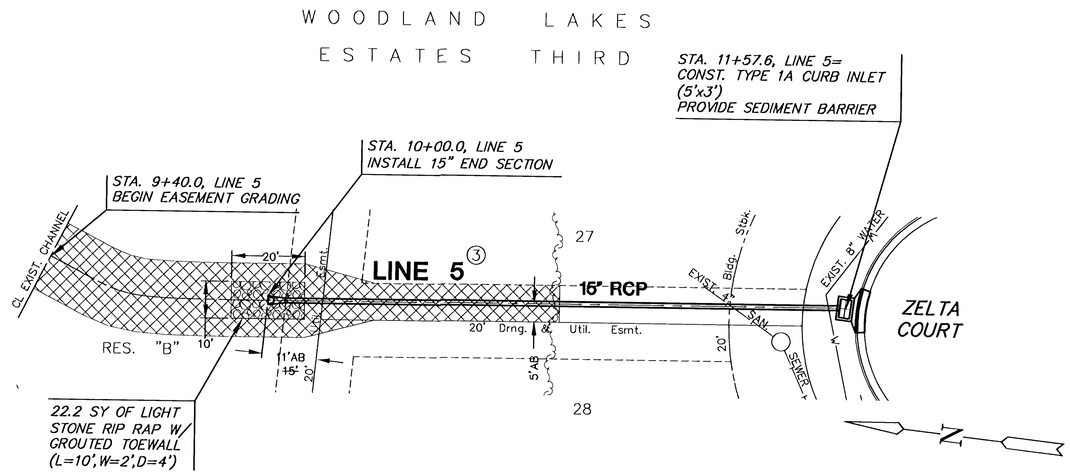

PLAN LINE 5


FOR INFORMATION ONLY:

ESMT. GRADING: LINE 5	
CUT	37 C.Y.
FILL	0 C.Y.

AS-BUILT FEBRUARY 2004


PROFILE LINE 4

SCALE: HORIZ. 1"=20'
SCALE: VERT. 1"=5'

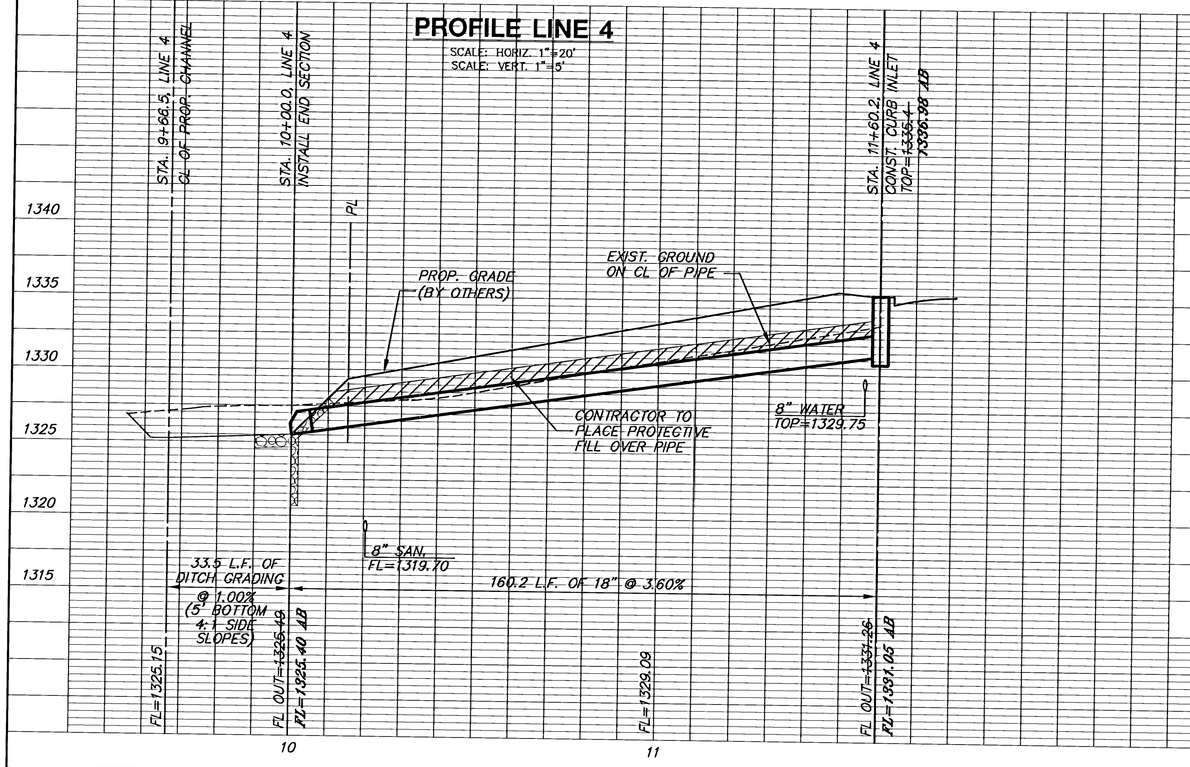

PROFILE LINE 5

SCALE: HORIZ. 1"=20'
SCALE: VERT. 1"=5'

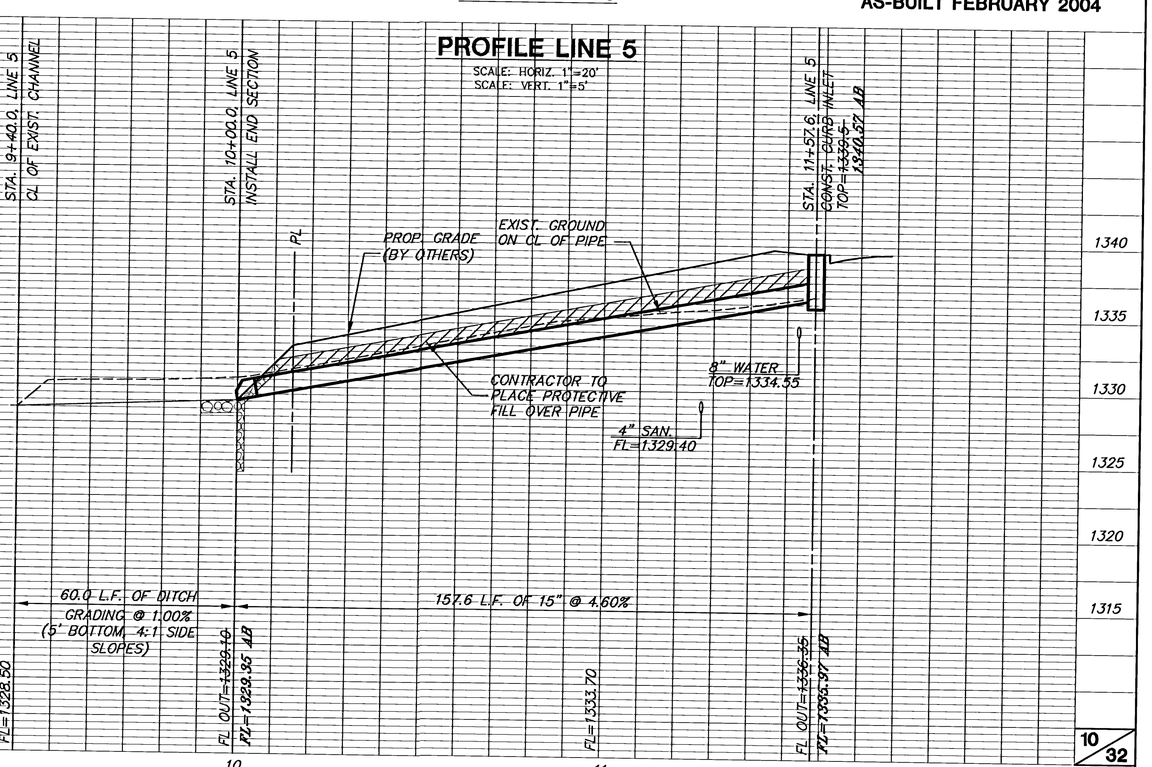

H:\CIVIL\95058\02172\DWG\SWS\ZELTA\AS-BUILT\02172_05