



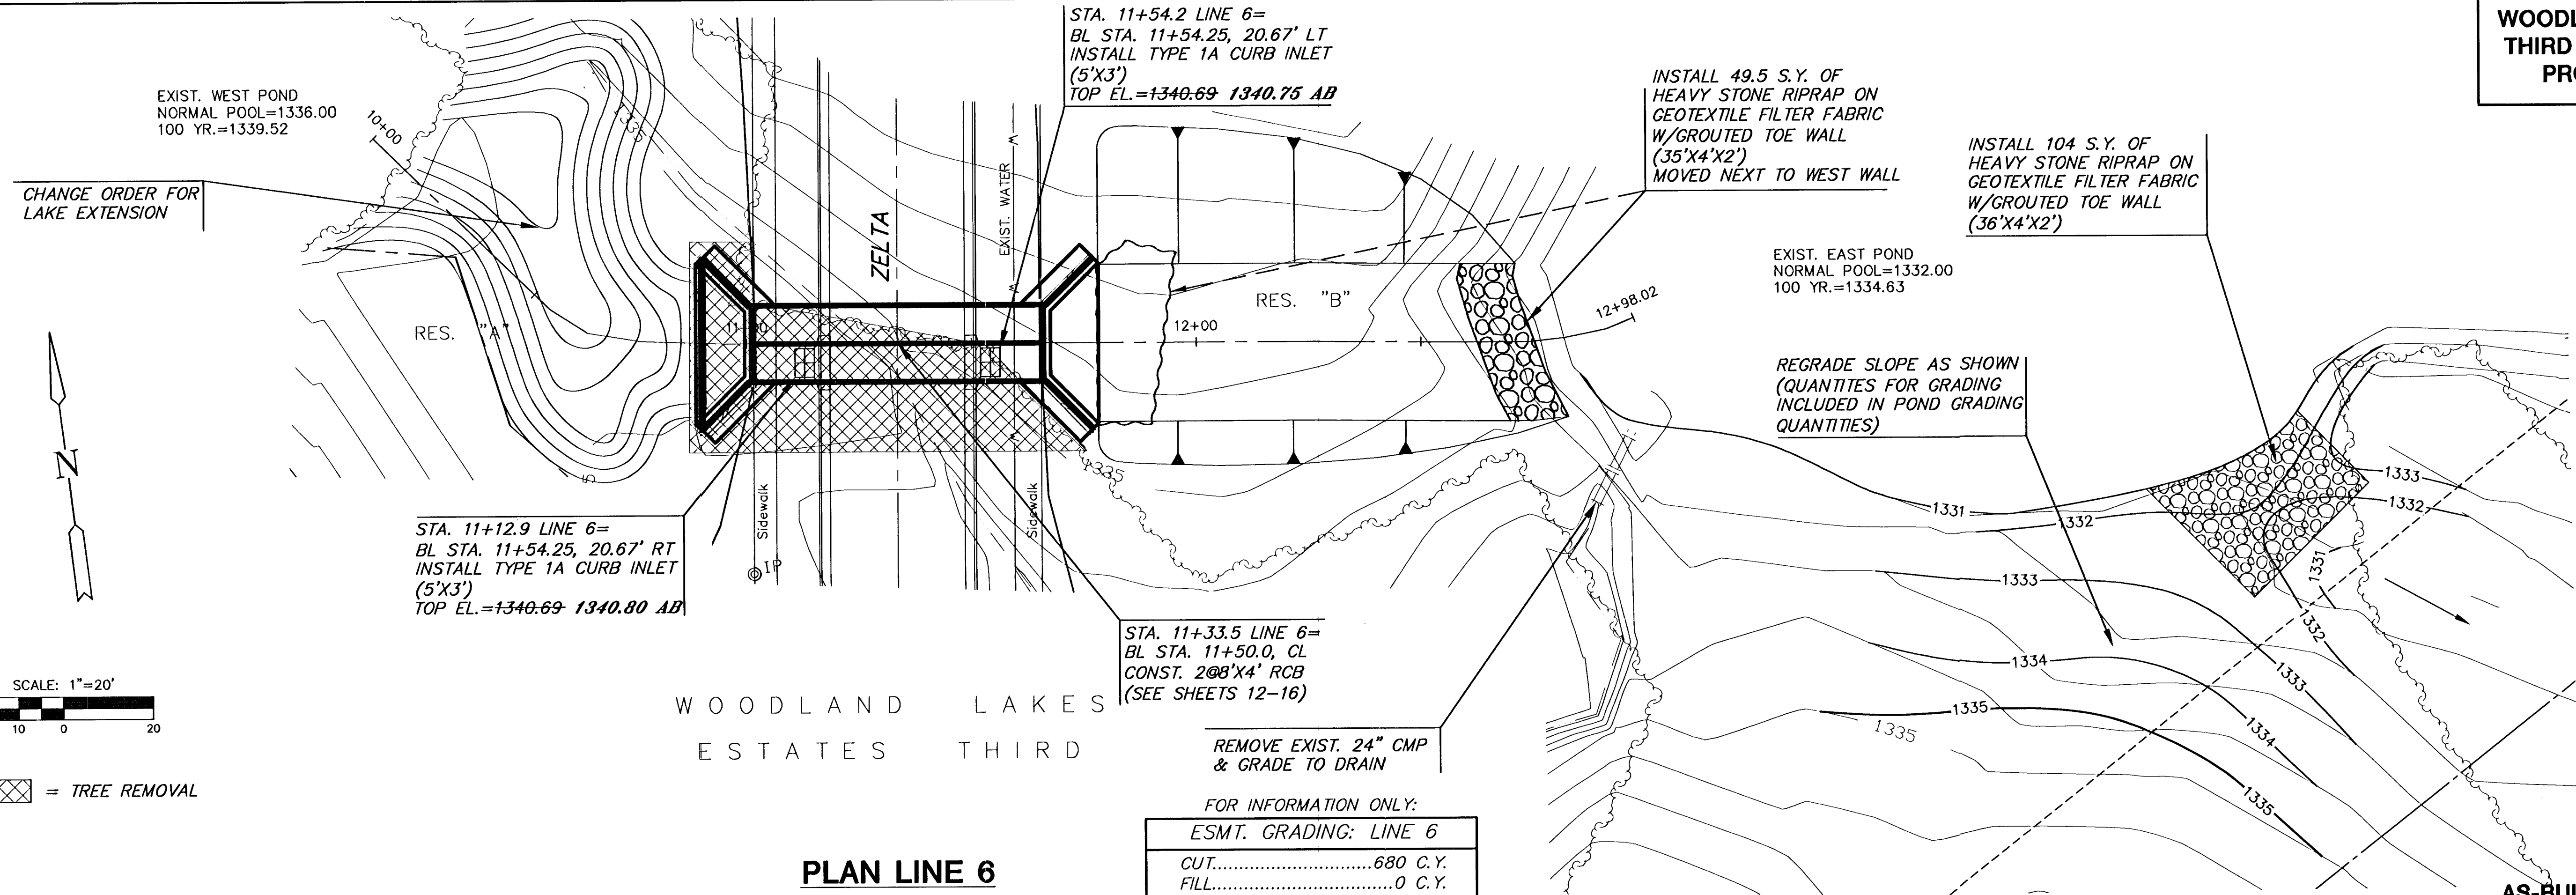

PLAN LINE 6

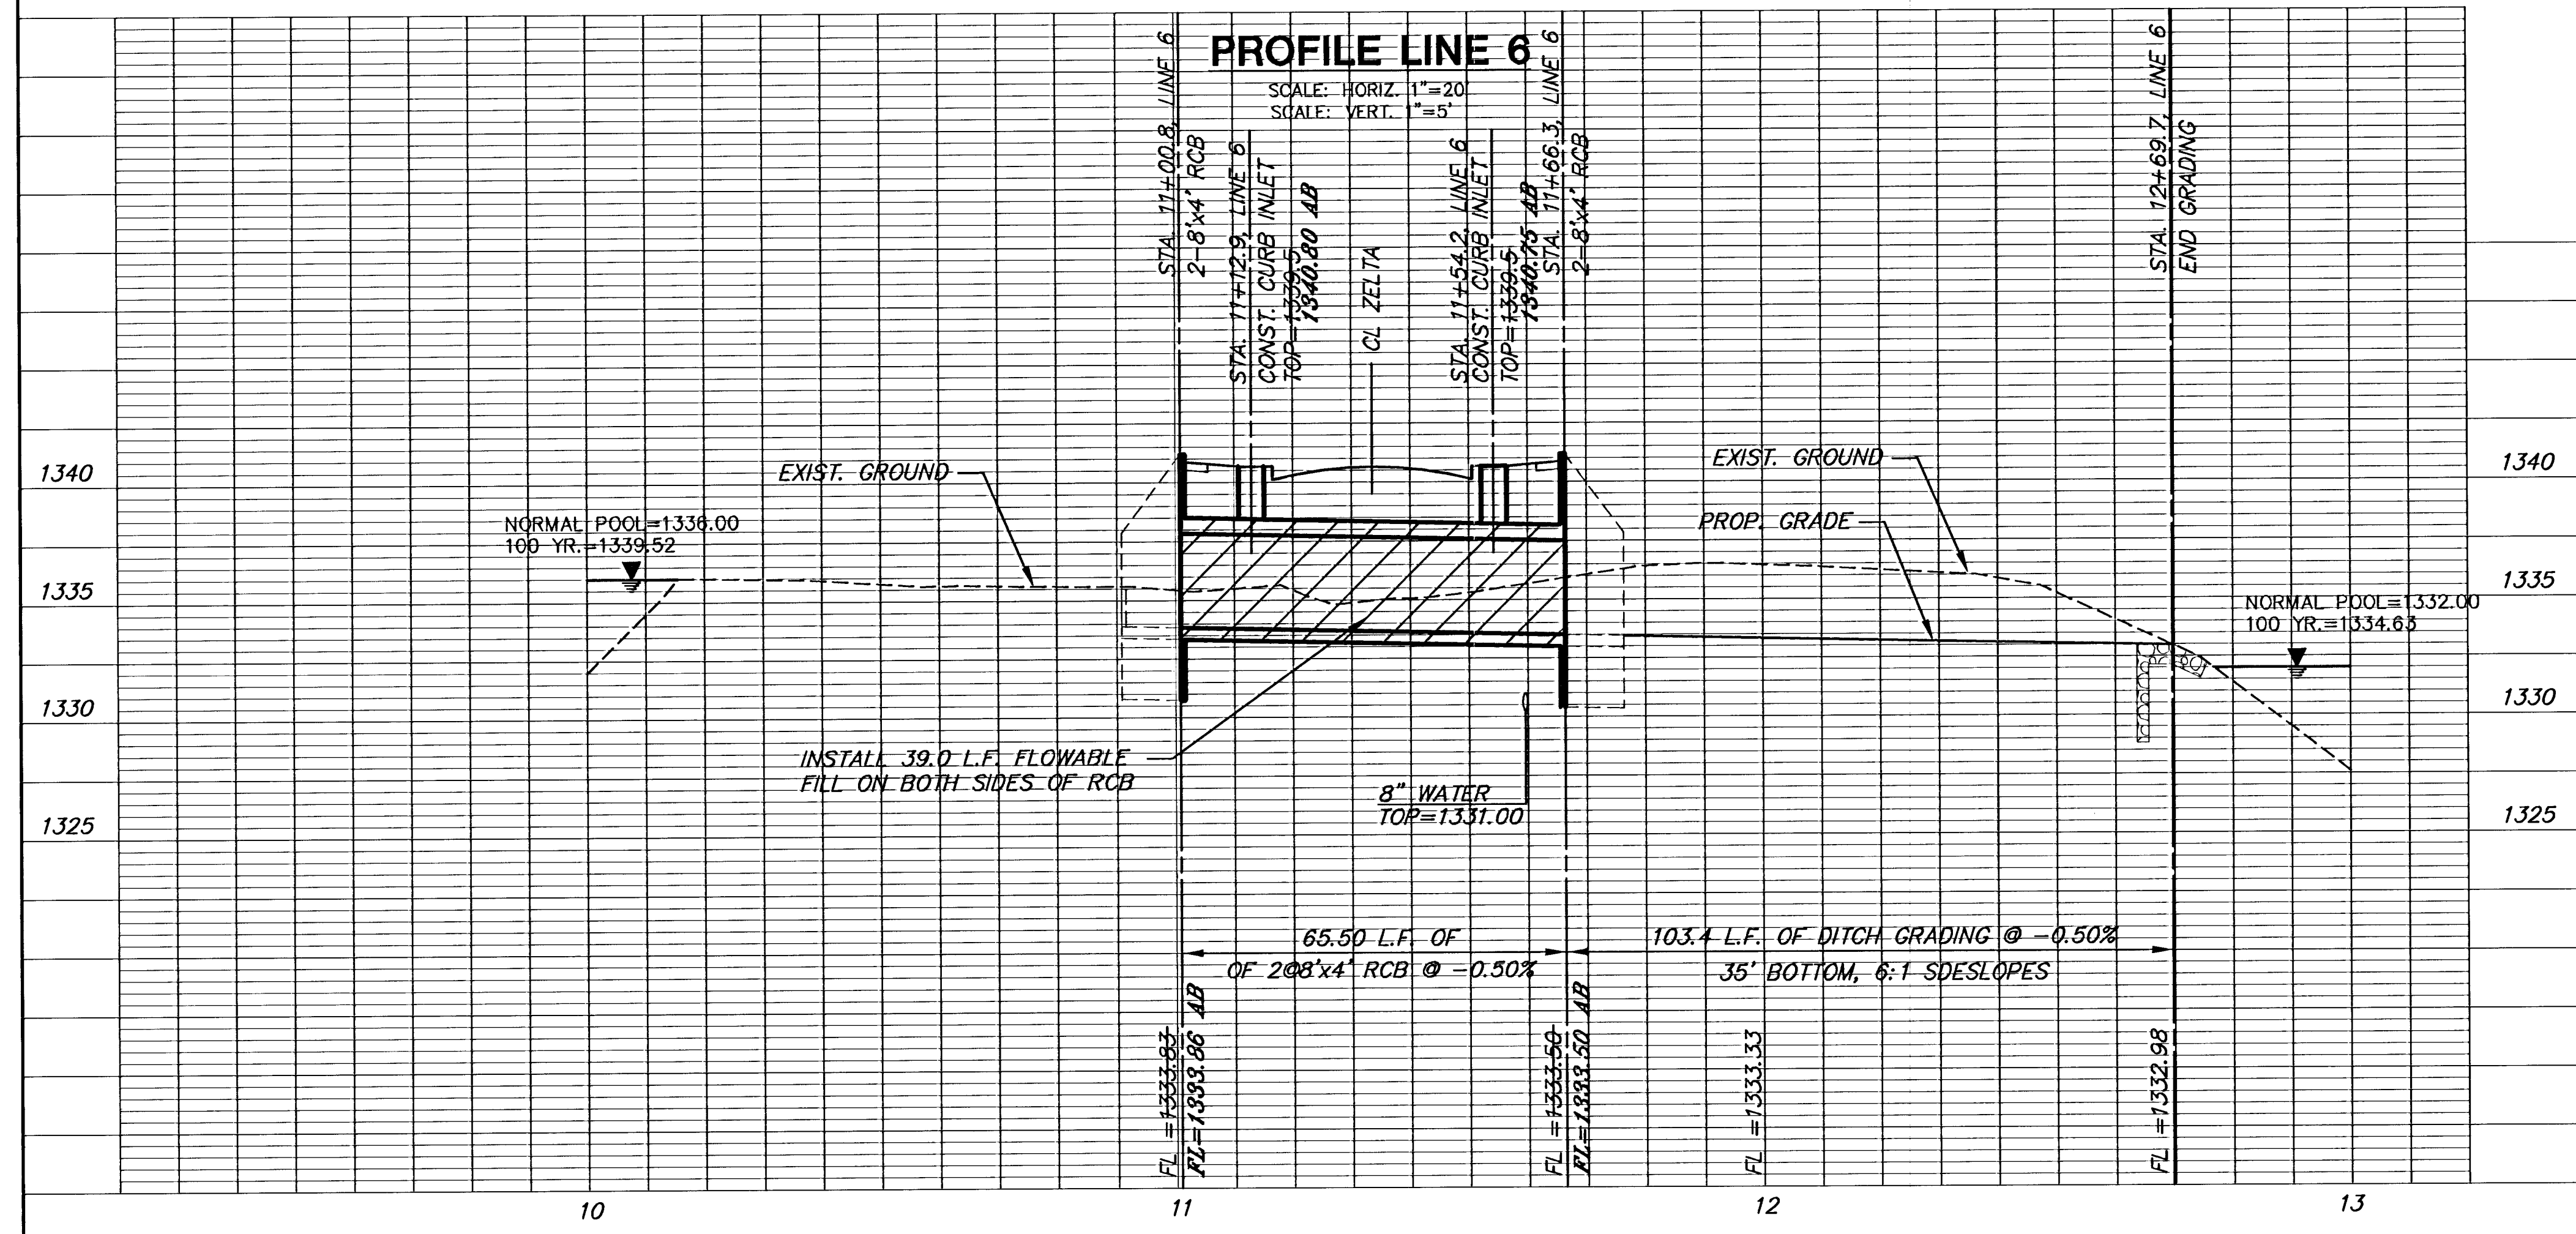

PROFILE LINE 6

