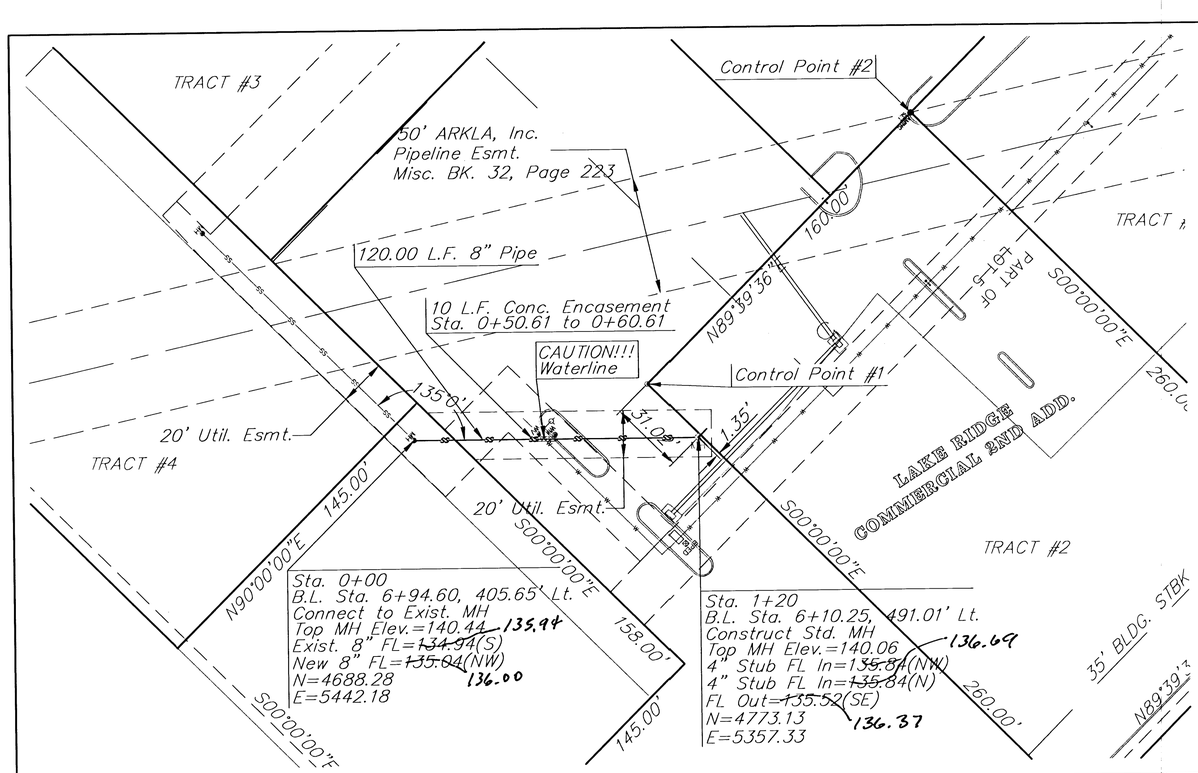

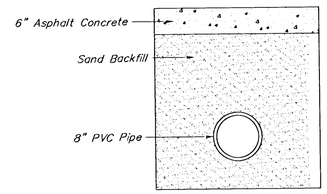

TRENCH DETAIL
NO SCALE

SCALE
30' 0 30' 60'
5' 0 5'

CONTROL POINTS
SE Corner Tract #2 N=4742.11, E=5355.99
SW Corner Tract #2 N=4741.16, E=5195.99

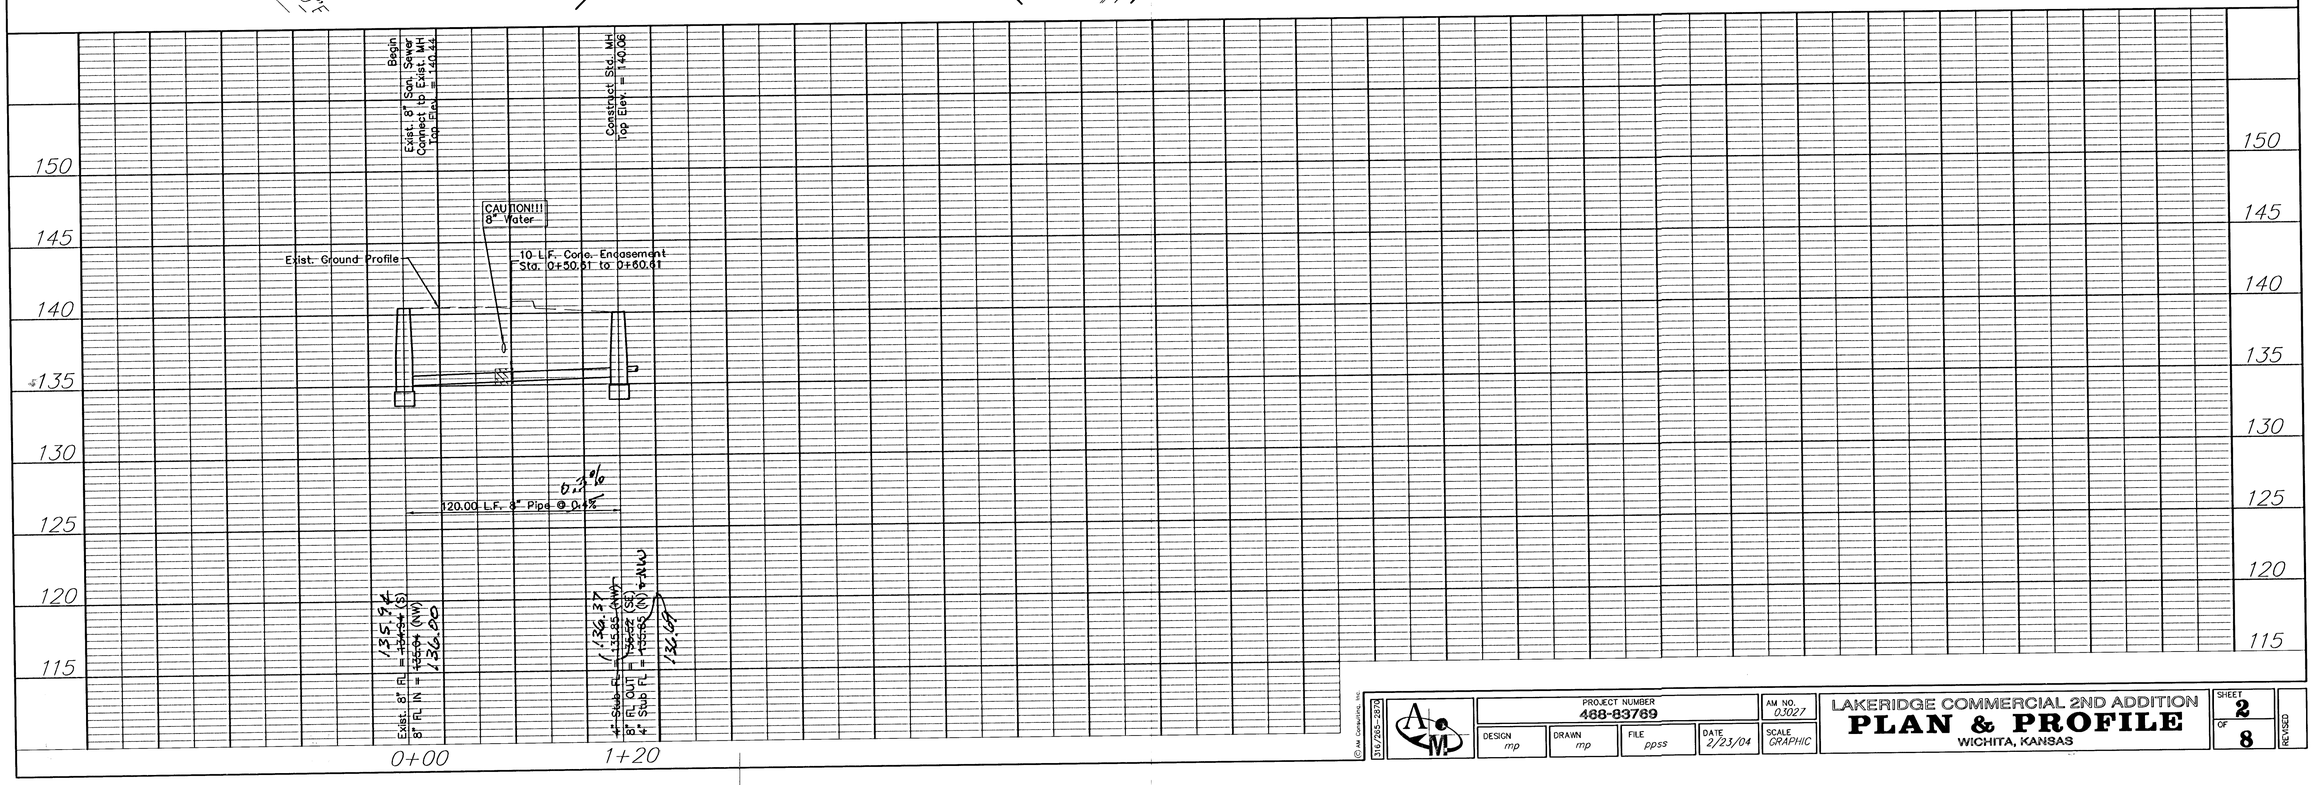

© AM Consultants, Inc.
316/265-2370

PROJECT NUMBER	AM NO.	LAKERIDGE COMMERCIAL 2ND ADDITION	SHEET
488-83789	03027	**PLAN & PROFILE**	2
DESIGN mp / DRAWN mp / FILE ppss	DATE 2/23/04 / SCALE GRAPHIC	WICHITA, KANSAS	OF 8

REVISED