

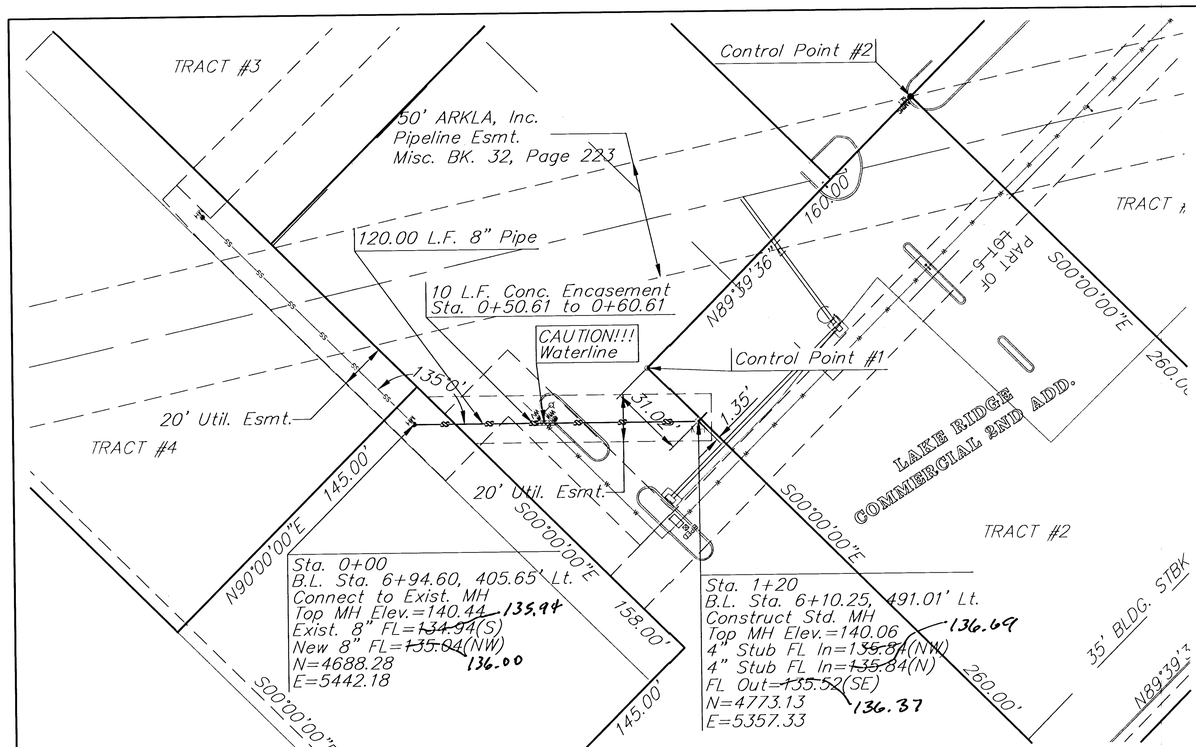


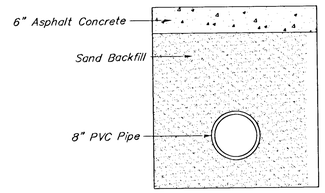

TRENCH DETAIL
NO SCALE

SCALE
30' 0 30' 60'
5' 0 5'

CONTROL POINTS
SE Corner Tract #2 N=4742.11, E=5355.99
SW Corner Tract #2 N=4741.16, E=5195.99

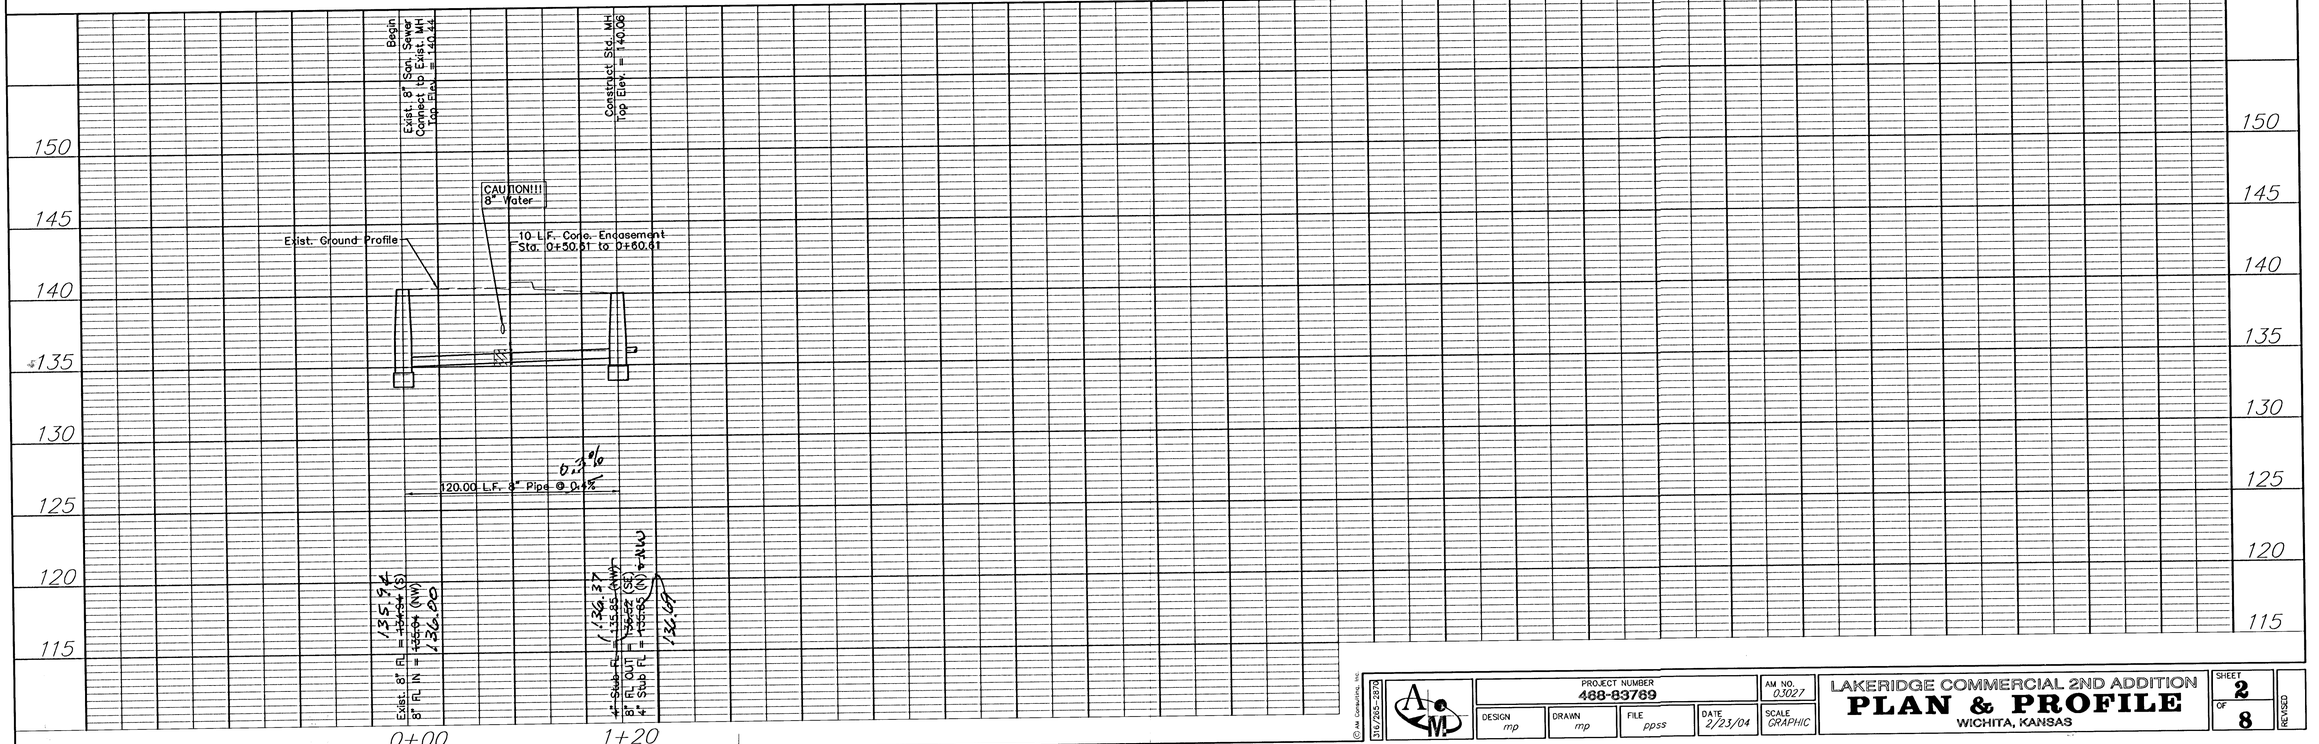

© AM Consultants, Inc.
316/265-2979

PROJECT NUMBER 488-83789				AM. NO. 03027	
DESIGN mp	DRAWN mp	FILE ppss	DATE 2/23/04	SCALE GRAPHIC	

LAKERIDGE COMMERCIAL 2ND ADDITION
PLAN & PROFILE
WICHITA, KANSAS

SHEET 2 OF 8

REVISED