


PLAN LINE 4

SCALE: 1"=40'

REVIS: 1-12-04
Due to gas line location.

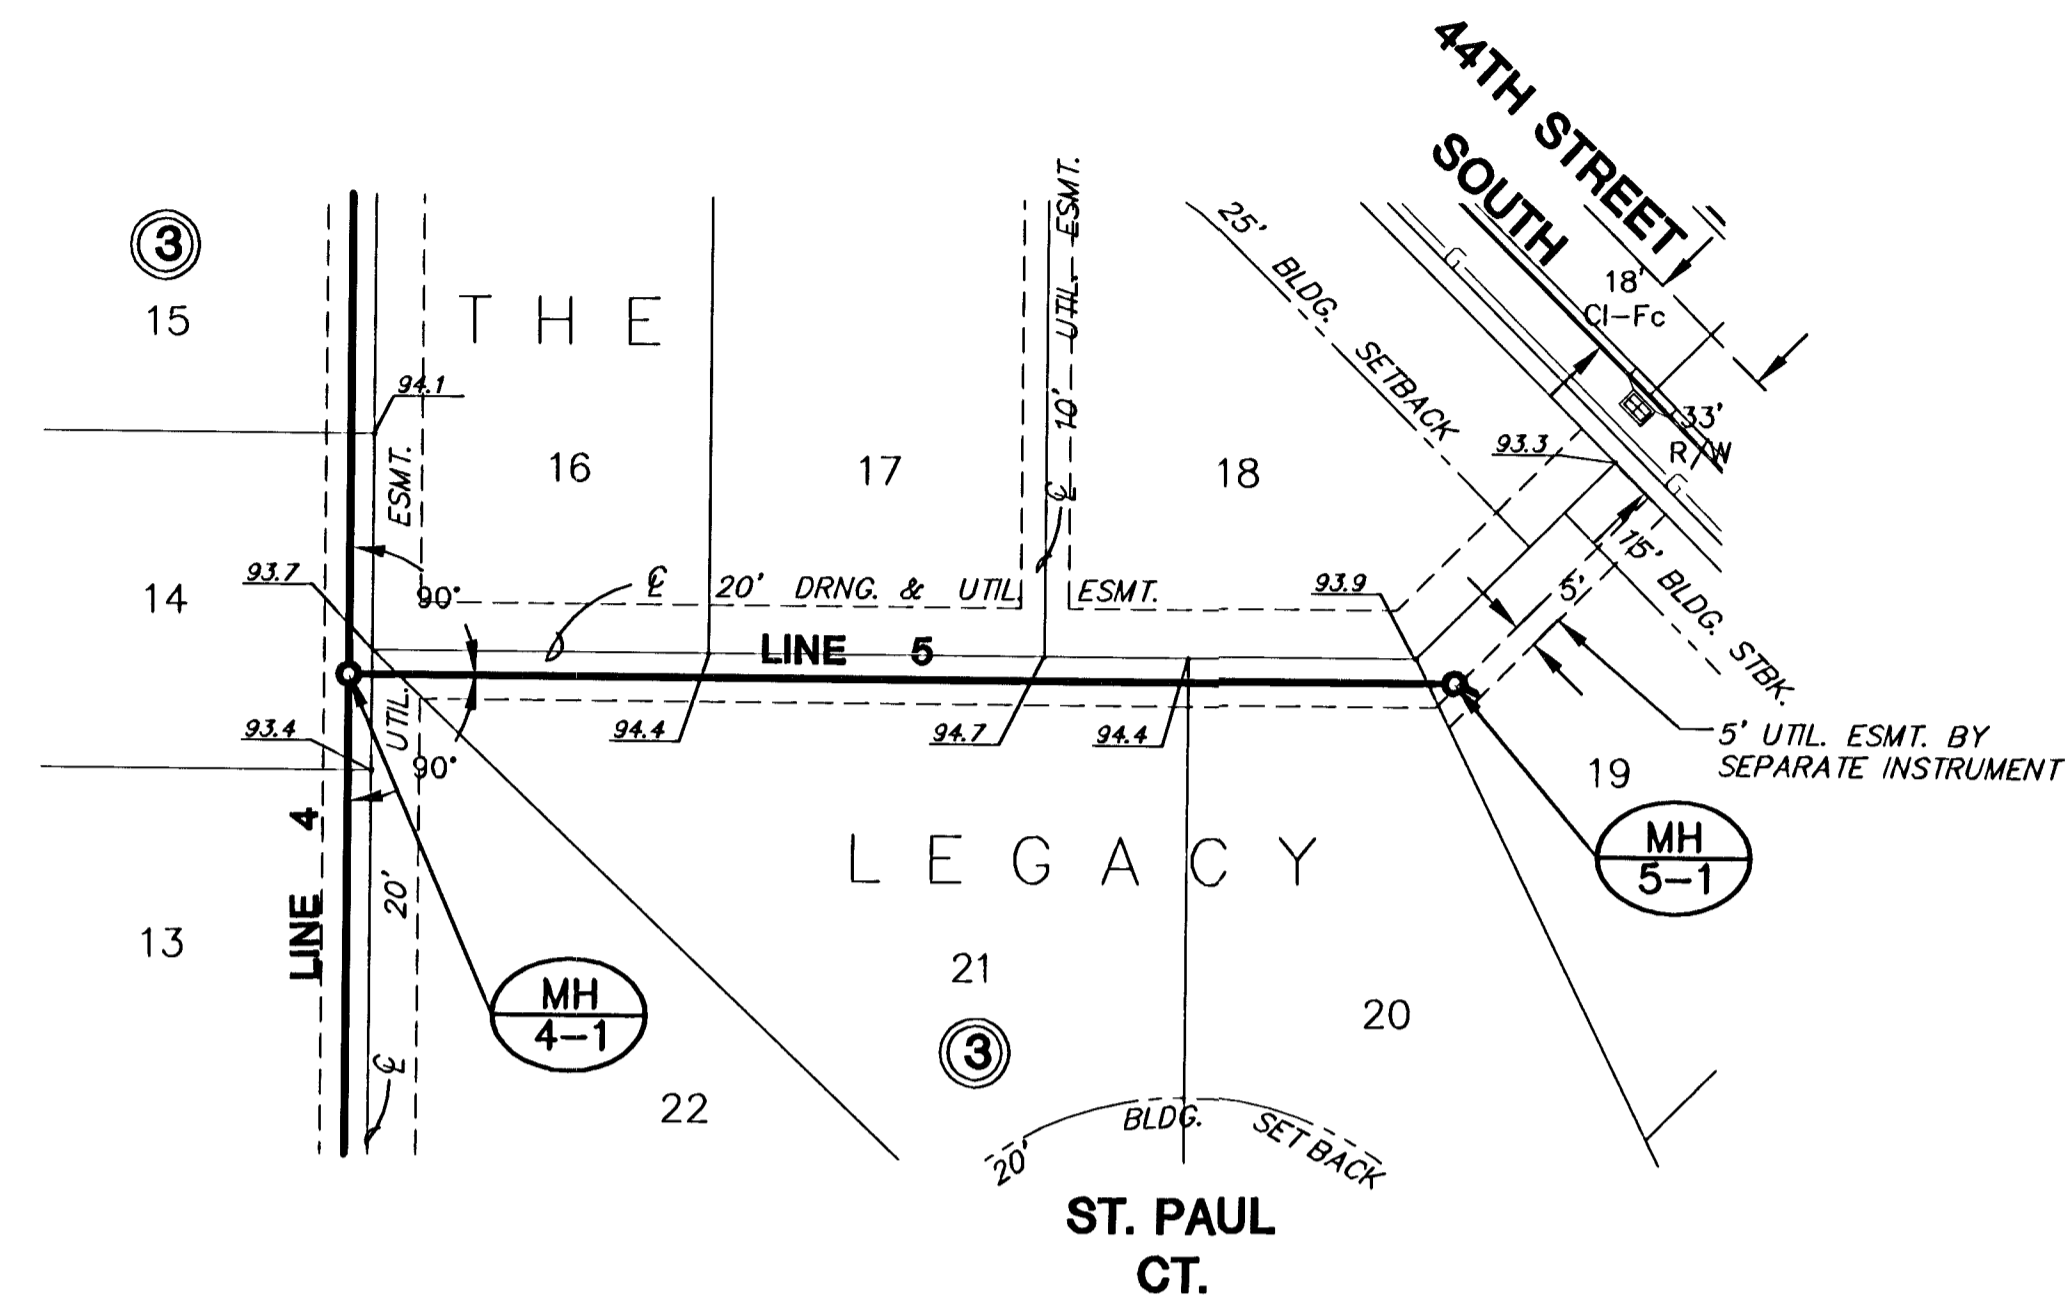


PLAN LINE 5

SCALE: 1"=40'

PROFILE LINE 4

SCALE: HORIZ. 1"=40'
SCALE: VERT. 1"=5'

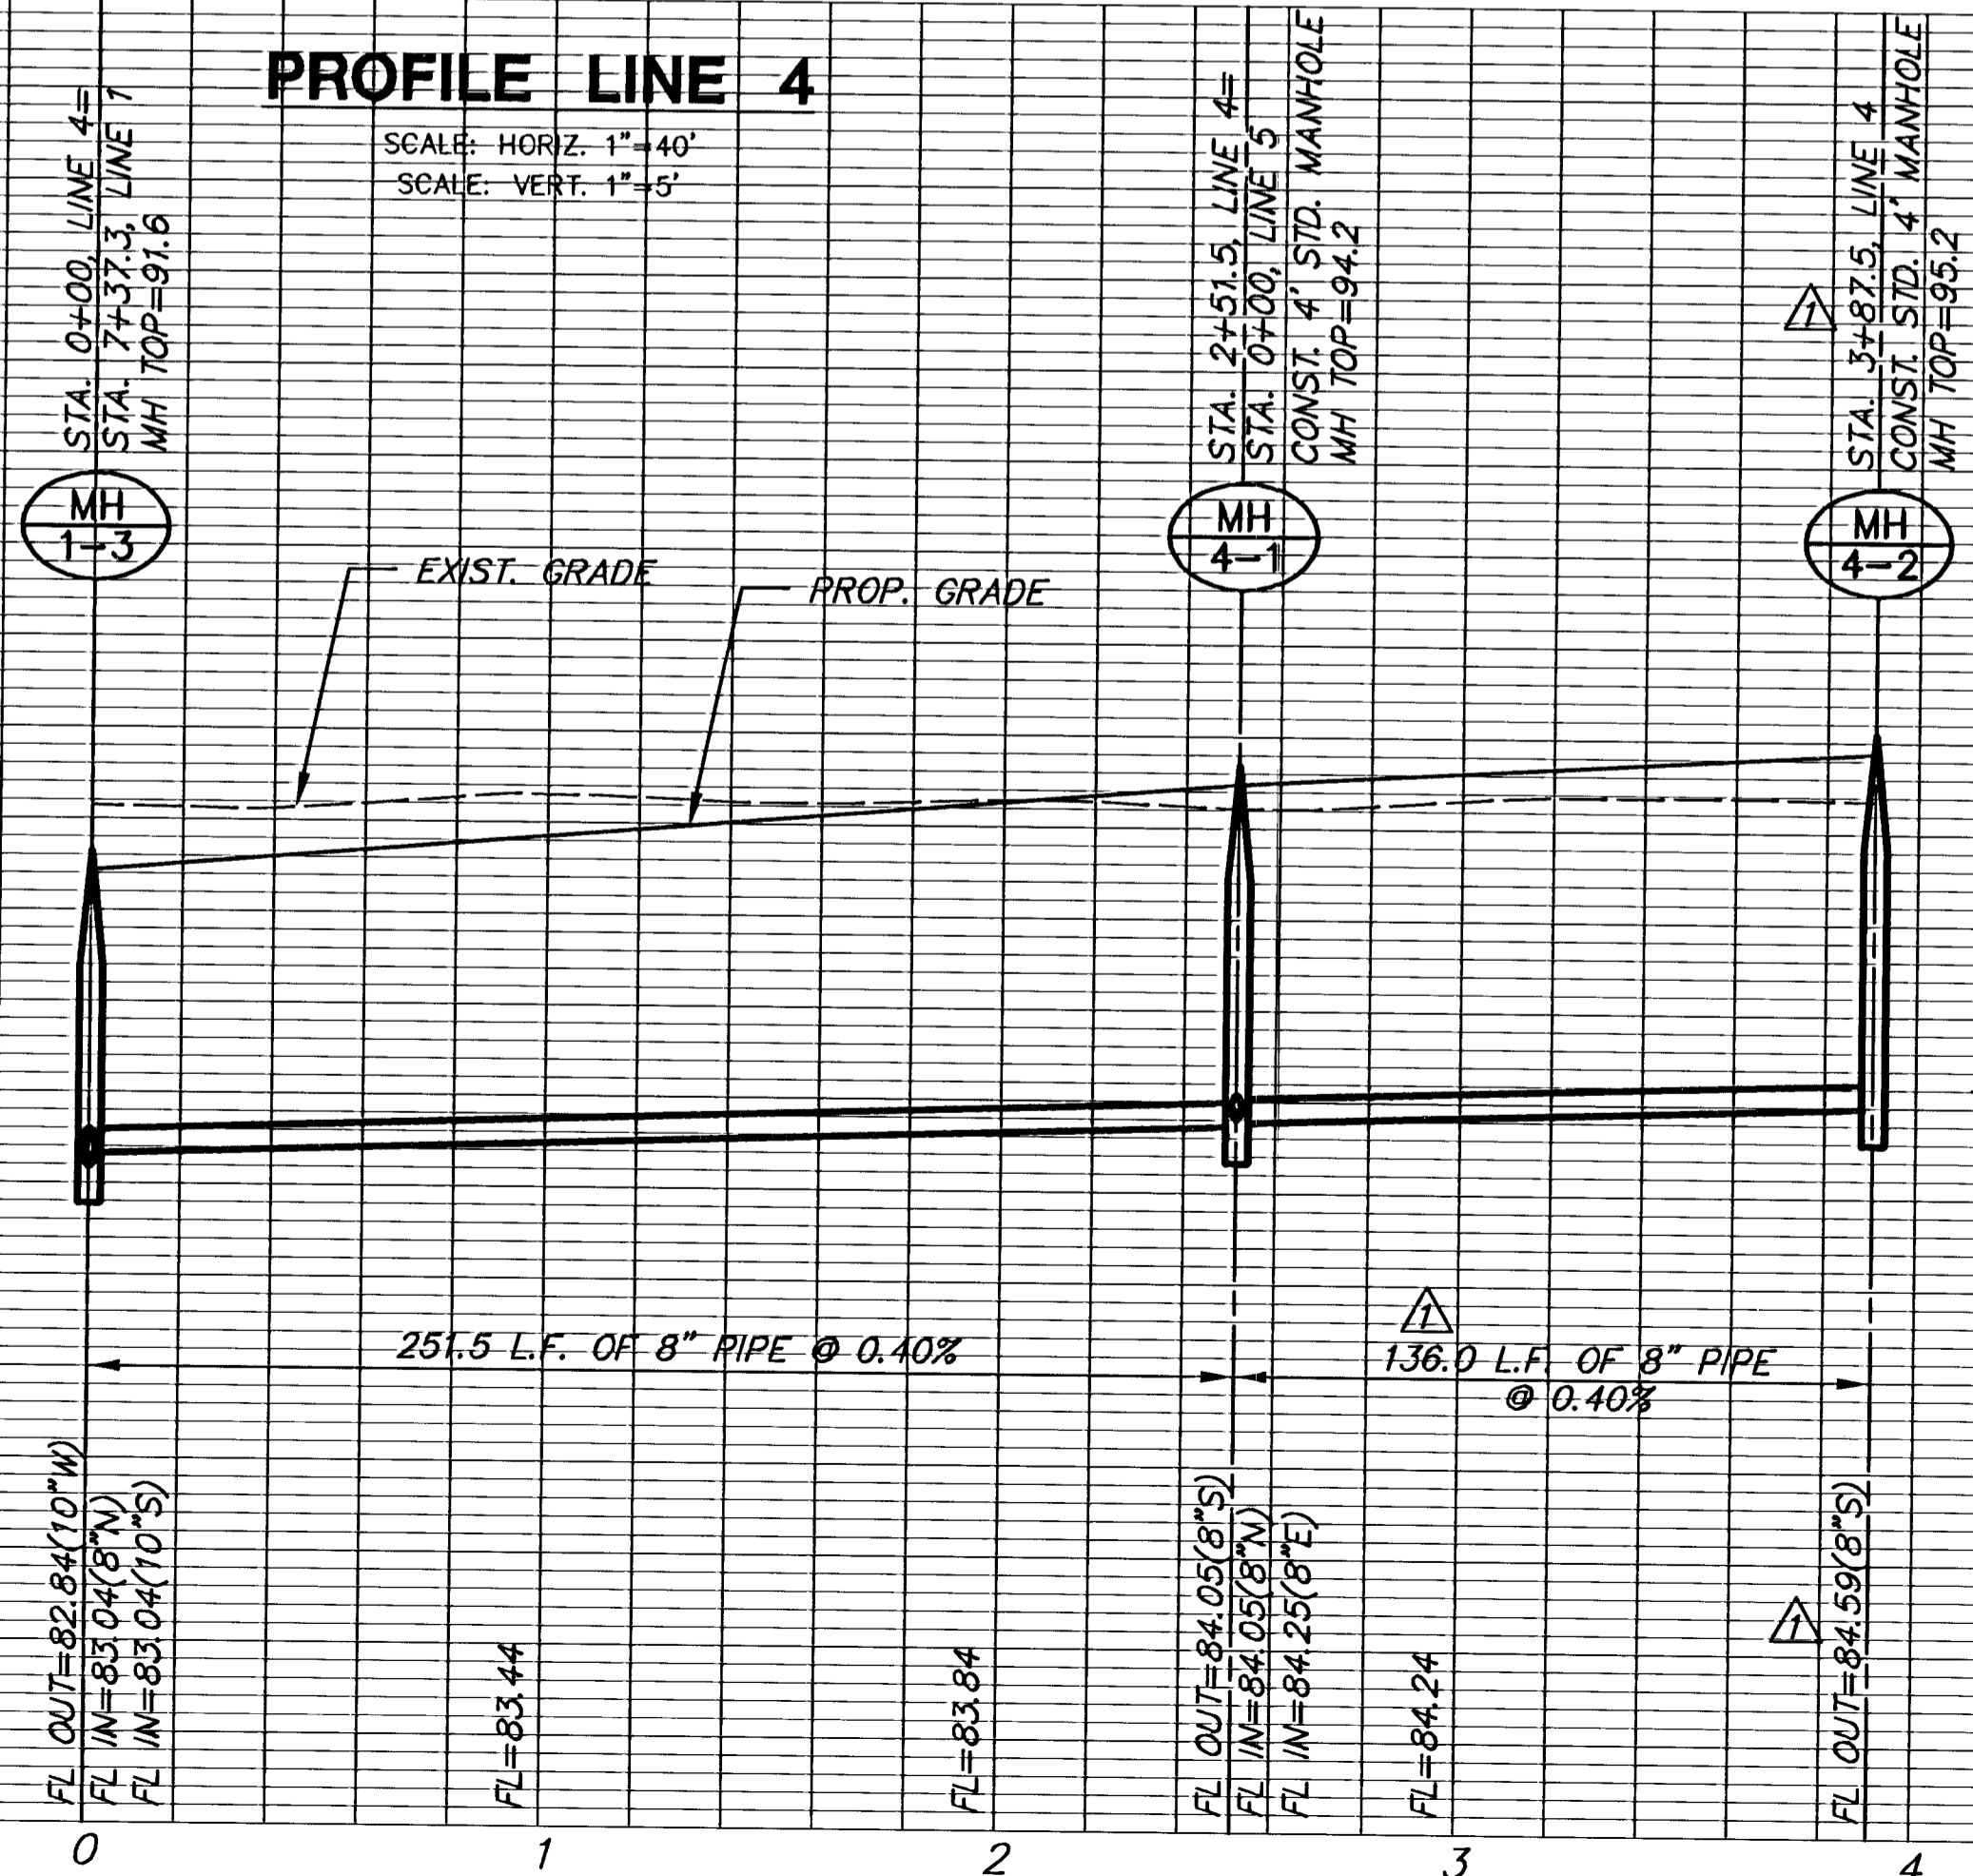

PROFILE LINE 5

SCALE: HORIZ. 1"=40'
SCALE: VERT. 1"=5'

