

PLAN LINE 6


SCALE: 1"=40'

PLAN LINE 7

SCALE: 1"=40'


PROFILE LINE 6

SCALE: HORIZ. 1"=40'
SCALE: VERT. 1"=5'

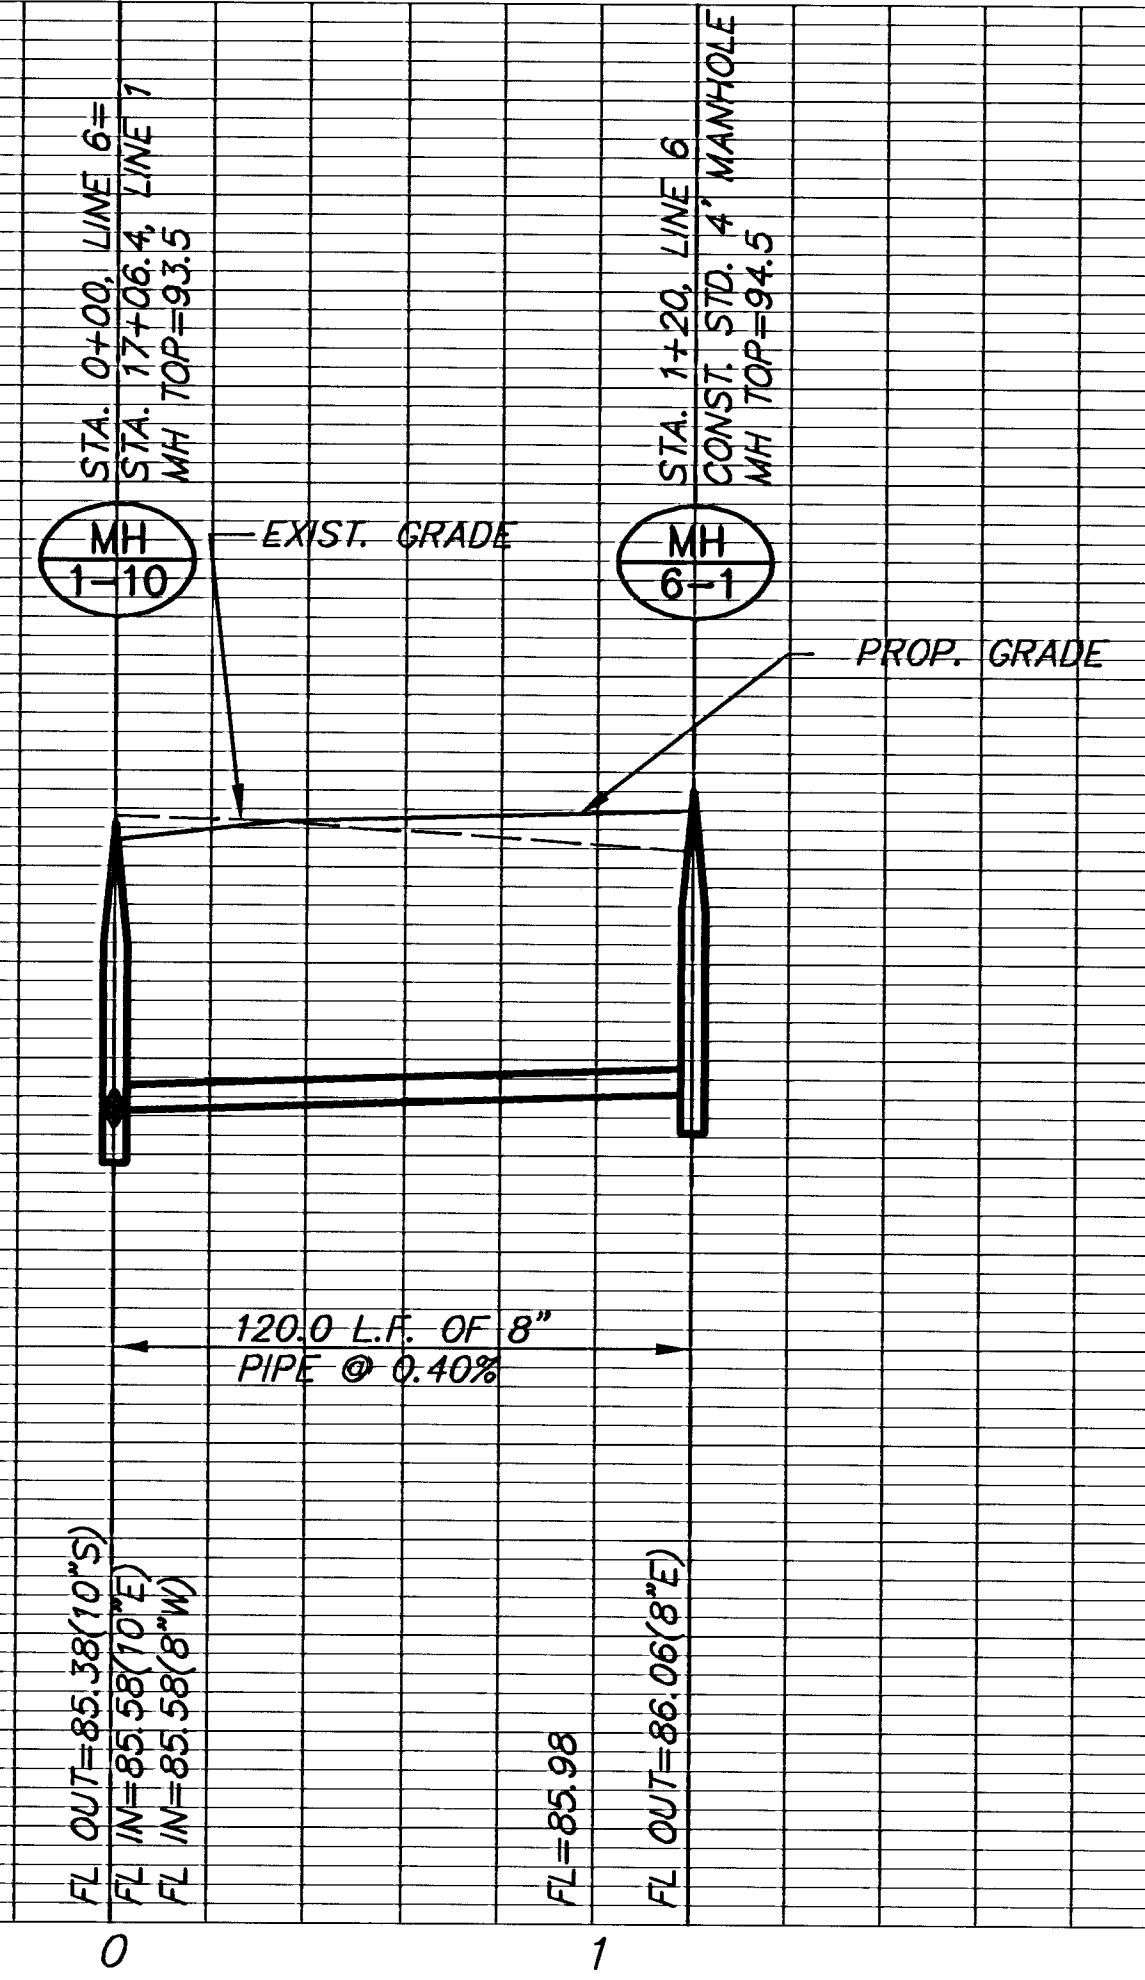

PROFILE LINE 7

SCALE: HORIZ. 1"=40'
SCALE: VERT. 1"=5'

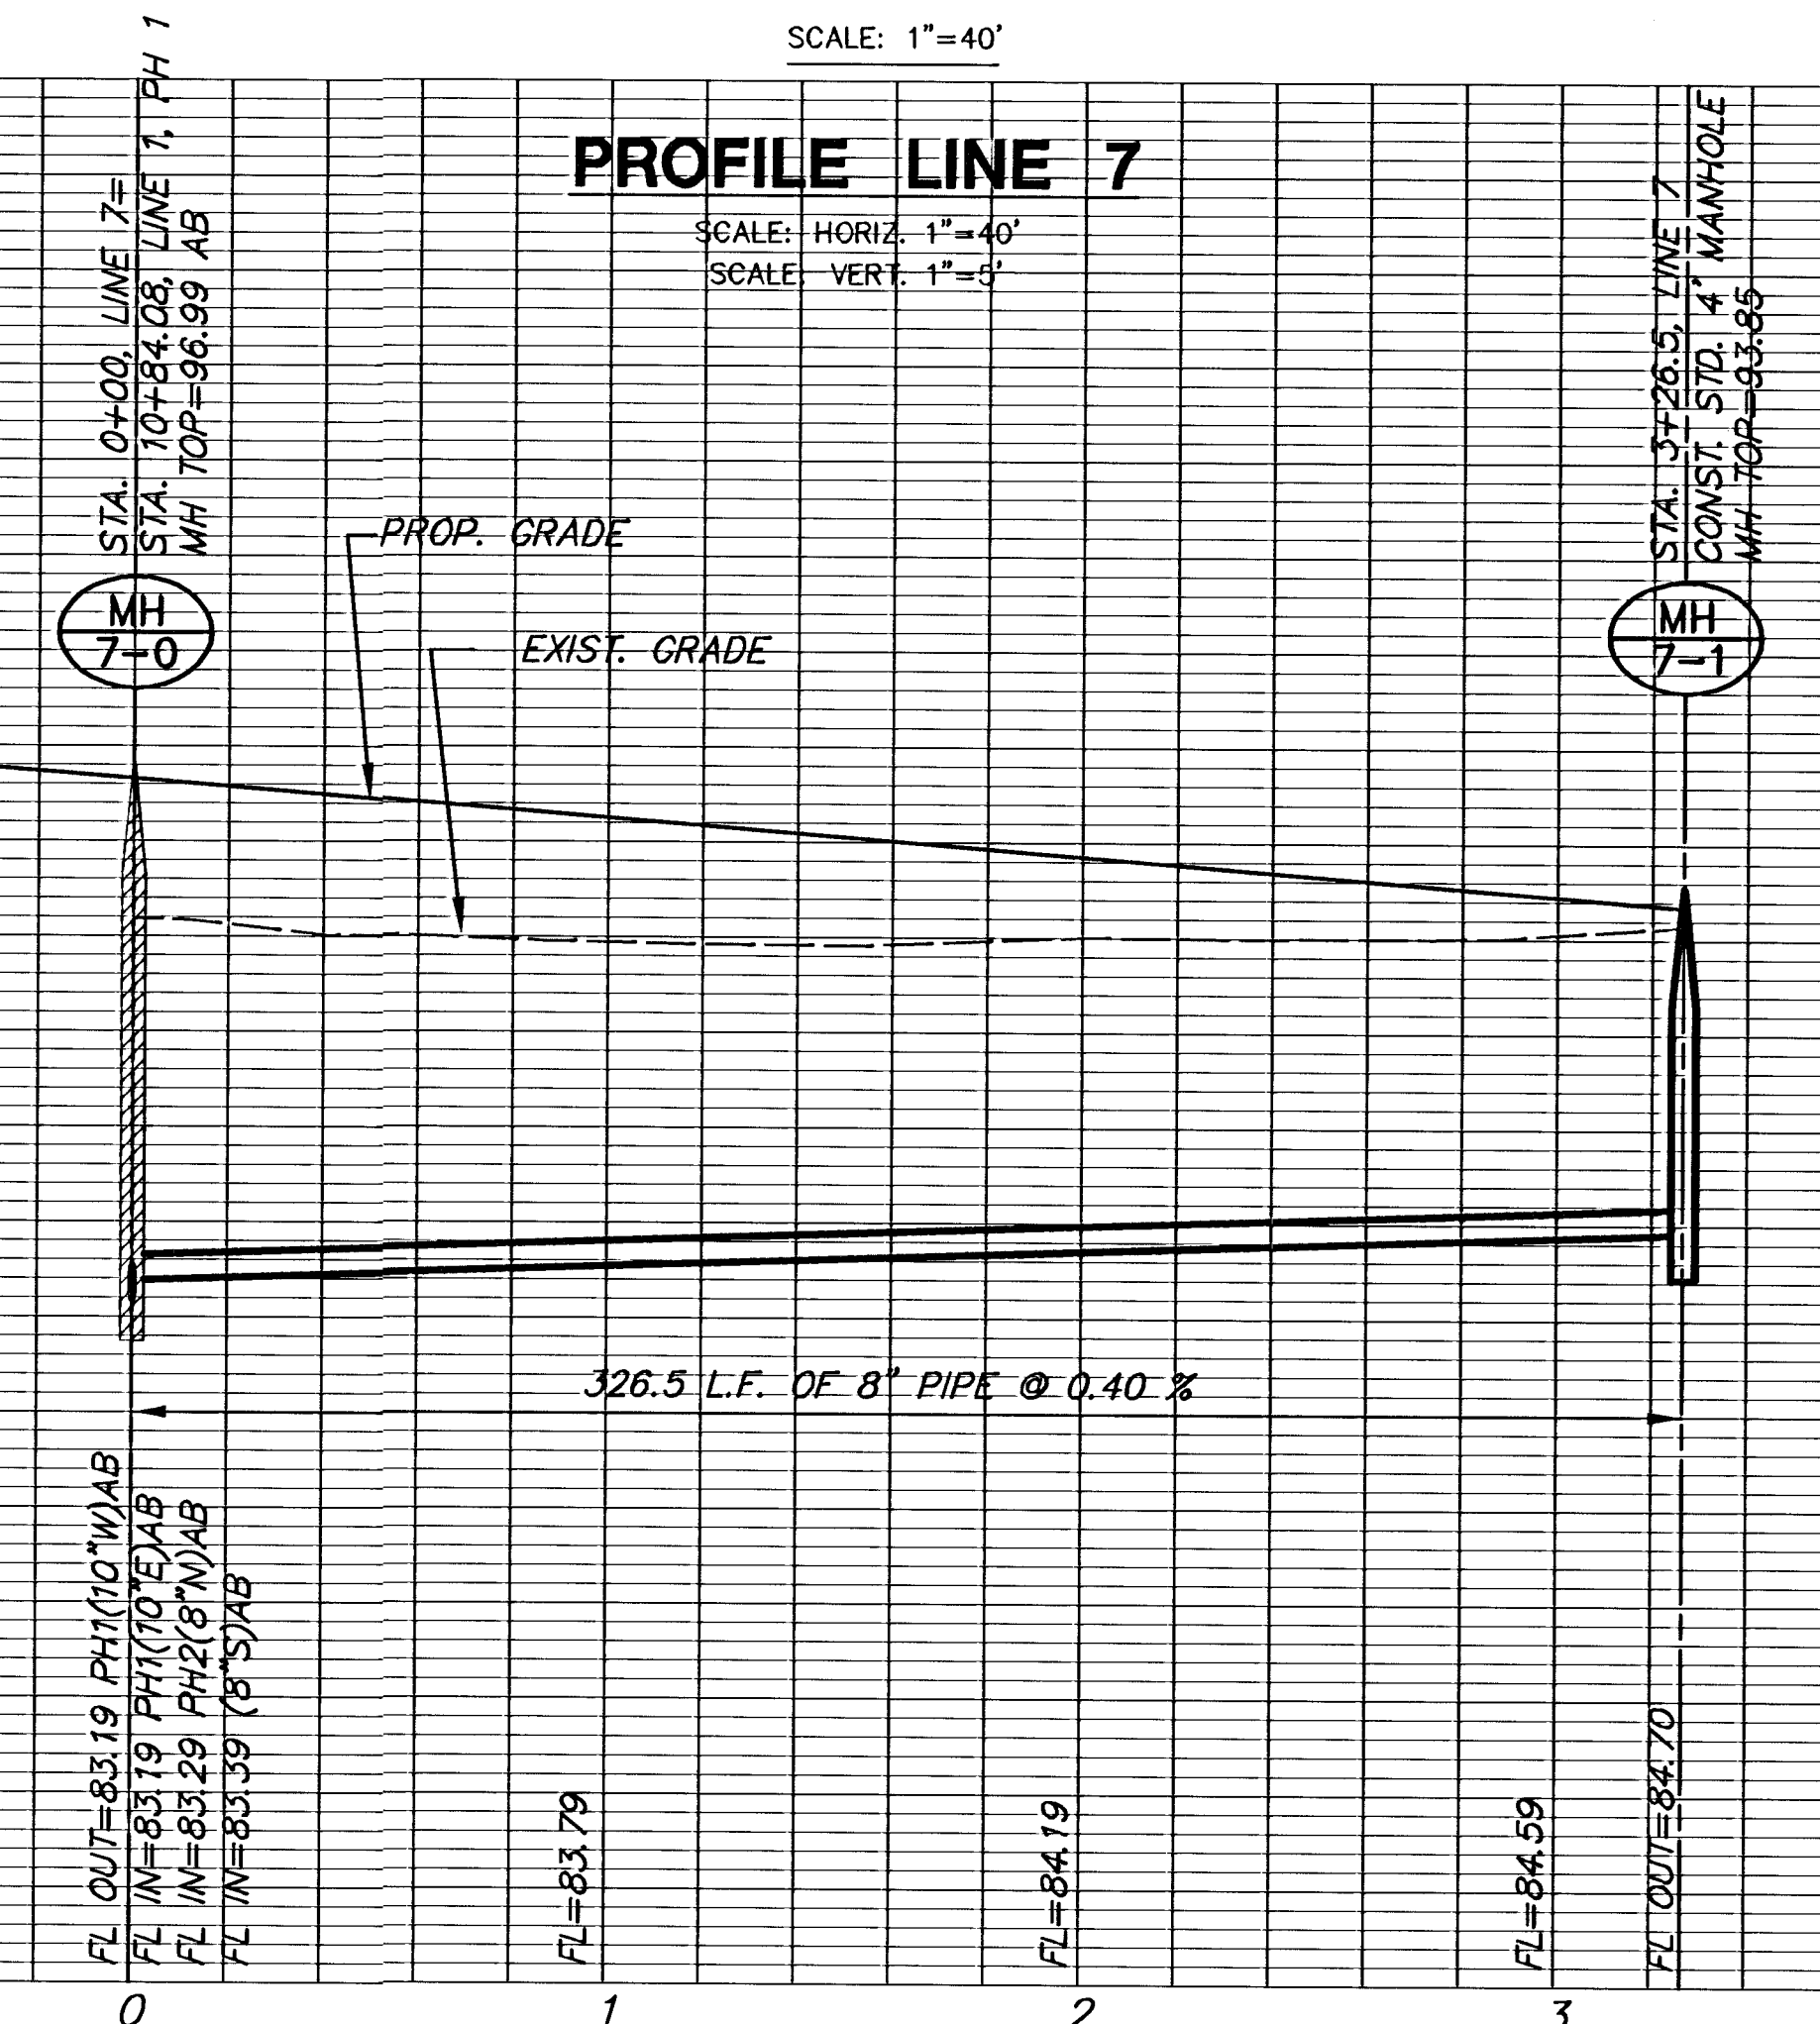

C:\CML\95138\SAN\PHASE3\1326485.DWG