
GRAPHIC SCALE

20 0 10 20 40

(IN FEET)

1 INCH = 20 FT.

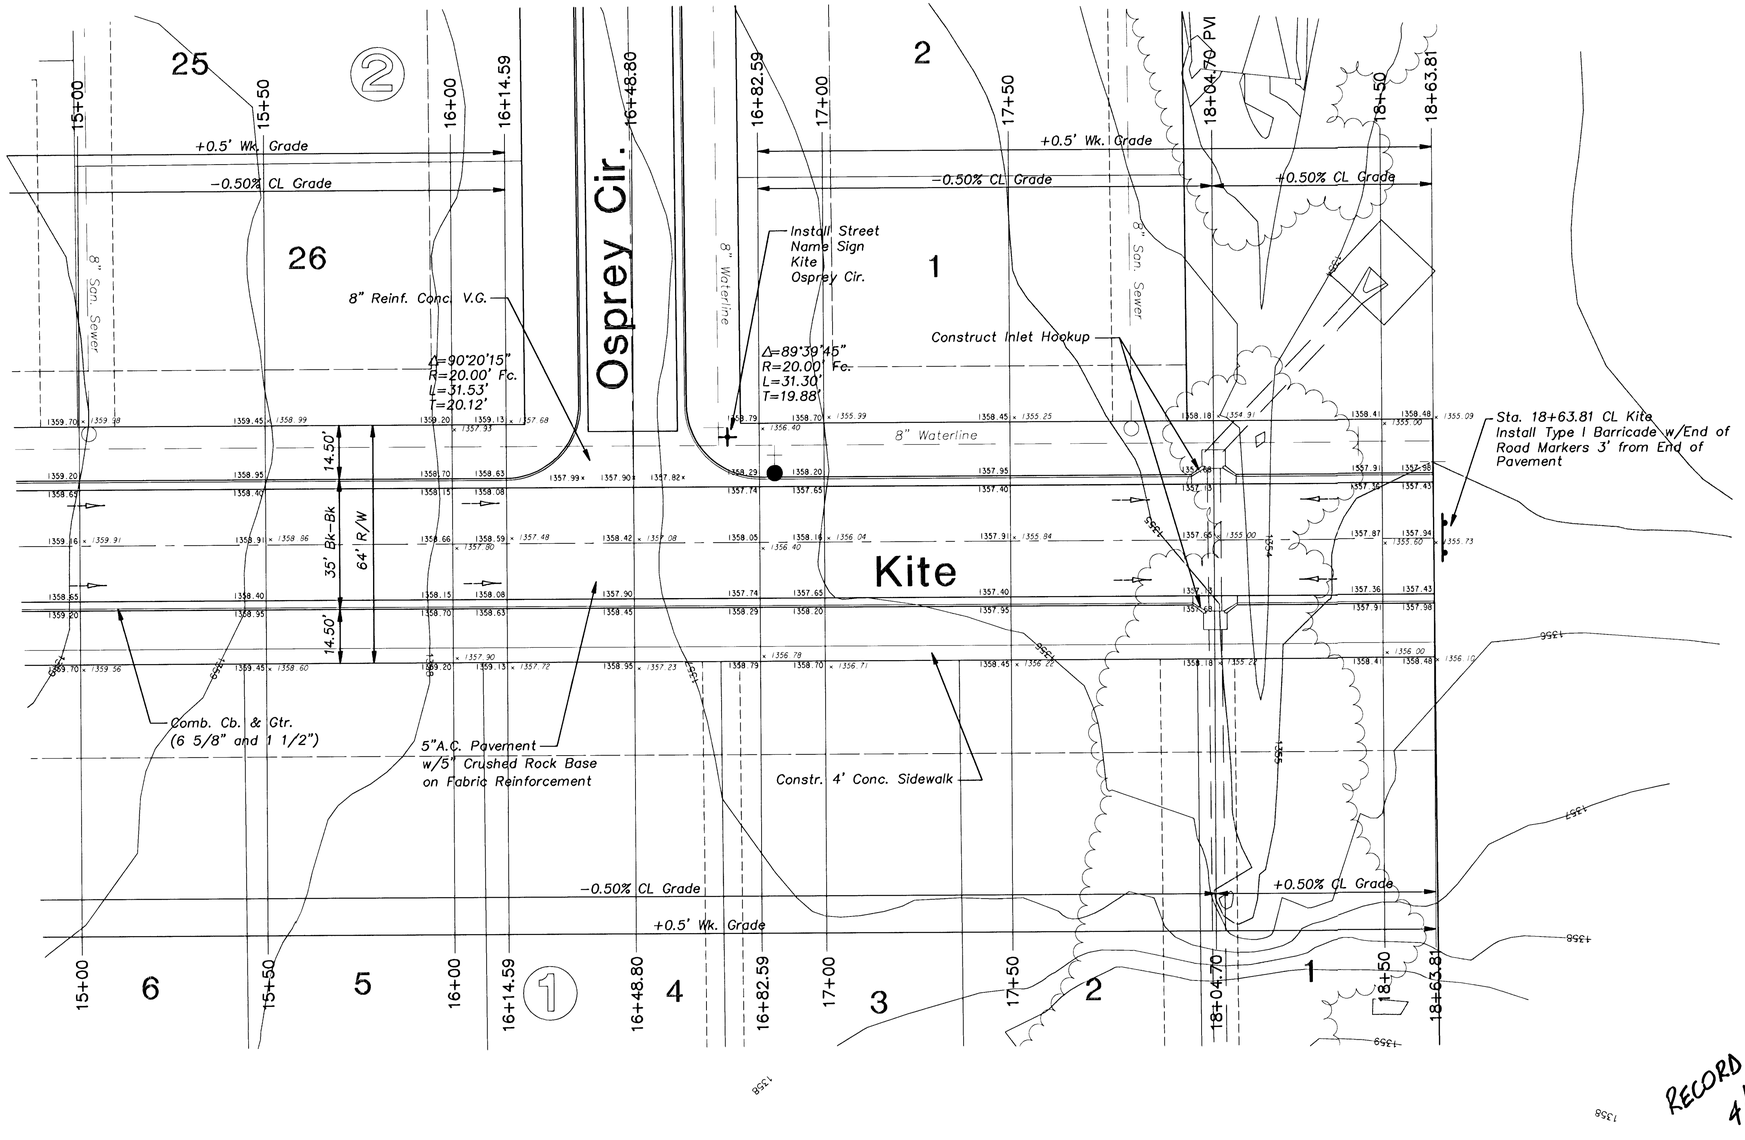

No.	Street and Station	From CL	Description	Elevation
3	Peregrine, 16+86.65	17.50' S.	Top of Curb (S), in front of Fire Hydrant, at Northeast corner of Lot 1, Block 2	1358.36

RECORD DRAWINGS
4/4/04
J.U./B.K.

FALCON FALLS - PHASE 1
STREET IMPROVEMENTS
KITE

CITY OF WICHITA, KANSAS
NEIL D. CABLE, P.E. - CITY ENGINEER
C.O.W. Project # 472-83687 O.C.A. # 765782

No.	Date	By	Approved	Revision

POE & ASSOCIATES OF KANSAS, INC.
CONSULTING ENGINEERS
6340 E. Central, Suite 200 ■ Wichita, KS 67208-4242
Phone 316/685-4114 ■ FAX 316/685-4444

FINAL

Designed By: J. Ubert / B. Kulla
Drawn By: B. Kulla
Poe Job No.: 1748A
Date: May 2003

Sheet 7 of 88

G:\APPS\DOCA\P\1748\base.dwg Mon Apr 05 11:55:15 2004 Bernard Kulla, Poe & Associates Inc.