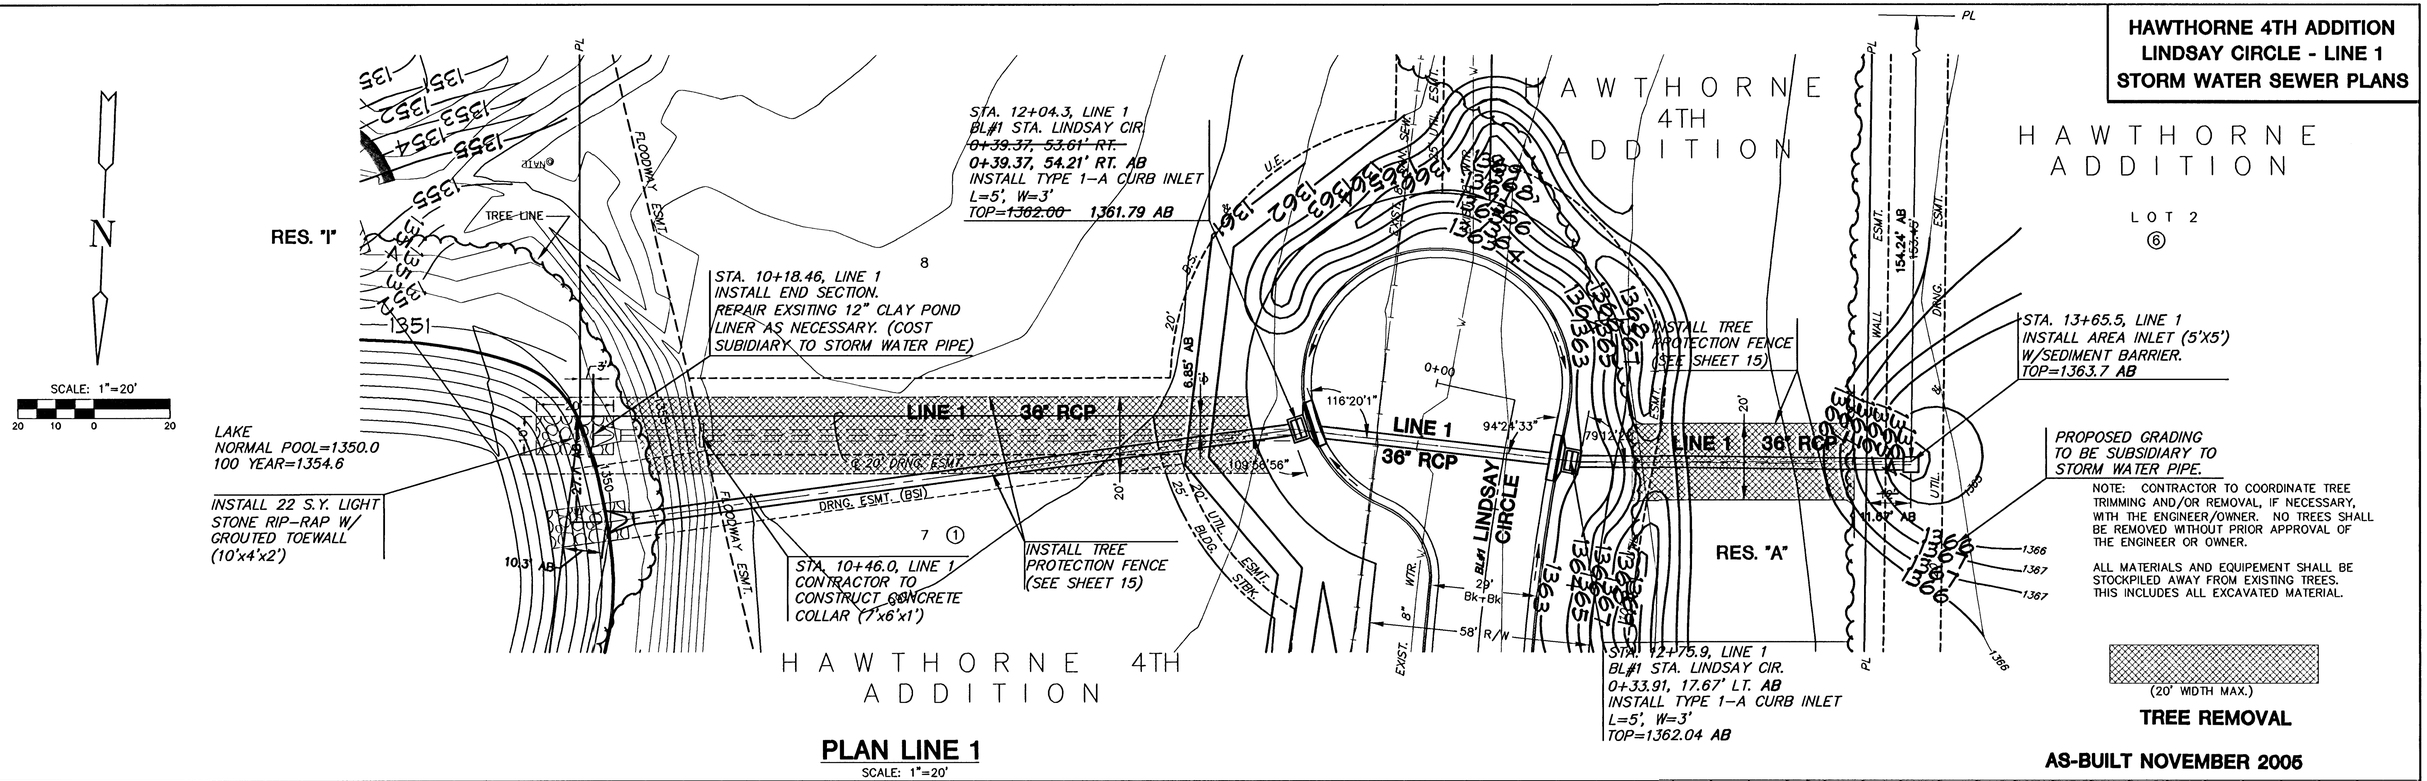
**HAWTHORNE 4TH ADDITION**
**LINDSAY CIRCLE - LINE 1**
**STORM WATER SEWER PLANS**



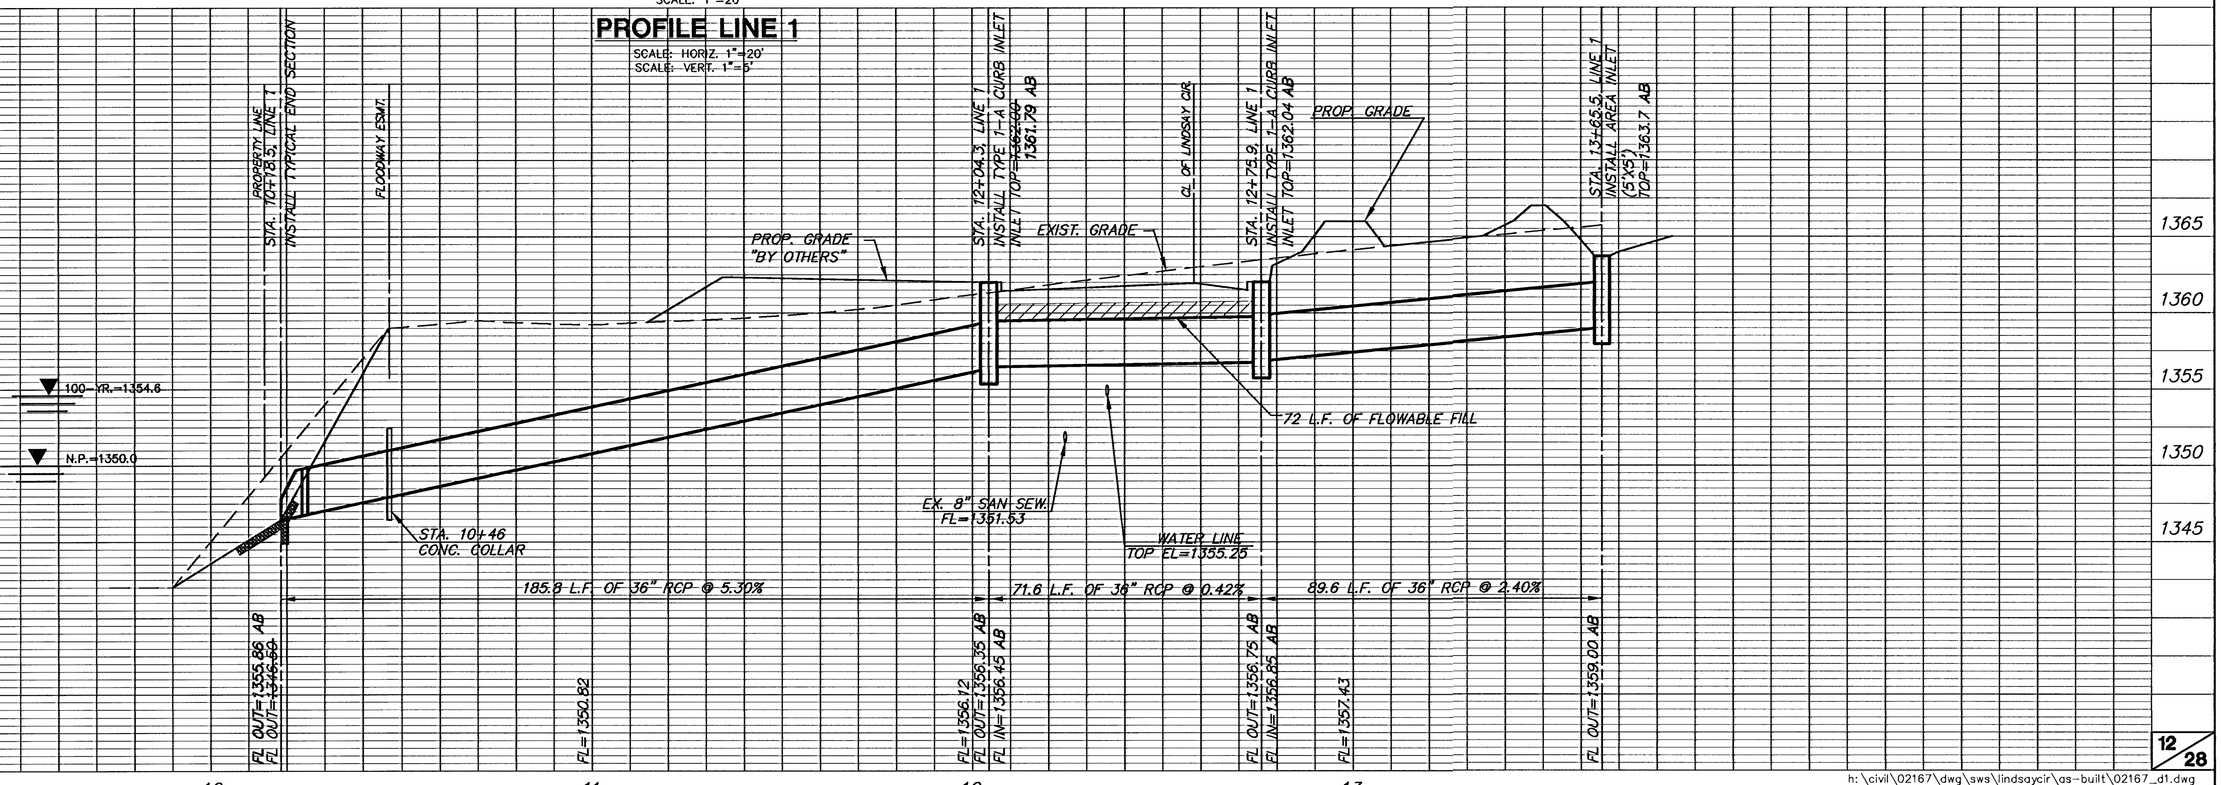

## PLAN LINE 1

SCALE: 1"=20'

**AS-BUILT NOVEMBER 2005**

## PROFILE LINE 1

SCALE: HORZ. 1"=20'
SCALE: VERT. 1"=5'






h:\civil\02167\dwg\sws\lindsaycir\as-built\02167_d1.dwg

**REVISED 10-18-04 (RAISE PIPE)**