

Mayfield
1st Add.

* Concrete Header

Roll-Type Monolithic
Edge Curb

57.00
50' R/W

52.00

40' Bk-Bk

35' R/W

1/2 IP

8" A.C. Water Main

1296.69

1296.53TC
1296.52TC

1296.53TC
1296.28FL

1296.37TC
1296.12FL

1296.50TC
1296.00FL

* HANDformed Roll-type curb & gutter

Roll-Type Combine
Curb & Gutter.

Taper from 6"
to 3" Curb

Standard Valley Gutter

10+00

EX. 1296.00TC
EX. 1295.42FL

May St.

Ex. Asphalt
Pavt.

4'
Bk-Bk

Private Drive

9+00

Asphalt Pavt.
By Others

1297.07

100.00
1296.92

Remove Fence

Taper from 6"
to 3" Curb

6" High Curb
and Gutter

69.94' M

1296.69

1296.53TC
1296.28FL

1296.48TC
1296.23FL

1296.50TC
1296.00FL

8" Conc. Drive
Pavement

35' R/W

1/2 IP

Roll-Type Monolithic
Edge Curb

* Concrete Header

50' R/W
57.00

8" Conc. Drive
Pavement

* Changes approved by Vicki Huang

1296.28

1296.38

1296.58

WL By Others


35' Drng. Esmt.

Drainage Ditch

Benchmark:
BM 1 Temporary bench mark.
SE corner of intersection of West St.
and May St. Box cut in NE corner of
concrete base of sign "May Central Park"
Elev.=111.67

BM 2 COW Bench mark. NW
corner of intersection of West St.
and May St. 65' W of centerline
of West St. 50' N of centerline of
May. 28.8' N of center of median.
14.4' W of west face of sidewalk.
2.5' N of back of curb. 2.2' W of
west face of SWS inlet.
Elev.=108.63

Baseline:
10+00 at the Property
Corner of Tracy and May.

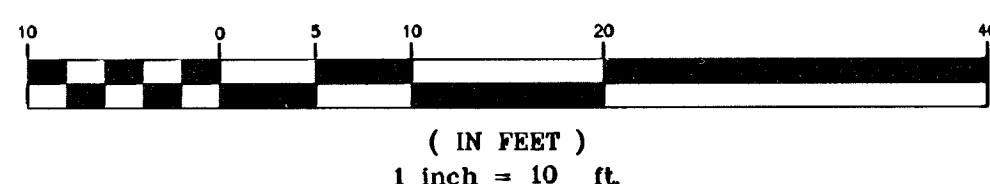

Lot 1

1

Street Improvements May Street Wichita, KS				
PROJECT NUMBER				
kemiller engineering	DESIGN	DRAWN	DATE	SHEET
	KM	JO	10/2006	2 OF 5
516 S. Market, Wichita, KS 67202		316/264-0242		