

Benchmark:
 "□" on TC North end of Harry Court between center and East Inlets
 Elev. = 106.06 (City Datum)


Vert. Scale (IN FEET)
 1 inch = 5 ft

(IN FEET)
 1 inch = 20 ft

110.00' 103.39' 127.23' 126.58' 104.30' 110.00' 100' 100' 110' 120' 

330.44' (p) 330.44' (m)

100'06'20"W 100'09'06"W

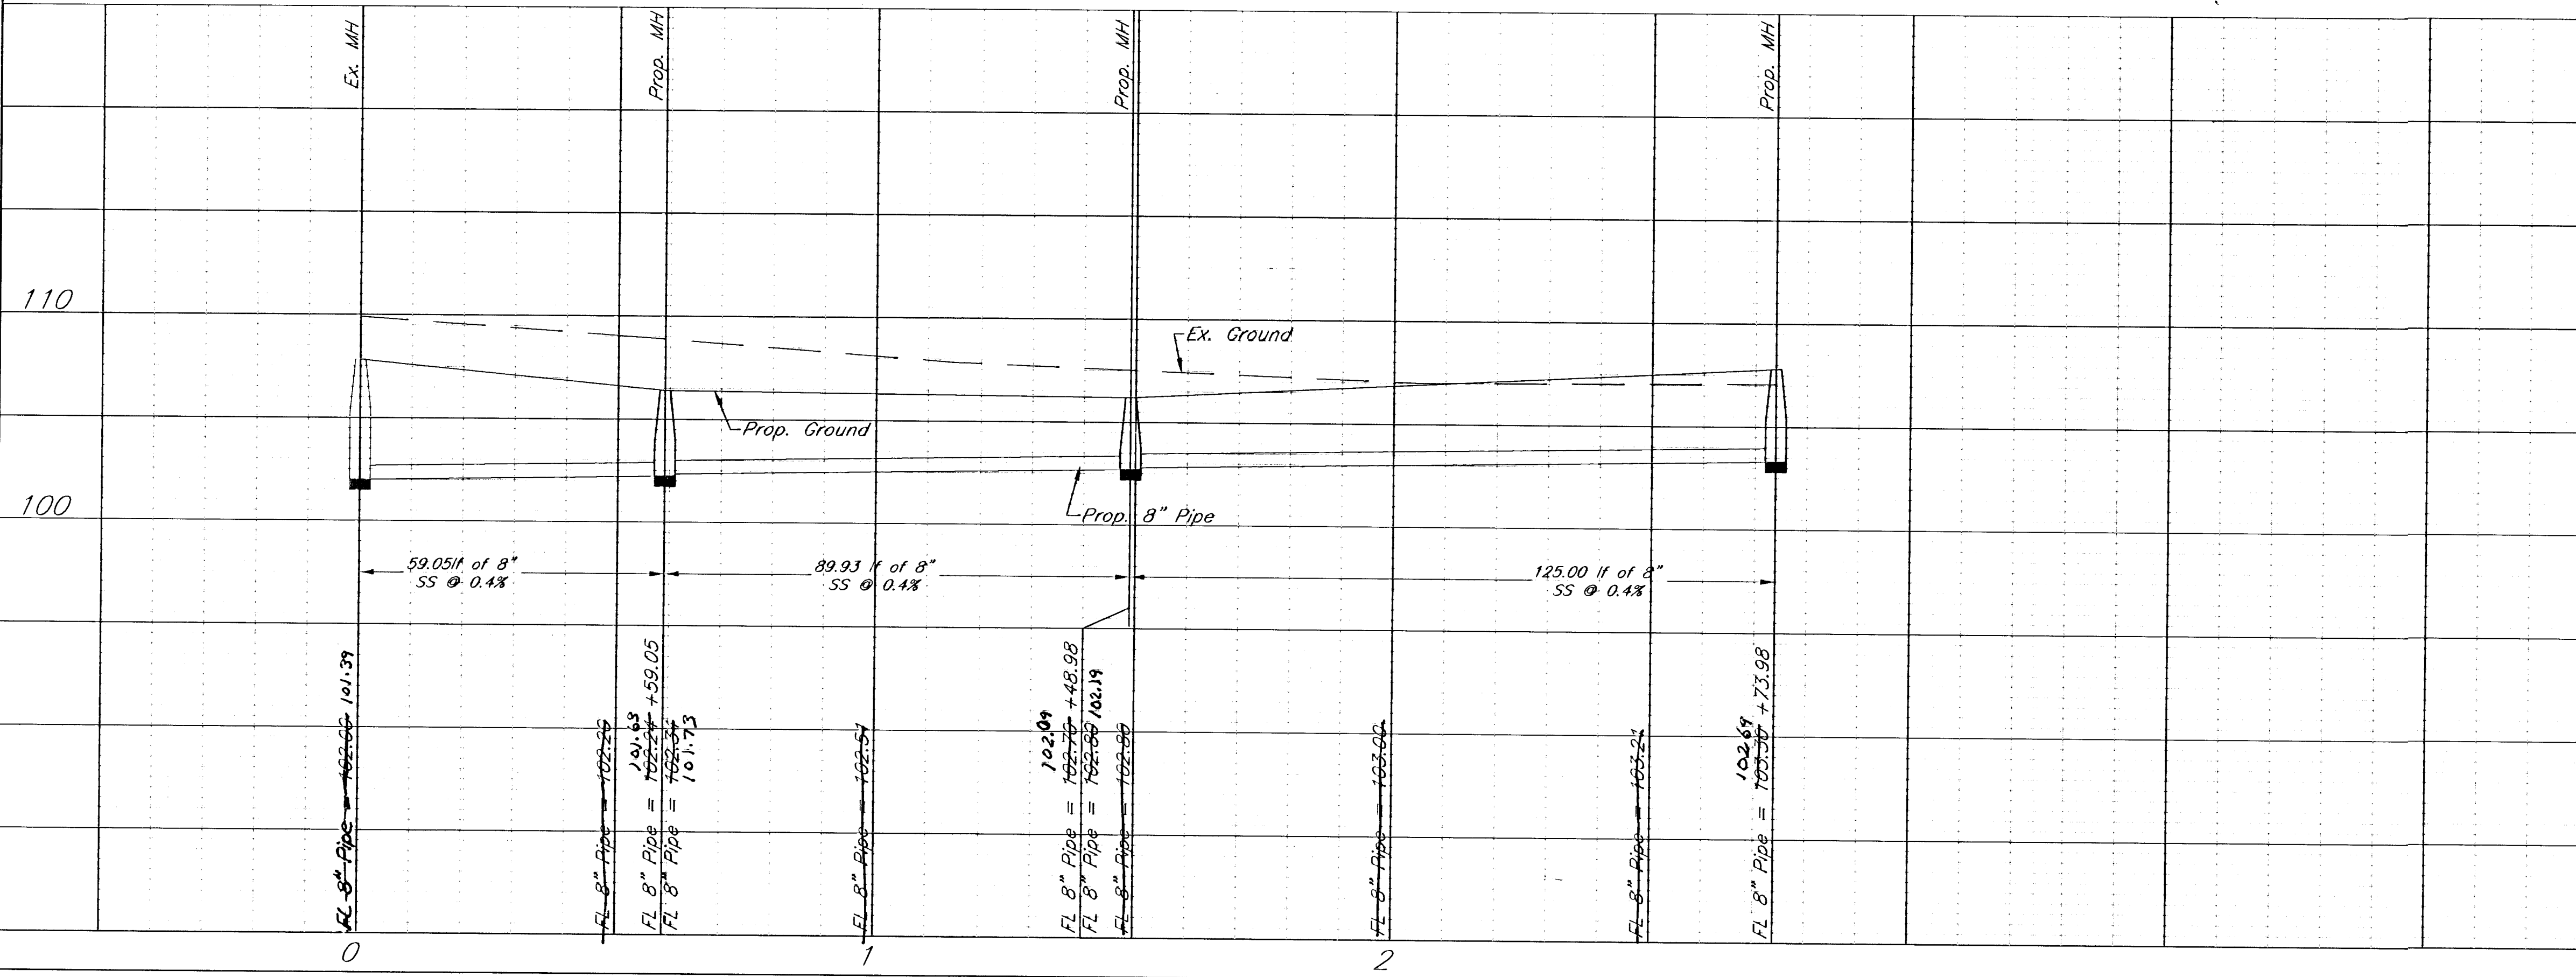

Sanitary Sewer to Serve
Sante Fe Orient Industrial Park
 Wichita, Kansas

PROJECT NUMBER

	KEM NO. 06002	FILE sanitary sewer	DATE 5/2006	SHEET 2
	DESIGN PB	DRAWN JO	REVISED 6/2006	OF 3

516 S. Market, Wichita, KS 67202 316/264-0242