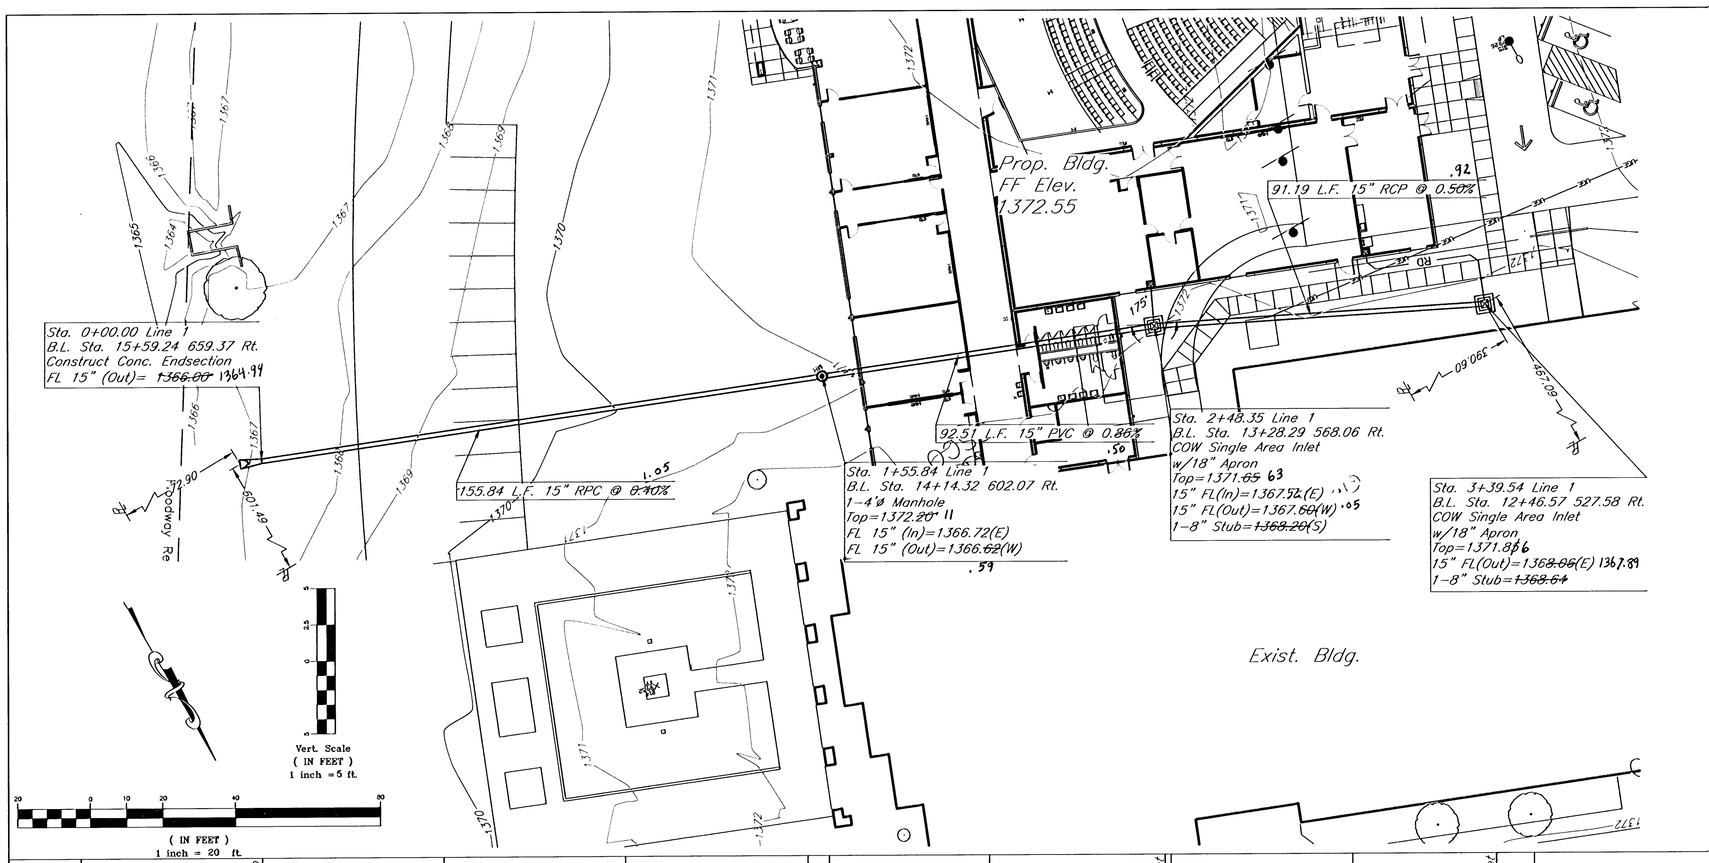

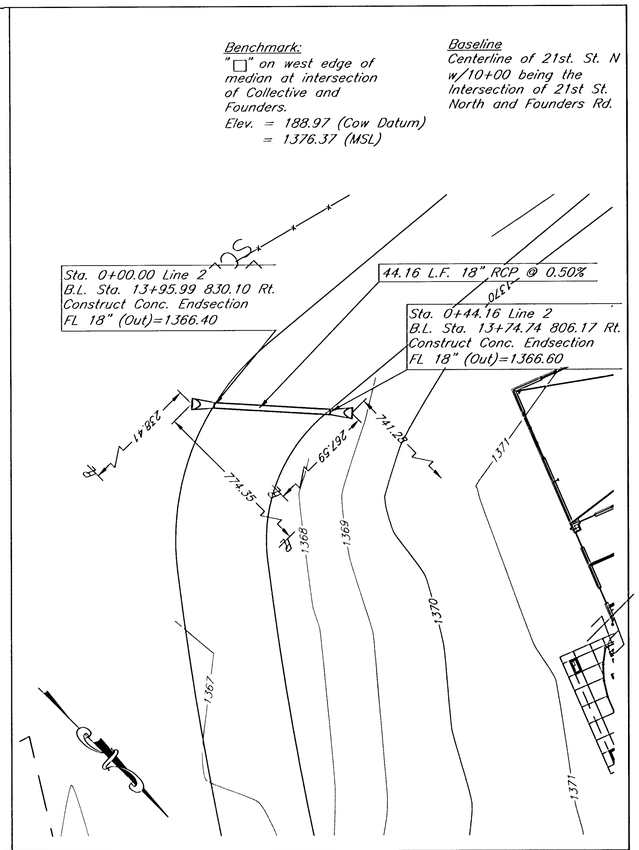

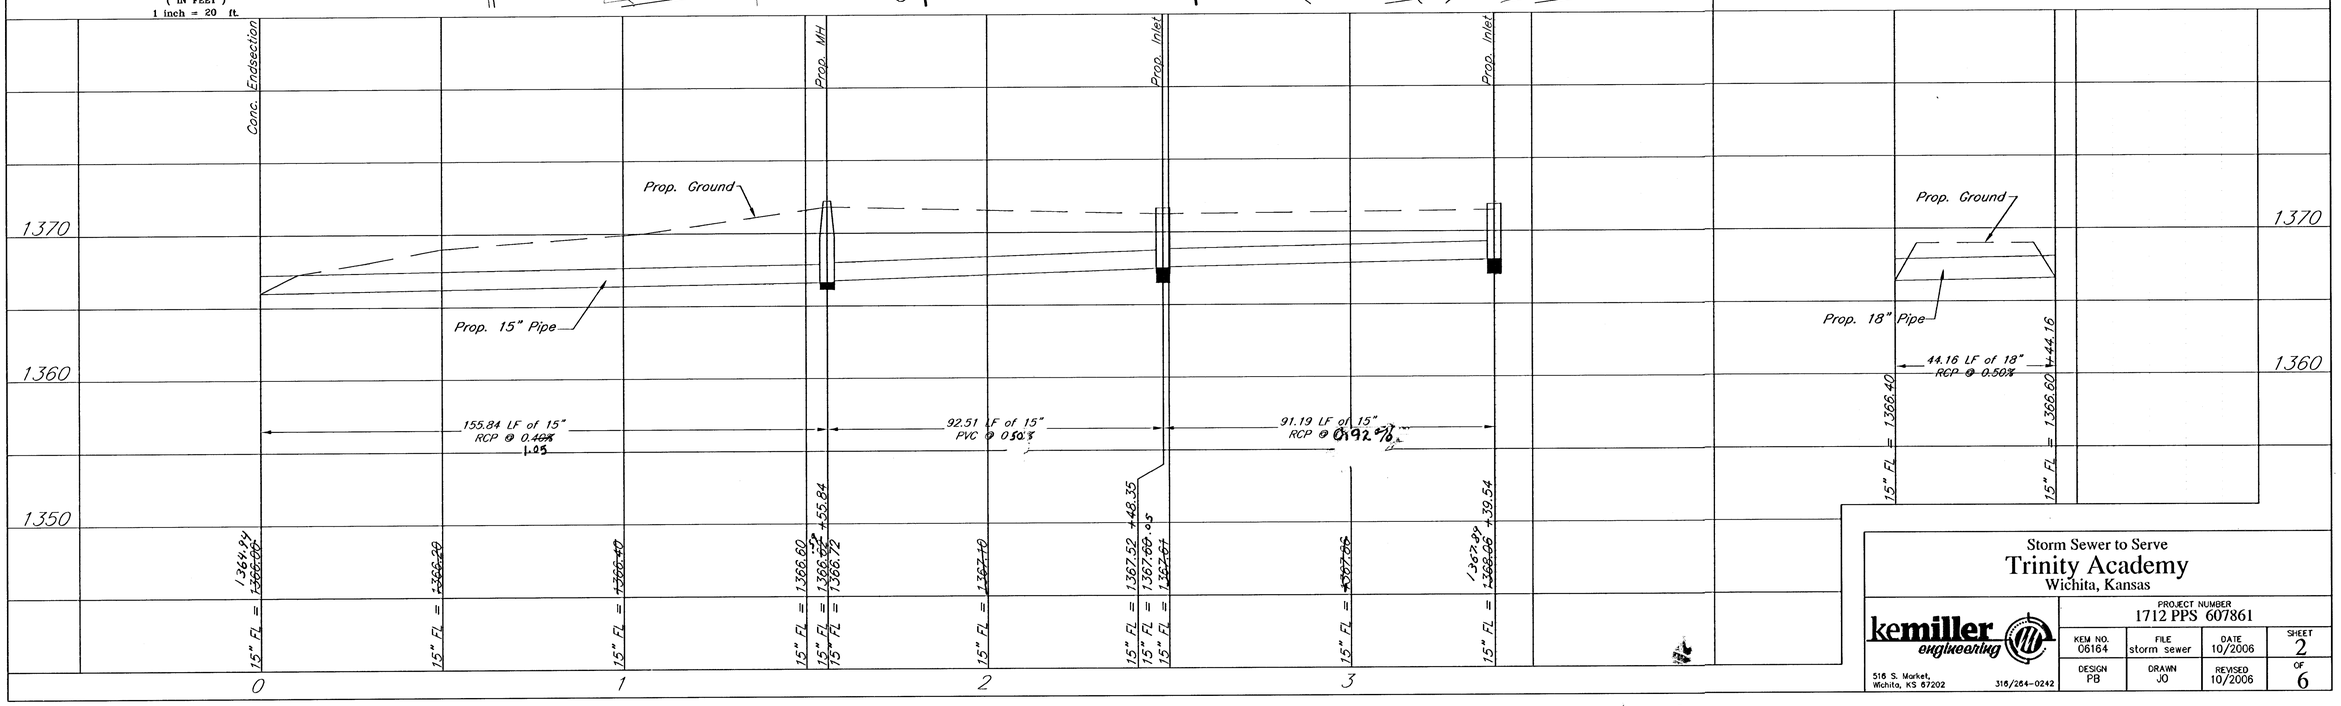

Storm Sewer to Serve

Trinity Academy

Wichita, Kansas

kemiller engineering
516 S. Market,
Wichita, KS 67202
316/264-0242

PROJECT NUMBER 1712 PPS 607861			
KEM NO. 06164	FILE storm sewer	DATE 10/2006	SHEET 2
DESIGN PB	DRAWN JO	REVISED 10/2006	OF 6