
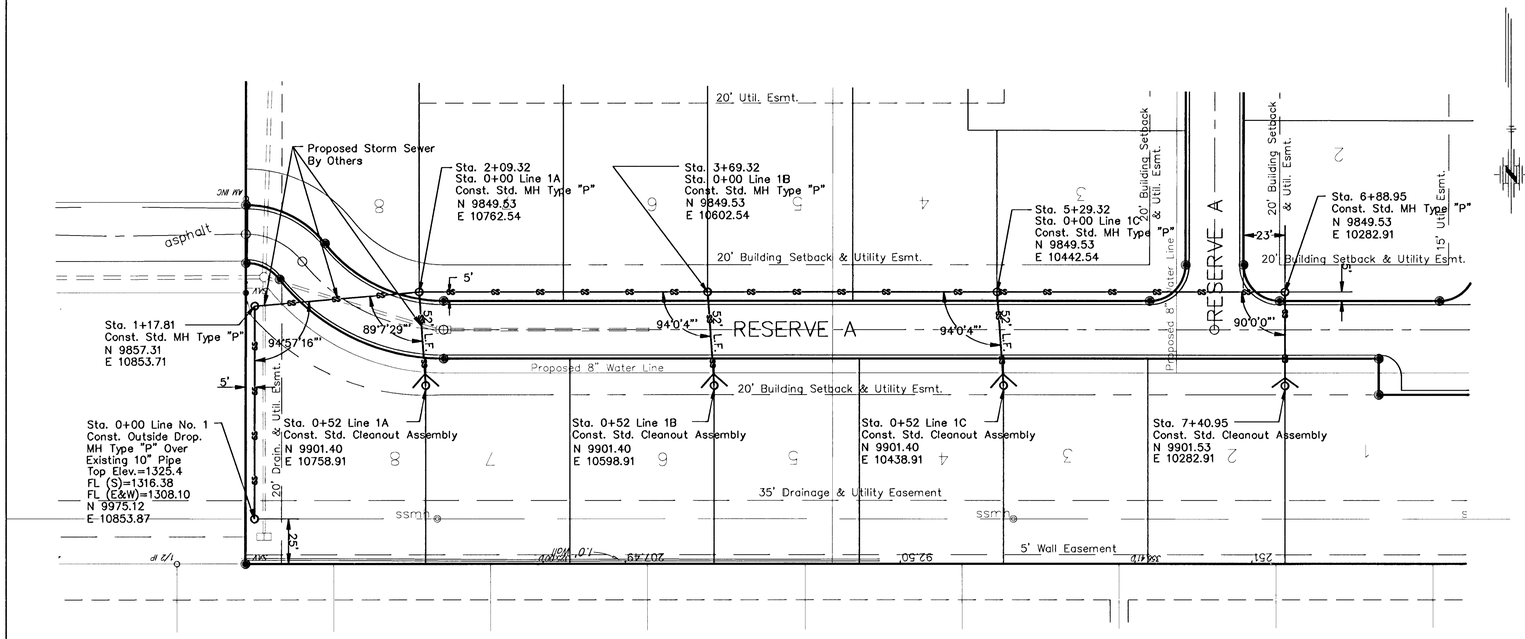


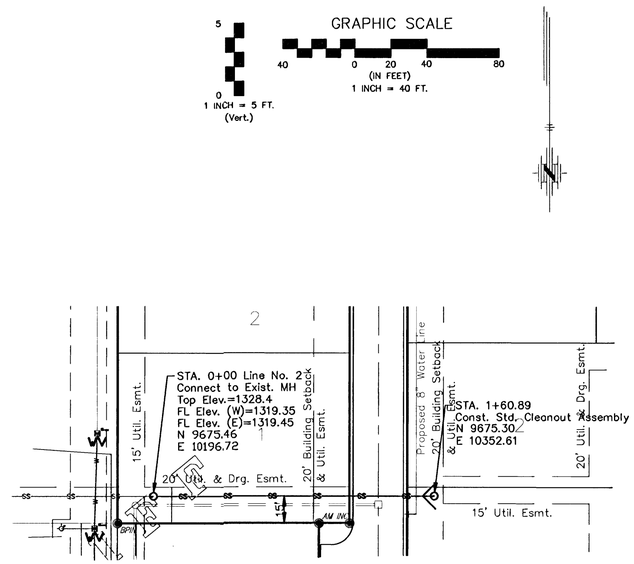

GRAPHIC SCALE

5 0 — 1 INCH = 5 FT. (Vert.)


40 0 20 40 80 — (IN FEET) 1 INCH = 40 FT.

No.	Date	By	Approved	Revision

OAK CLIFF ESTATES 6TH ADDITION
SANITARY SEWER IMPROVEMENTS
SEWERLINE NO. 1, 1A, 1B, 1C & 2
CITY OF WICHITA, KANSAS
JAMES ARMOUR, P.E. - CITY ENGINEER
1695 PPS (607861)

LINE NO. 1

LINE NO. 1A LINE NO. 1B LINE NO. 1C LINE NO. 2

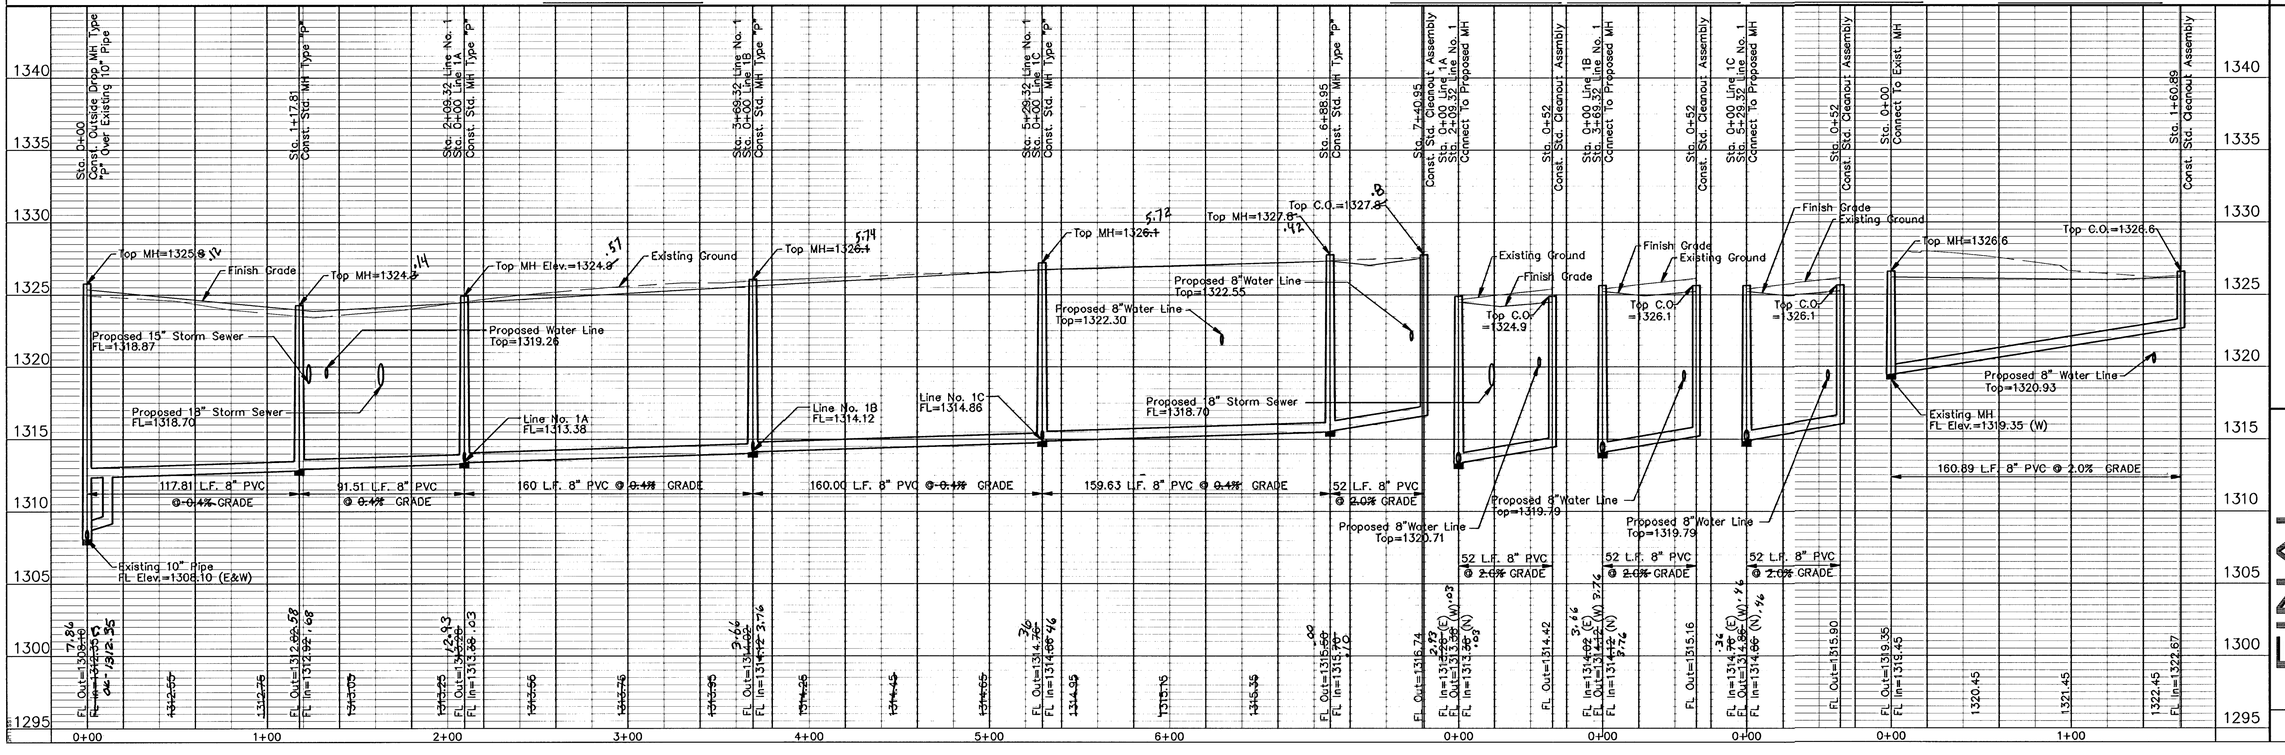

FINAL

Designed By: T. Austin
Drawn By: S. Schmidt
Poe Job No.: 821\Oak Cliff\base-ss-rev.dwg
Date: 08/30/2006

POE & ASSOCIATES, INC.
CONSULTING ENGINEERS
5940 E. Central, Suite 200 ■ Wichita, KS 67208-4242
Phone 316/685-4114 ■ FAX 316/685-4444