

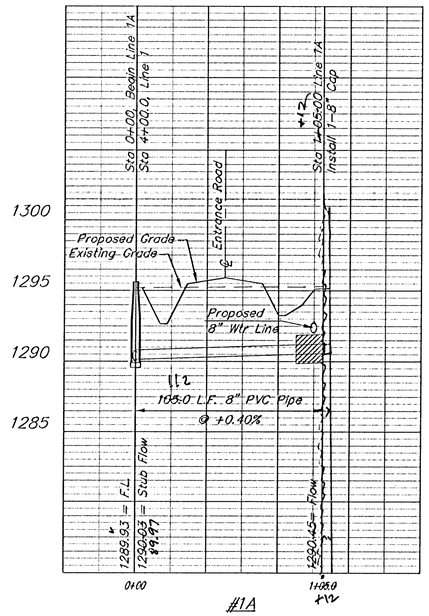



#1A

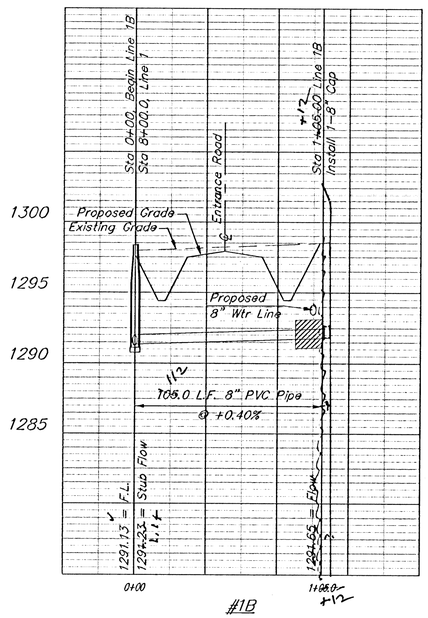


#1B

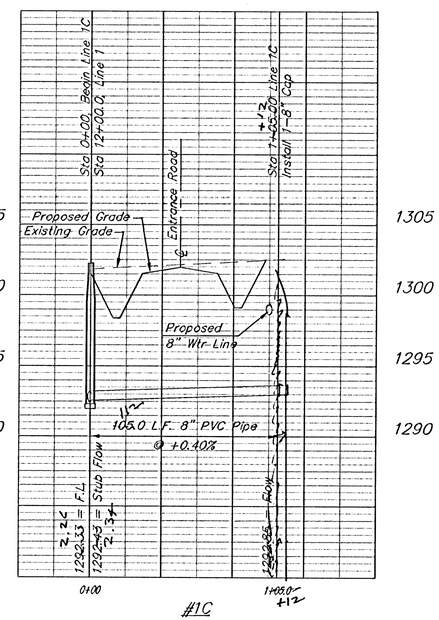


#1C

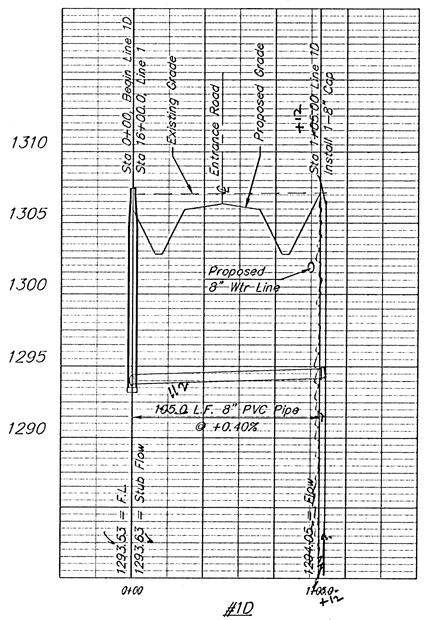

#1D

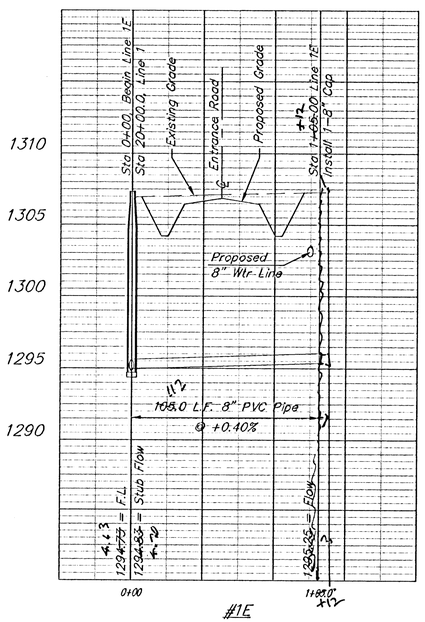


#1E

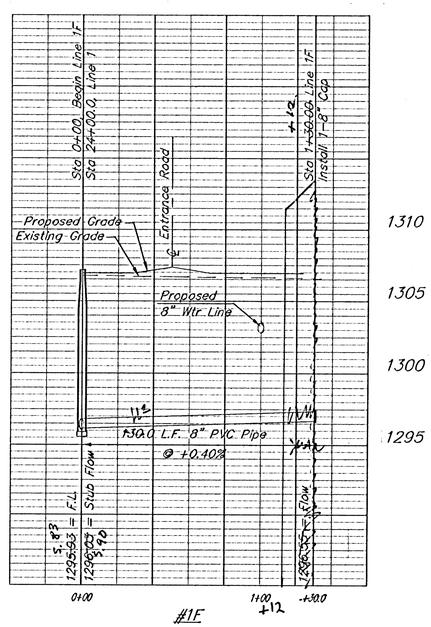

#1F

Scale: 1" = 5' Vertical

MARK ALL END OF STUBS WITH A #4 REBAR INSIDE A 3/4 ' I. D. PLASTIC PIPE. THE REBAR SHALL EXTEND FROM THE TOP OF THE RISER TO A POINT 6'(MAX.) BELOW THE GROUND SURFACE. THE PLASTIC PIPE SHALL EXTEND FROM THE TOP OF THE RISER TO A POINT 4 FEET (MIN.) ABOVE THE GROUND SURFACE. THE TOP 4 FEET OF THE PLASTIC PIPE SHALL BE PAINTED FLOURESCENT GREEN.

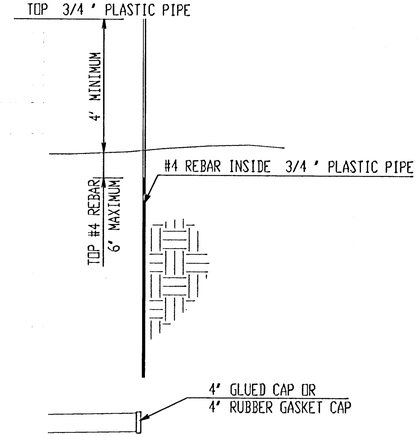

END OF LINE MARKING DETAIL

NOT TO SCALE

As Built 3/12/07 KSK

PROJECT NUMBER	SHEET NAME	ENGINEERING DIRECTORY
1726 PPS (607861)	Entrance Road	K:\CAD\Design

DESIGN	DRAWN	APPROVED	DATE	SCALE	BAUGHMAN NO
BLP	MDC	BLP	12/2006	Noted	06-10-HE280

ECCO INDUSTRIAL 2ND ADDITION
SANITARY SEWER CROSSINGS

CARLSON-BAUGHMAN
ENGINEERING | SURVEYING | GIS | MAPPING
1506 Vine St, Hays, KS 67601 P. 785-628-3219 F. 785-628-2132

SHEET 4 OF 7