

SCALE:
PLAN: LAT. & LONG. 0 40 80
PROFILE: HORIZ. SAME AS ABOVE
VERT. 5 0

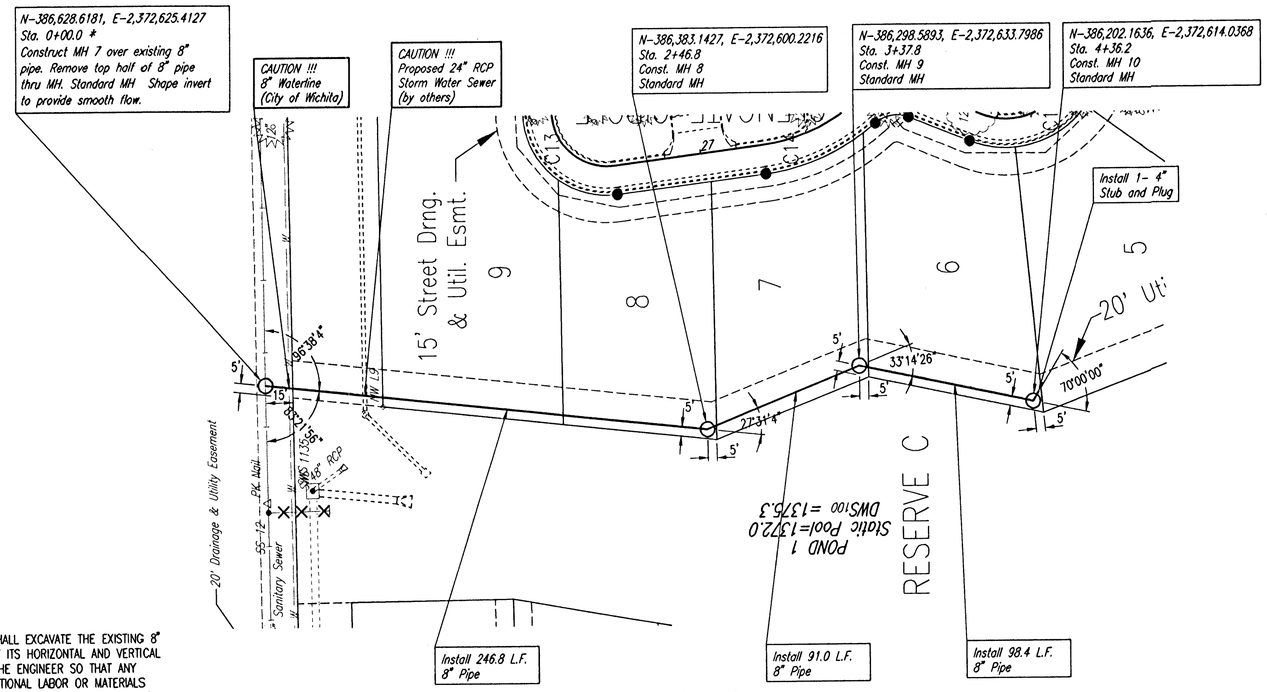

* PRIOR TO BEGINNING CONSTRUCTION, THE CONTRACTOR SHALL EXCAVATE THE EXISTING 8" PVC PIPE AT SANITARY SEWER STATION 0+00.0 TO VERIFY ITS HORIZONTAL AND VERTICAL LOCATION. THE PIPE LOCATION SHALL BE REPORTED TO THE ENGINEER SO THAT ANY NECESSARY PLAN MODIFICATIONS CAN BE MADE. ANY ADDITIONAL LABOR OR MATERIALS NECESSARY TO COMPLETE THE CONNECTION SHALL BE CONSIDERED SUBSIDIARY TO THE PROJECT.

SANITARY SEWER LINE NO. 4

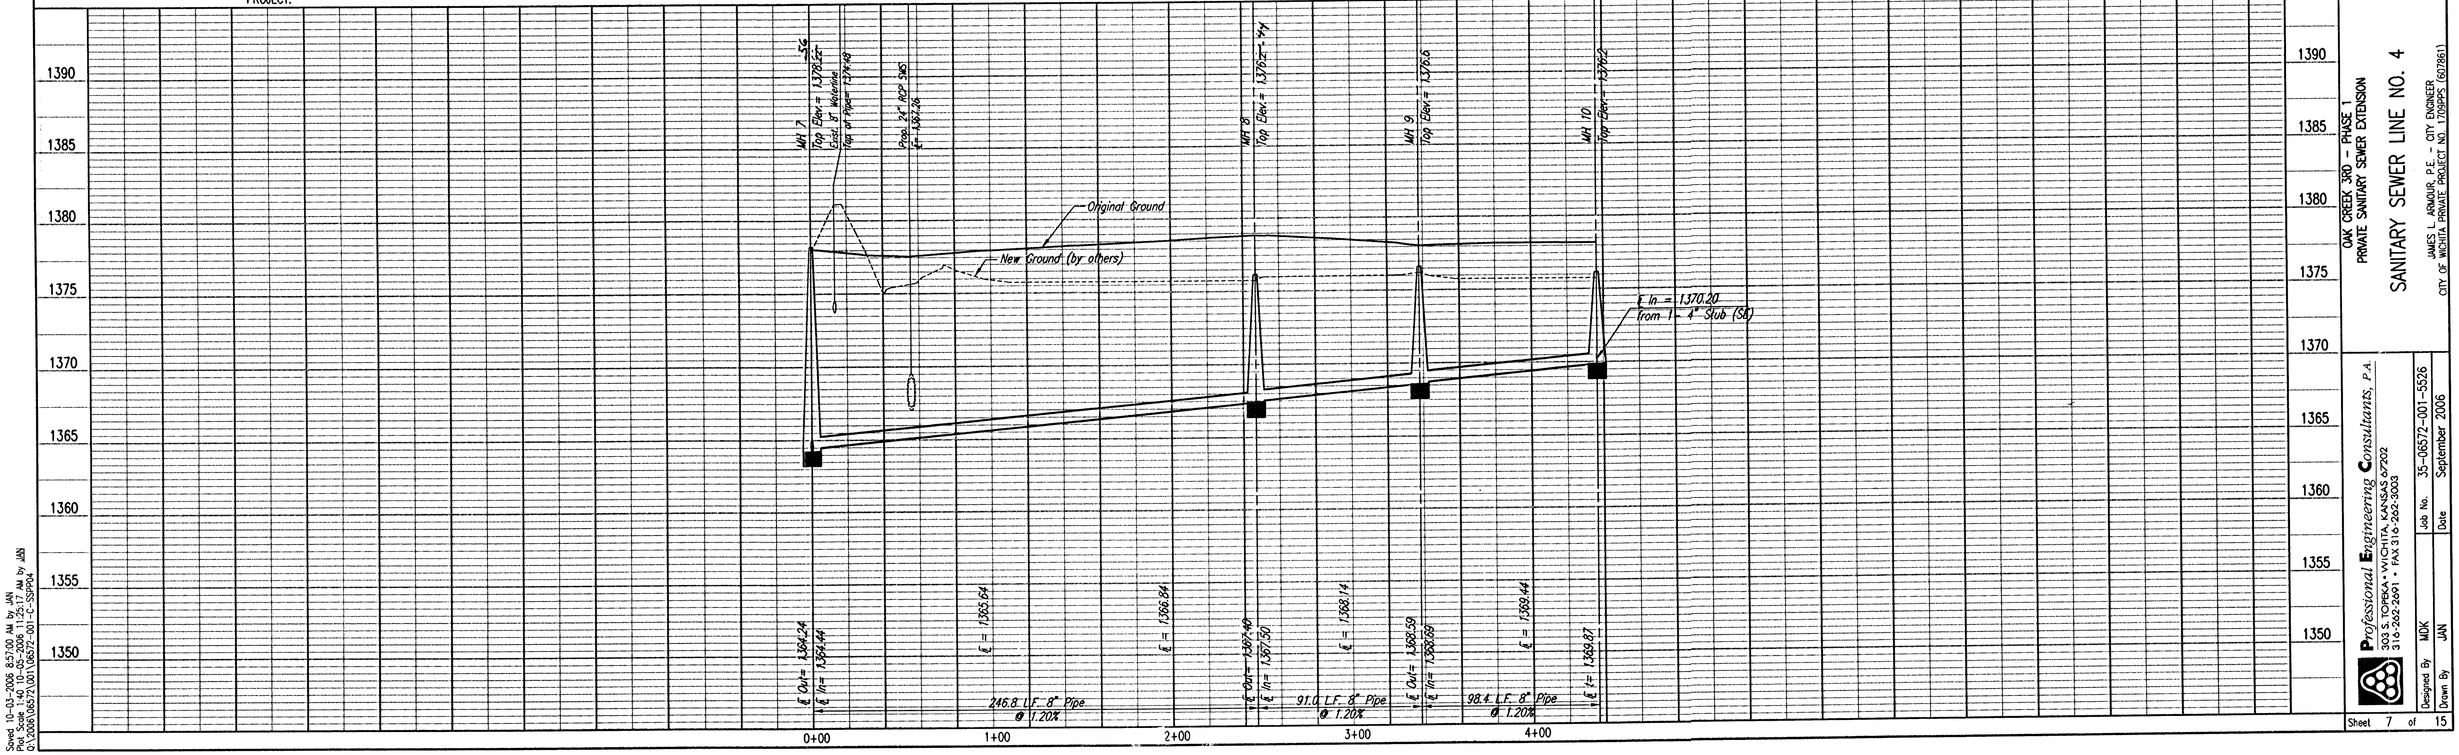

PLAN: CHECKED / CHECKED — BY — DATE

PROFILE: CHECKED / CHECKED — BY — DATE

Saved 10-03-2006 8:37:00 AM by JAN
Plot Scale 1:40 10-05-2006 11:25:17 AM by JAN
Q:\2006\06572\001\06572-001-C-SSP04

OAK CREEK 3RD - PHASE 1
PRIVATE SANITARY SEWER EXTENSION

SANITARY SEWER LINE NO. 4

JAMES L. ARMOUR, P.E. - CITY ENGINEER
CITY OF WICHITA PRIVATE PROJECT NO. 1705PPS (607861)

MICHAEL D. KEEL — 13944 — 10/5/06 — KANSAS — PROFESSIONAL ENGINEER

Professional Engineering Consultants, P.A.
303 S. TOPEKA • WICHITA, KANSAS 67202
316-262-2691 • FAX 316-262-5603

Designed By	MDK	Job No.	35-06572-001-5526
Drawn By	JAN	Date	September 2006

Sheet 7 of 15