



LINE 1

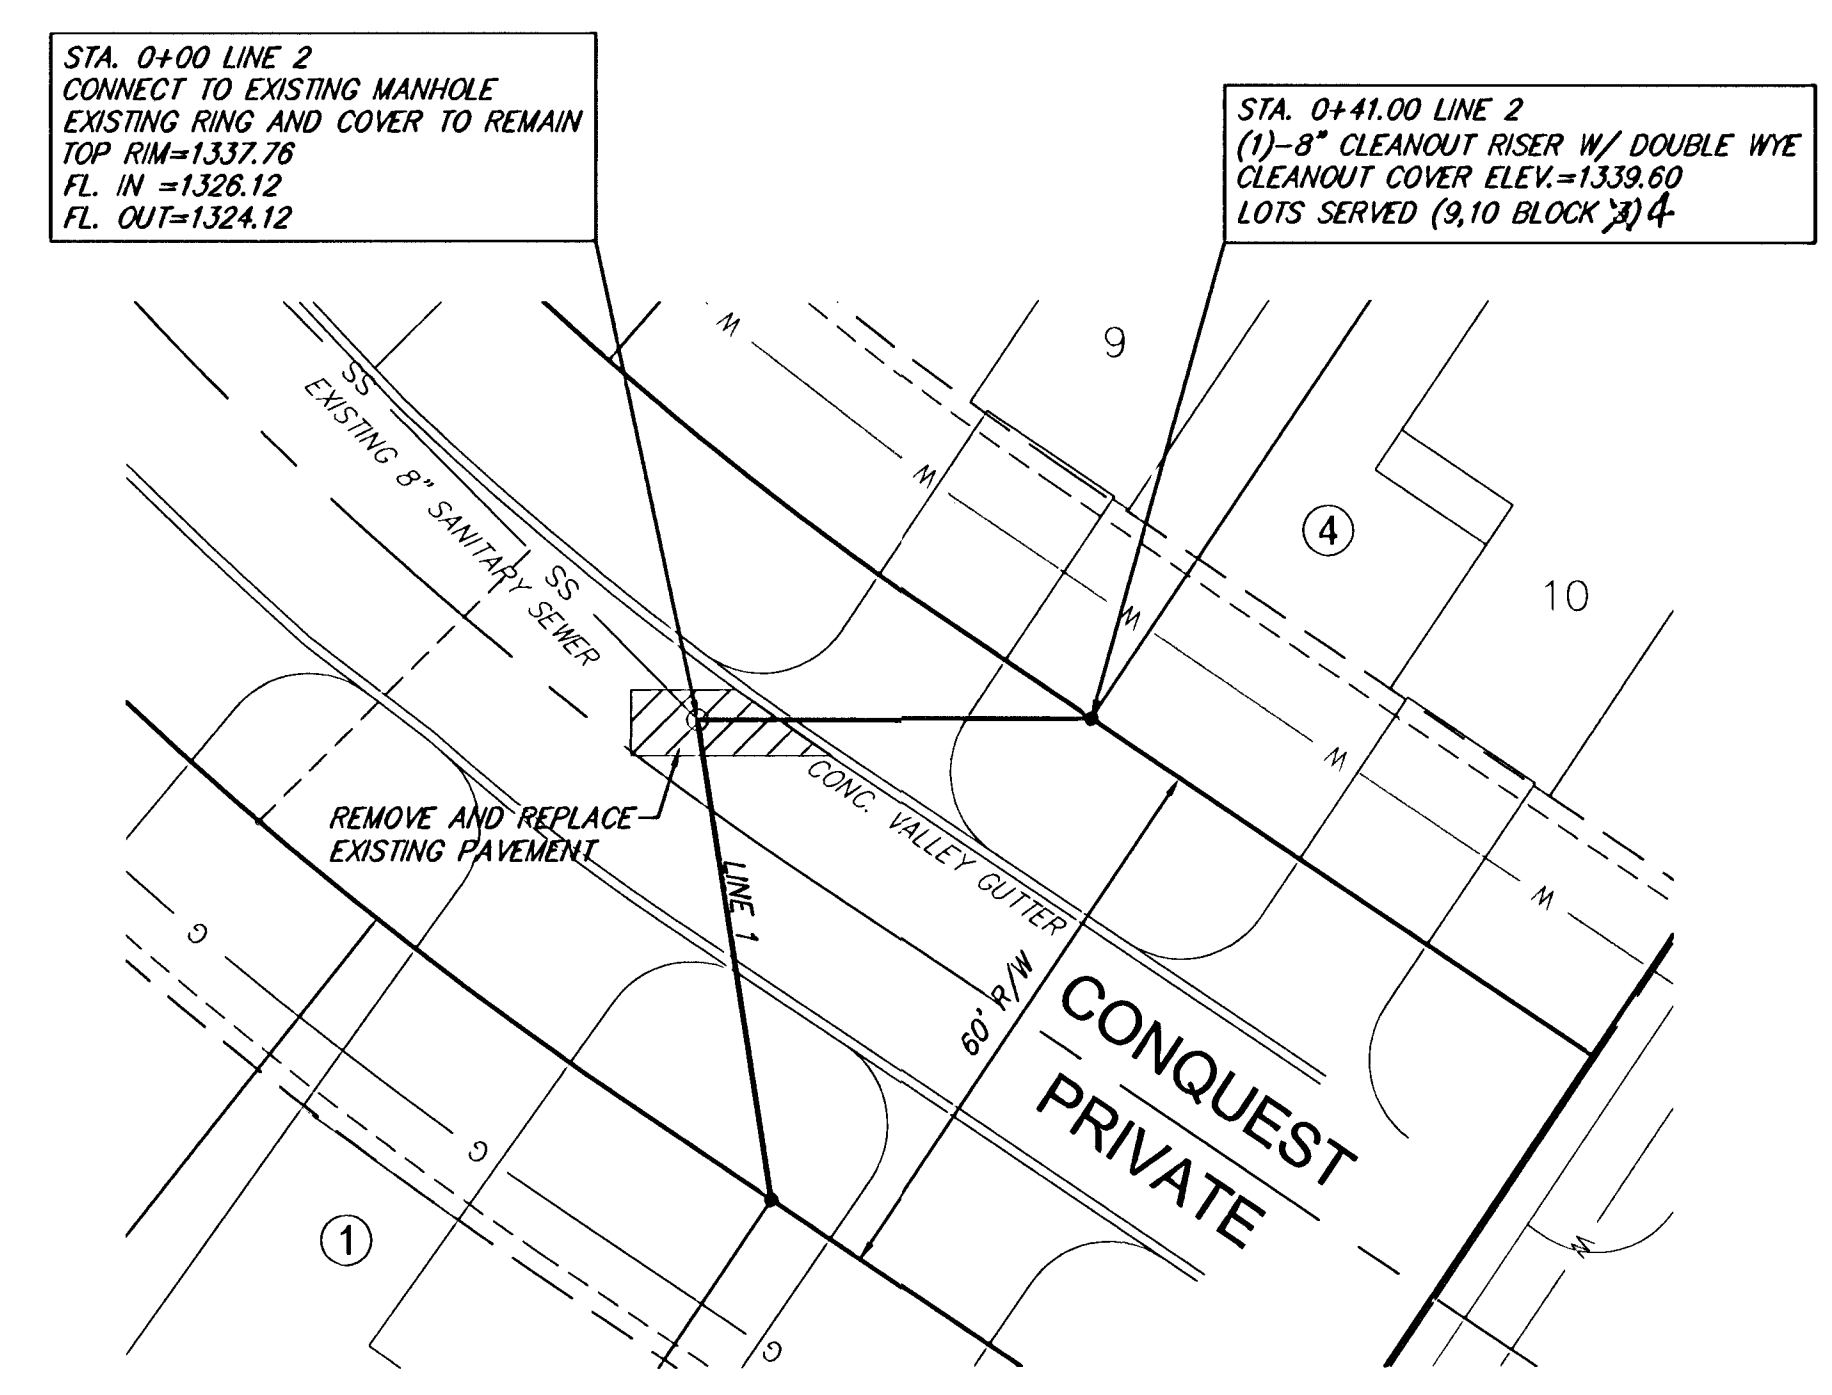

LINE 2

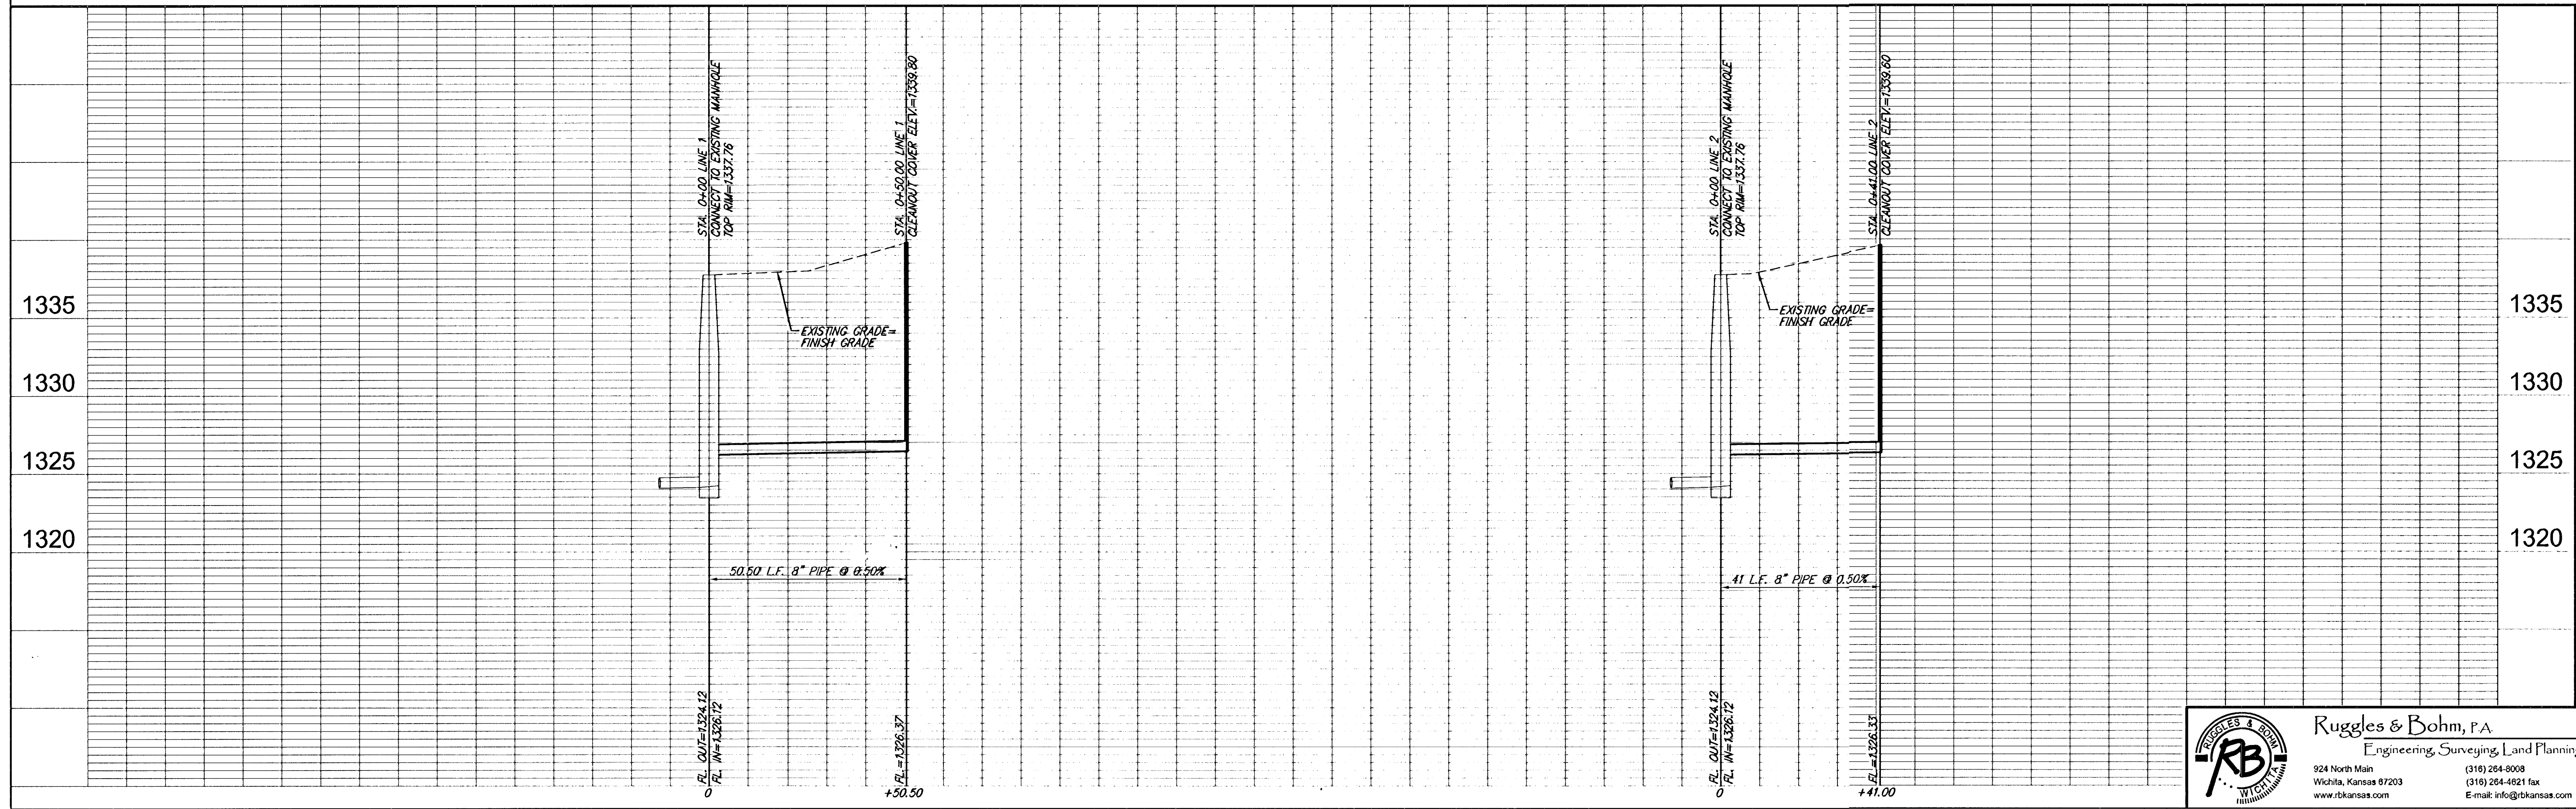

REVISION	DATE	BY	REVIEW
DESIGN	DATE		
TCR	June 27, 2006		
UTILITY			
PROJECT NUMBER	1470 PPS		
DRAWING FILE	Utility [S 1]		
CONQUEST NORTH 2ND ADDITION SANITARY SEWER WICHITA, KANSAS			
RB JOB #	2887E		
SHEET	2		

Ruggles & Bohm, P.A.
 Engineering, Surveying, Land Planning
 924 North Main
 Wichita, Kansas 67203
 www.rbkansas.com
 (318) 264-9008
 (318) 264-4921 fax
 E-mail: info@rbkansas.com