

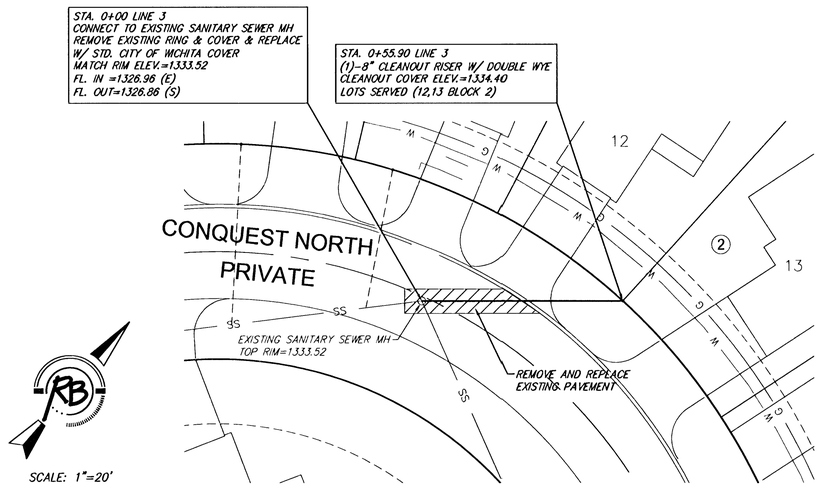



LINE 3

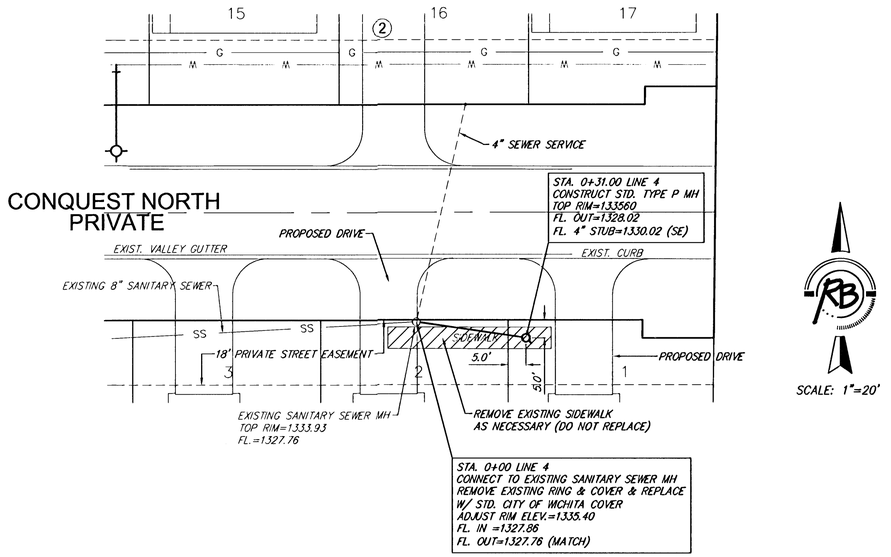

LINE 4

Rev. as built 9-11-06 JCR

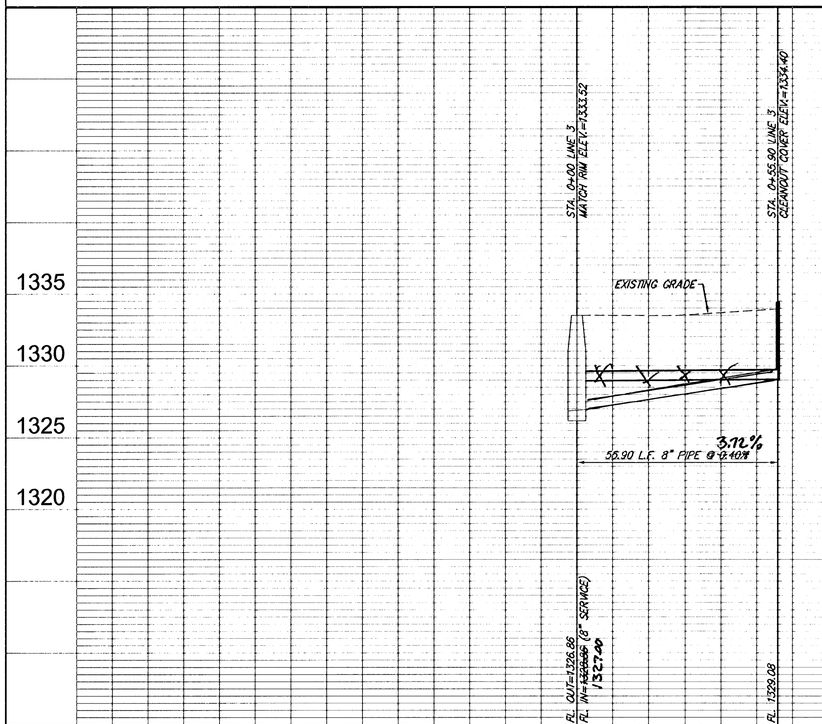

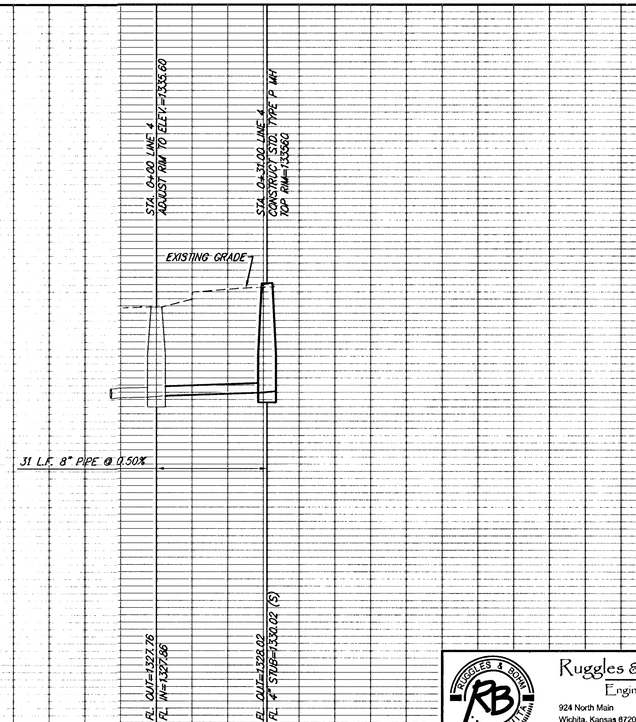

DESIGN	TGR
DRAWN	EJB
CHECKED	
DATE	June 27, 2006
UTILITY	
REVISED	
REVIEW	
PROJECT NUMBER	1670
DRAWING FILE	Utility SS 2

CONQUEST NORTH 2ND ADDITION
SANITARY SEWER
WICHITA, KANSAS

Ruggles & Bohm, P.A.
Engineering, Surveying, Land Planning
924 North Main
Wichita, Kansas 67203
www.rbkansas.com
(316) 264-8008
(316) 264-4621 fax
E-mail: info@rbkansas.com

RB JOB 2867E

SHEET 6 of 6