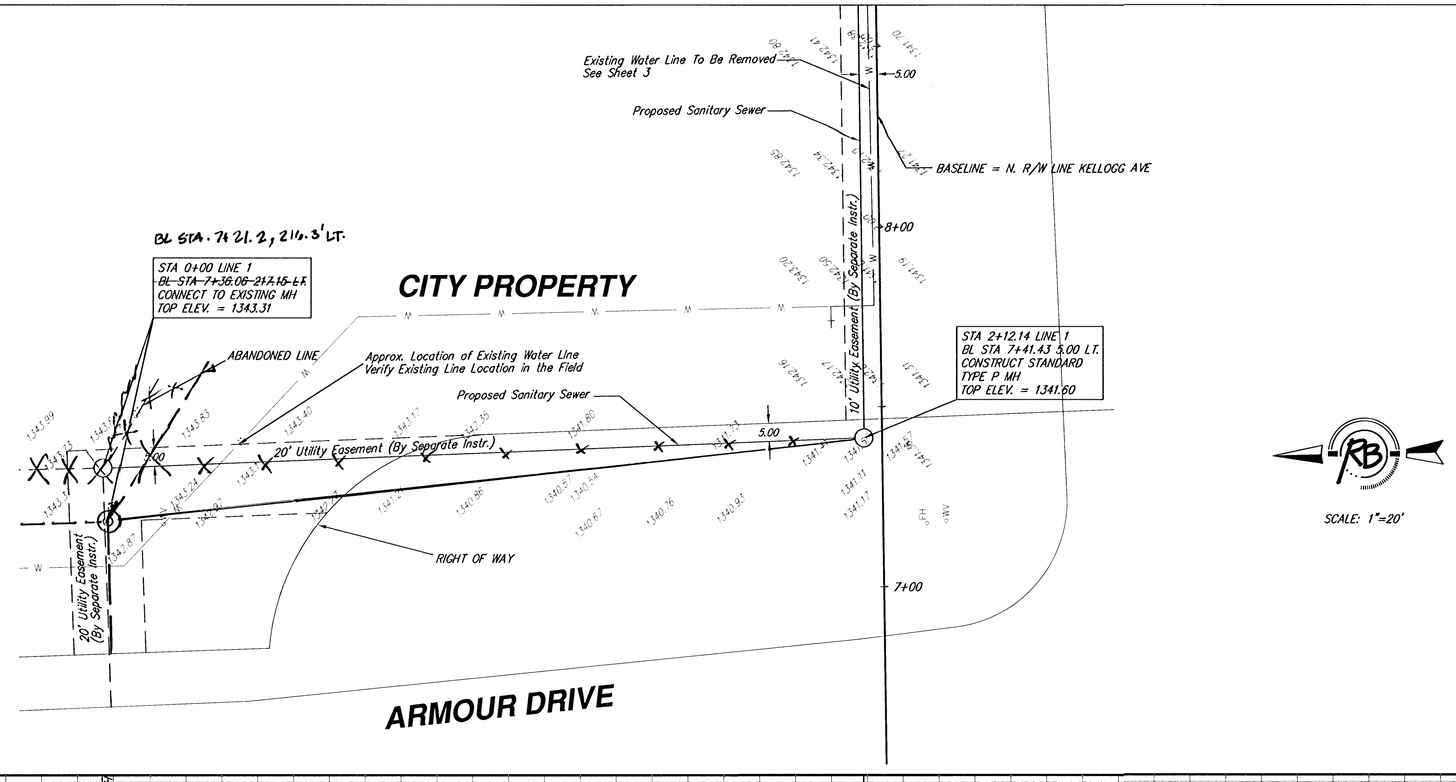

SCALE: 1"=20'

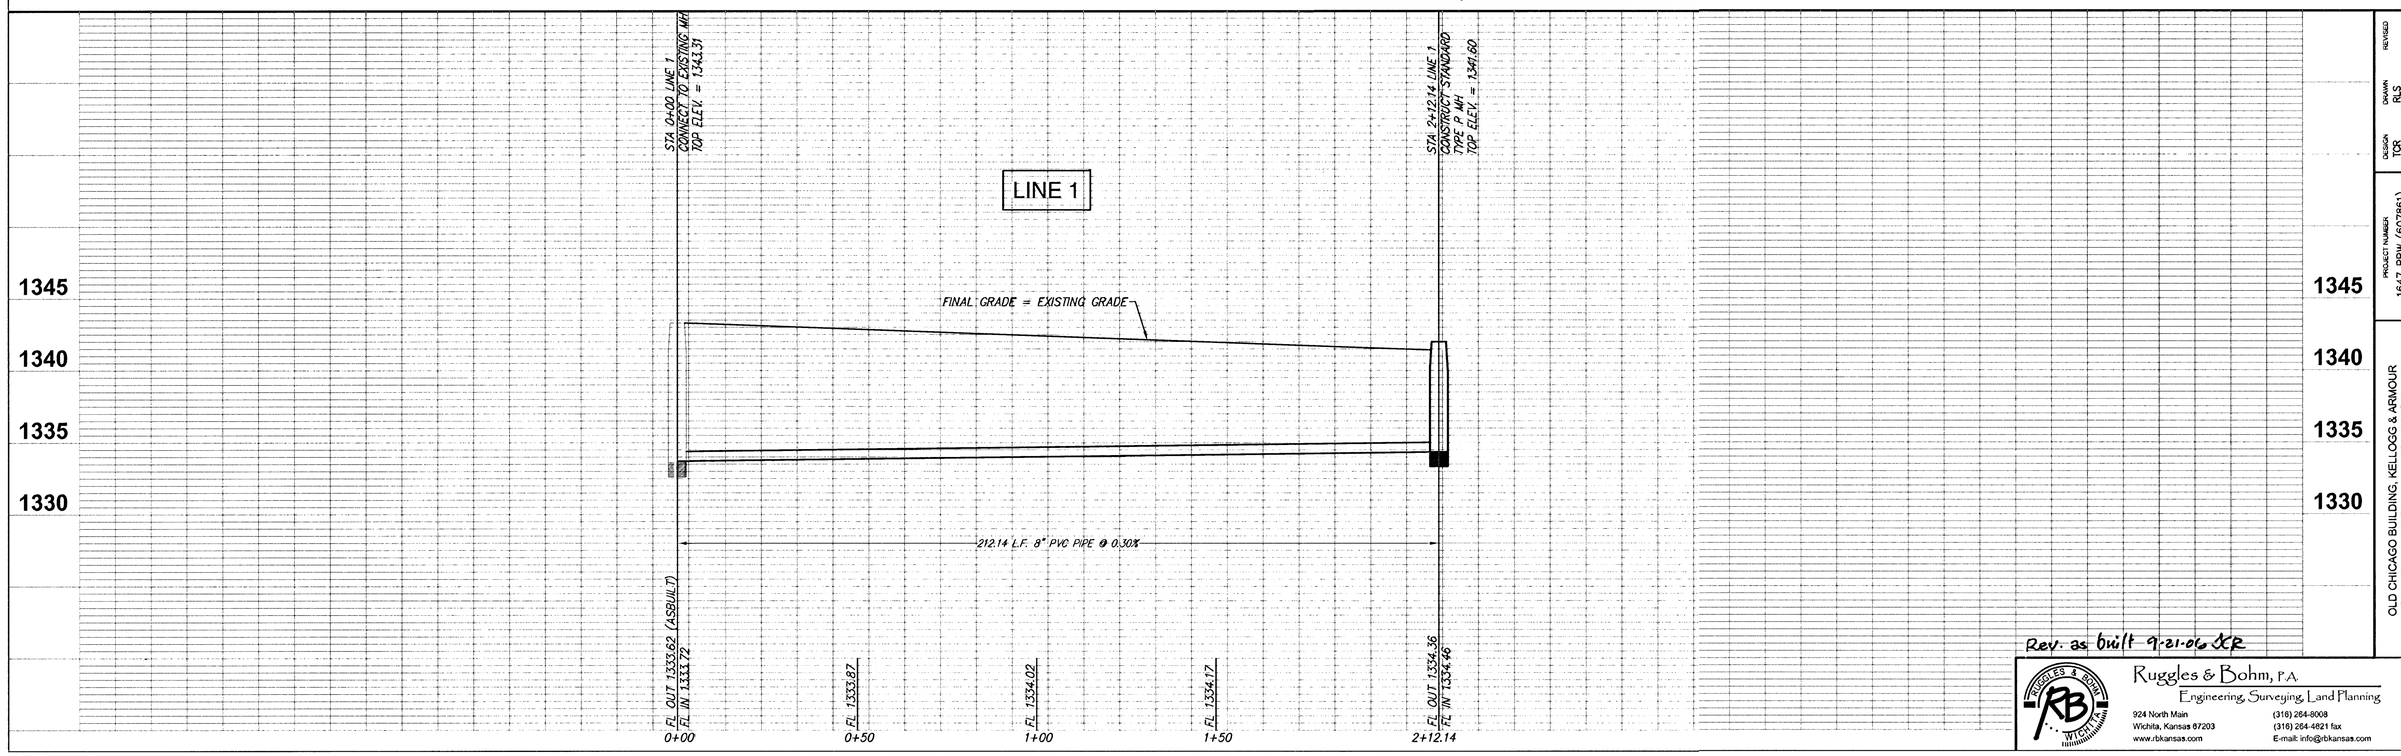

Rev. as built 9-21-06 JCR

Ruggles & Bohm, P.A.
Engineering, Surveying, Land Planning
924 North Main
Wichita, Kansas 67203
www.rbkansas.com
(316) 264-8008
(316) 264-4921 fax
E-mail: info@rbkansas.com

RB JOB 2804E
SHEET 2 OF 4

DESIGN TQR
DRAWN RLS
REVISED
UTILITY
DATE March 20, 2006
REVIEW

PROJECT NUMBER 1647 PPW (607861)
DRAWING FILE Base {SS}

OLD CHICAGO BUILDING, KELLOGG & ARMOUR
SANITARY SEWER & PROFILE
WICHITA, KANSAS