
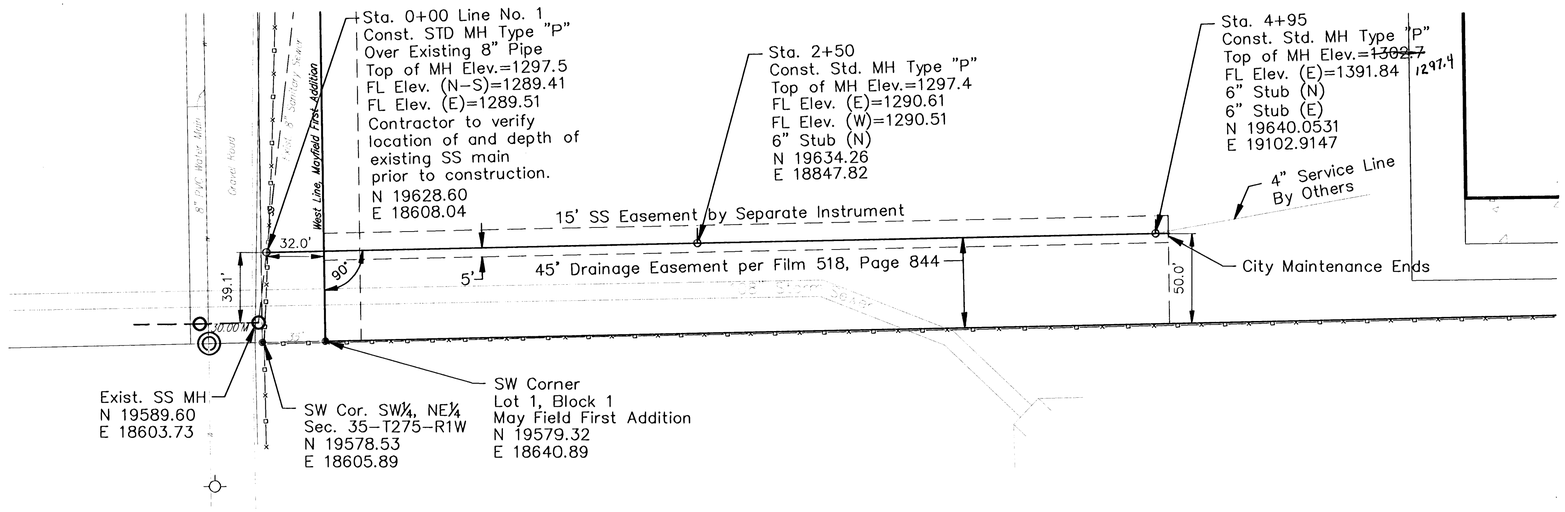


GRAPHIC SCALE

5 0 (Vert.) 1 INCH = 5 FT.

40 0 20 40 80 (IN FEET) 1 INCH = 40 FT.

LINE NO. 1

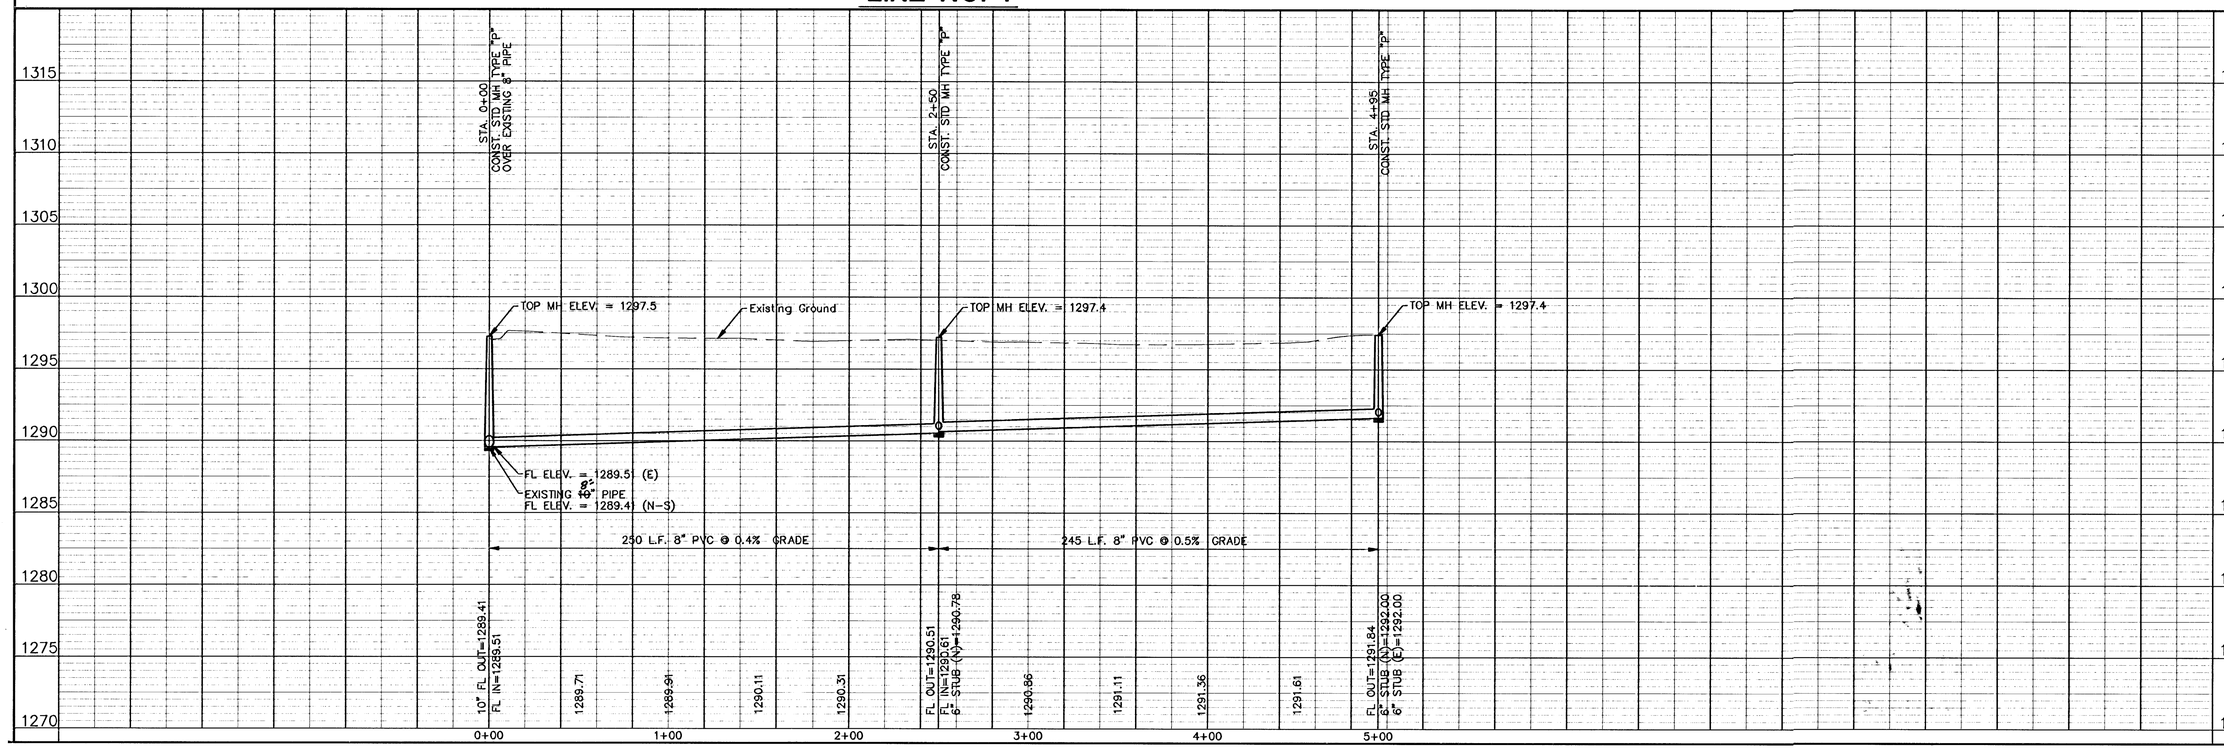

No.	Date	By	Approved	Revision

MAY FIELD FIRST ADDITION
SANITARY SEWER IMPROVEMENTS
SEWERLINE NO. 1
CITY OF WICHITA, KANSAS
JAMES ARMOUR, P.E. - CITY ENGINEER
1677 PPS (607861)

POE & ASSOCIATES, INC.
CONSULTING ENGINEERS
5940 E. Central, Suite 200 ■ Wichita, KS 67208-4242
Phone 316/685-4114 ■ FAX 316/685-4444

FINAL

Designed By: T. Austin/S. Schmidt
Drawn By: M. Myers
Poe Job No.: 815\base-ss.dwg
Date: June 2006