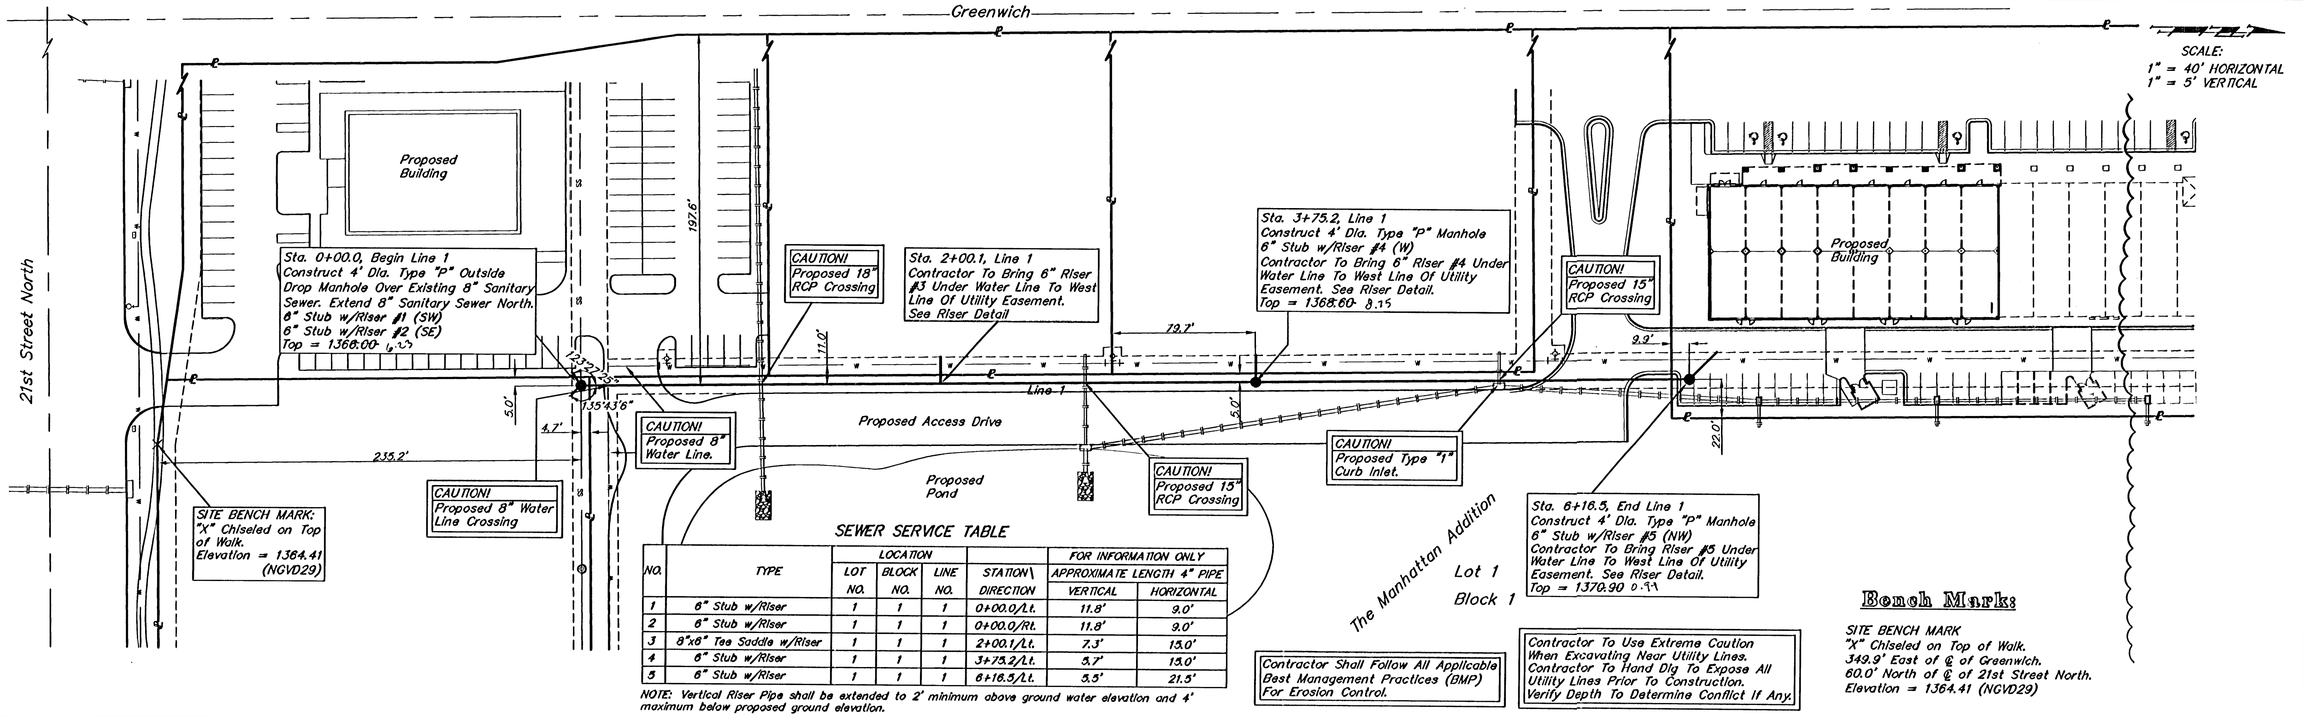


SEWER SERVICE TABLE

NO.	TYPE	LOCATION LOT NO.	LOCATION BLOCK NO.	LOCATION LINE NO.	LOCATION STATION\ DIRECTION	FOR INFORMATION ONLY APPROXIMATE LENGTH 4" PIPE VERTICAL	FOR INFORMATION ONLY APPROXIMATE LENGTH 4" PIPE HORIZONTAL
1	6" Stub w/Riser	1	1	1	0+00.0/Lt.	11.8'	9.0'
2	6" Stub w/Riser	1	1	1	0+00.0/Rt.	11.8'	9.0'
3	8"x6" Tee Saddle w/Riser	1	1	1	2+00.1/Lt.	7.3'	15.0'
4	6" Stub w/Riser	1	1	1	3+75.2/Lt.	5.7'	15.0'
5	6" Stub w/Riser	1	1	1	6+16.5/Lt.	5.5'	21.5'


NOTE: Vertical Riser Pipe shall be extended to 2' minimum above ground water elevation and 4' maximum below proposed ground elevation.

Contractor Shall Follow All Applicable Best Management Practices (BMP) For Erosion Control.

Contractor To Use Extreme Caution When Excavating Near Utility Lines. Contractor To Hand Dig To Expose All Utility Lines Prior To Construction. Verify Depth To Determine Conflict If Any.

Bench Mark:

SITE BENCH MARK
"X" Chiseled on Top of Walk.
349.9' East of ℄ of Greenwich.
60.0' North of ℄ of 21st Street North.
Elevation = 1364.41 (NGVD29)

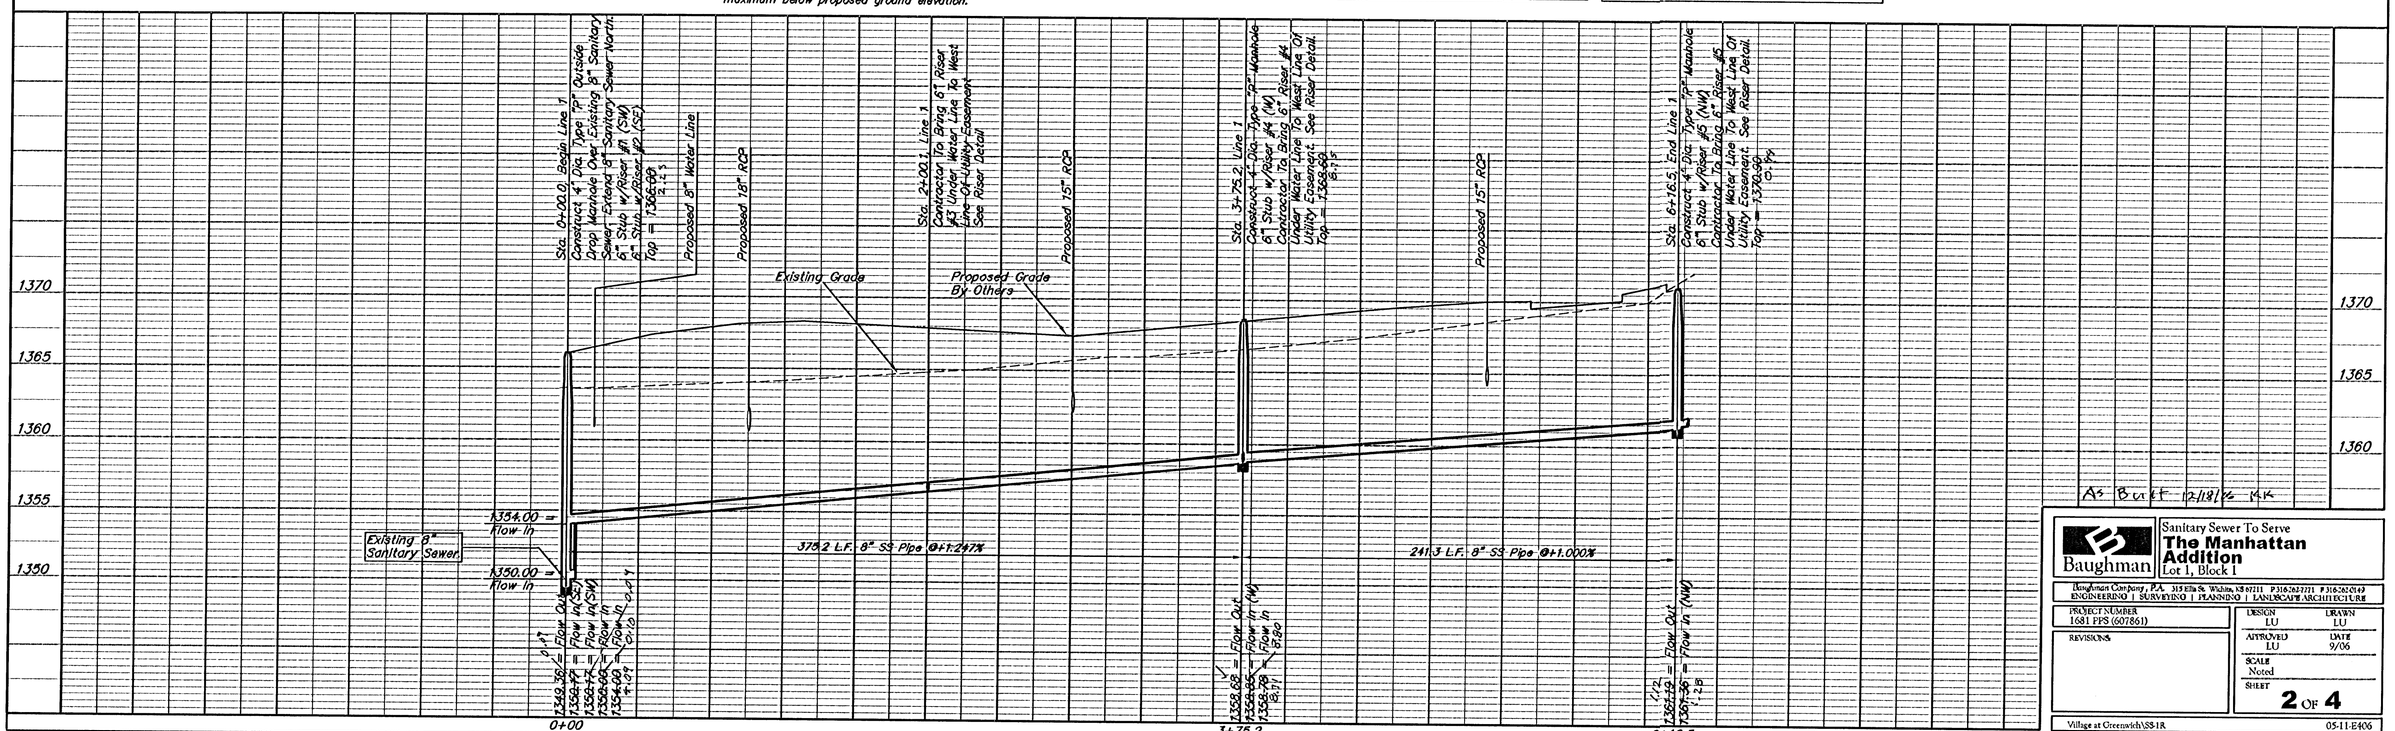

As Built 12/18/06 KK

Baughman

Sanitary Sewer To Serve
The Manhattan Addition
Lot 1, Block 1

Baughman Company, P.A. 315 Ella St. Wichita, KS 67211 P 316.262.2721 F 316.267.0143
ENGINEERING | SURVEYING | PLANNING | LANDSCAPE ARCHITECTURE

PROJECT NUMBER 1681 PFS (607861)

REVISIONS

DESIGN LU | DRAWN LU | APPROVED LU | DATE 9/06 | SCALE Noted | SHEET 2 OF 4

Village at Greenwich\SS-1R

05-11-E406