SANITARY SEWER EXTENSION

GOODWILL INDUSTRIES, MAIZE ROAD AND 37TH ST NORTH
PRIVATE PROJECT NUMBER 1664 PPS (607861)
LOT 2, BLOCK 1, WADLEY RANCH ADDITION, MAIZE, KS.

GENERAL NOTES

1. Contractor will be required to provide a minimum advance notice of fourty-eight (48) hours to utility companies prior to starting any excavation as follows:

Kansas One-Call	887-2470

The Contractor must notify the following in case of an emergency:

Cox Communications	262-0661
Kansas Gas Service	383-8600
Westar	383-8600
Aquila Energy	1-800-303-0357
Southwestern Bell Telephone Company	1-800-286-8313
City of Wichita Water Department	262-6000
City of Wichita Sewer Maintenance	262-6000

2. Existing utilities and their location, as shown on the plans, represent the best information obtainable for design. Location information has been obtained from the various utility companies and is either from company record drawings or company-provided field locations. The Contractor will be required to work around existing utilities within the right-of-way which do not conflict with proposed construction.

3. This project is located within the limits of a larger project which will include building construction. The General Contractor for the project will submit a Storm Water Pollution Prevention Plan for the entire project prior to beginning any work on this project.

4. This project is to be constructed in accordance with City of Wichita Standard Specifications for the Construction of City Projects, and Policy on Construction of Public Works Improvements by Private Contract.

5. No work shall begin on this project before required bonds are submitted to the City of Wichita, and the project inspector has been notified.

6. All areas of public R/W disturbed by construction of this project are to be restored in accordance with Administrative Regulation AR 78 of the City of Wichita.

7. Sewage flow in the existing sanitary sewer shall be maintained at all times. The Contractor's plan for maintaning flow shall be submitted and approved by the Engineer prior to beginning work on the project.

8. Contractor is to provide a traffic control plan.

Mies Construction, Inc.- Contractor
Kelly, RB - Inspector
Released 9/29/06
As-Built
.pdf by JDL 10/3/06

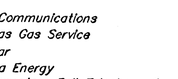

SERVICE AREA

SCALE: 1"=50'

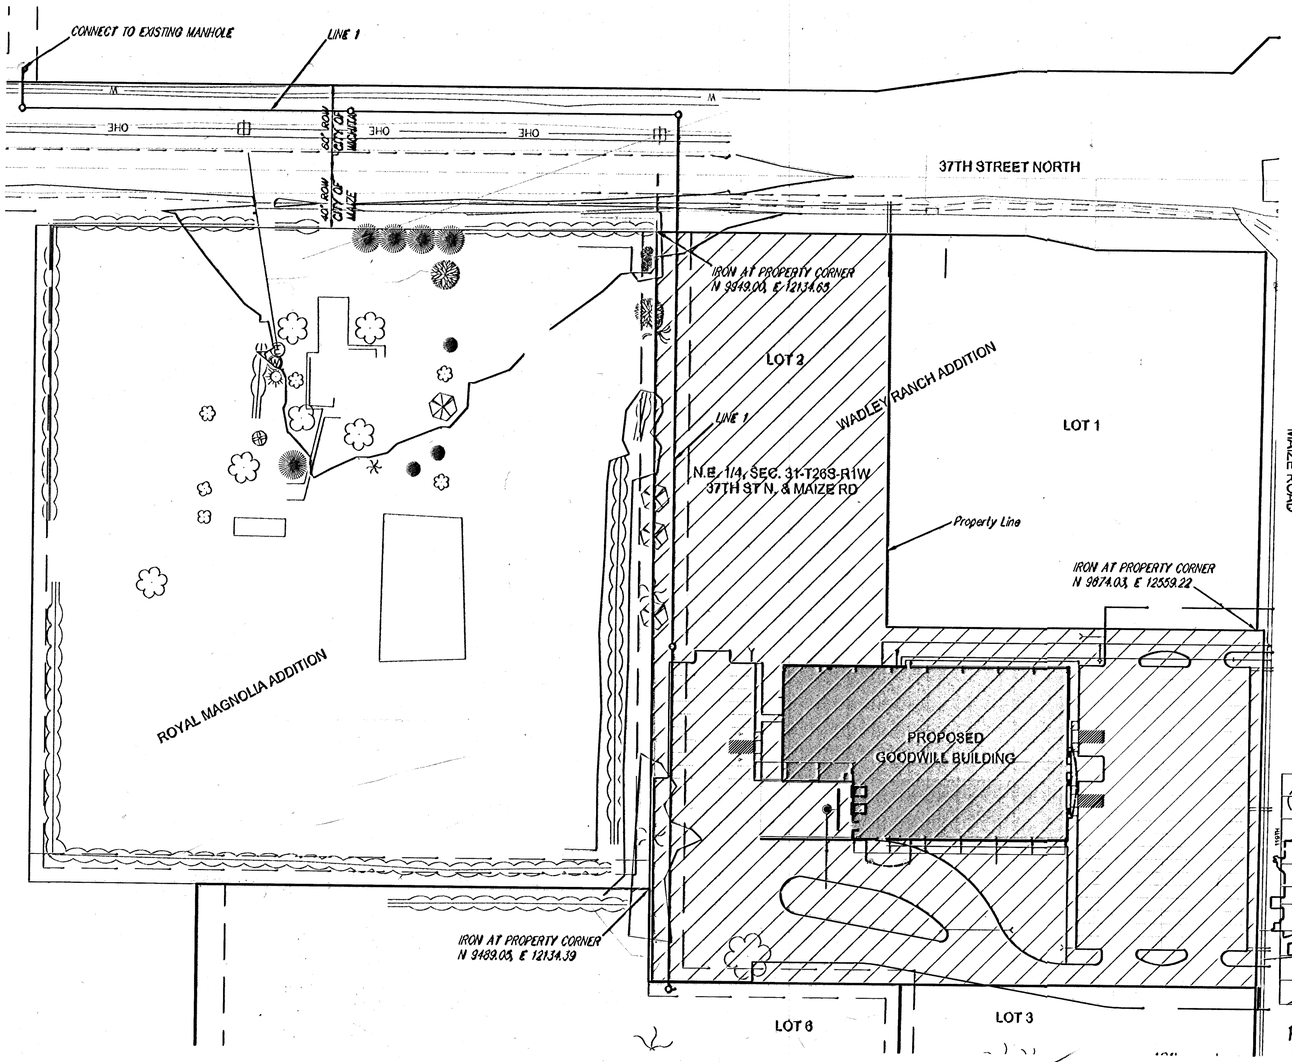

INDEX OF SHEETS

1. TITLE SHEET
2-4. SANITARY SEWER PLAN/PROFILE
5. TYPE 'P' MANHOLE DETAILS

BENCHMARKS

-'D' EAST SIDE OF CONCRETE FLUME, W. SIDE MAIZE RD., 100 FT S. OF HAMPTON LAKES RD.

APPROVED AS NOTED
BY CITY ENGINEER OF WICHITA

Sanitary Sewers VRH 6/5/06
Storm Sewers
Driveway Approaches
Water Mains
Paving

NOTE TO CONTRACTORS

Inspection and testing for this project are to be provided by a Licensed Consulting Engineering Firm under contract with the Owner/Developer. Said inspection to be in accordance with the City of Wichita standard construction engineering practices and certified by a Licensed Professional Engineer. No work shall be performed in dedicated easements or public right-of-way by the Contractor without such inspection, nor shall any work be commenced without written authorization by the City Engineer.

PROJECT LOCATION VICINITY MAP

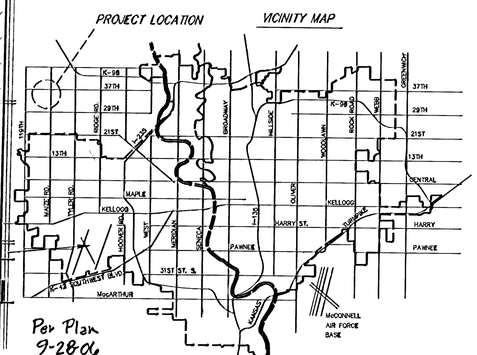

Per Plan 9-28-06 E RtB

CITY OF WICHITA, KANSAS
JAMES L. ARMOUR, P.E., CITY ENGINEER

Ruggles & Bohm, P.A.
Engineering, Surveying, Land Planning
924 North Main
Wichita, Kansas 67203
www.rbkansas.com
(316) 264-8008
(316) 264-4621 fax
E-mail: info@rbkansas.com

2839E