
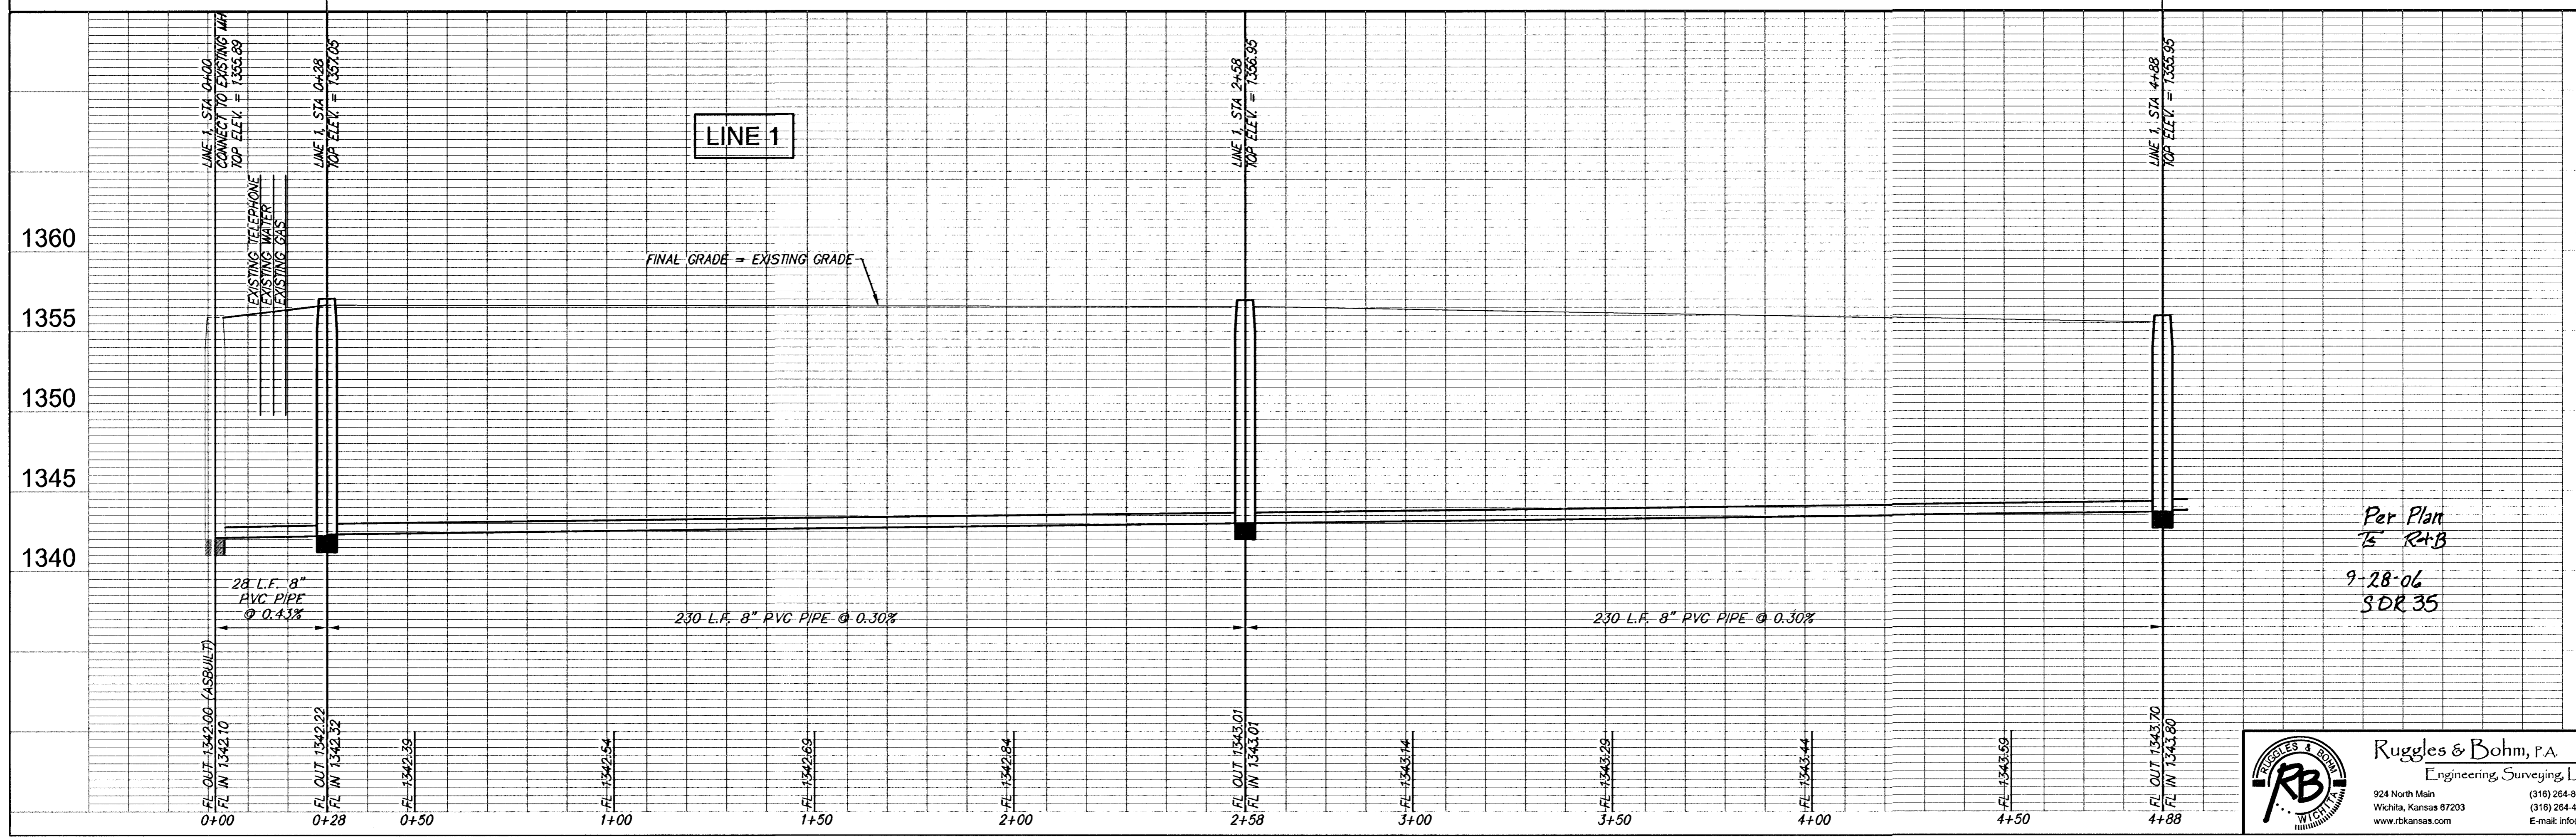
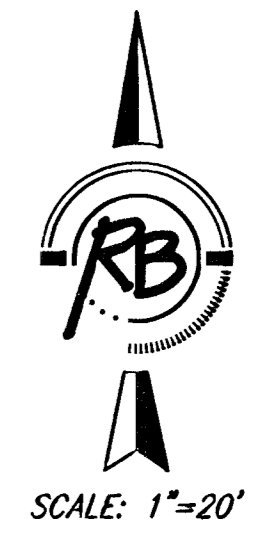


PRAIRIE  
POINT  
ADDITION

HAMPTON SQUARE ADDITION

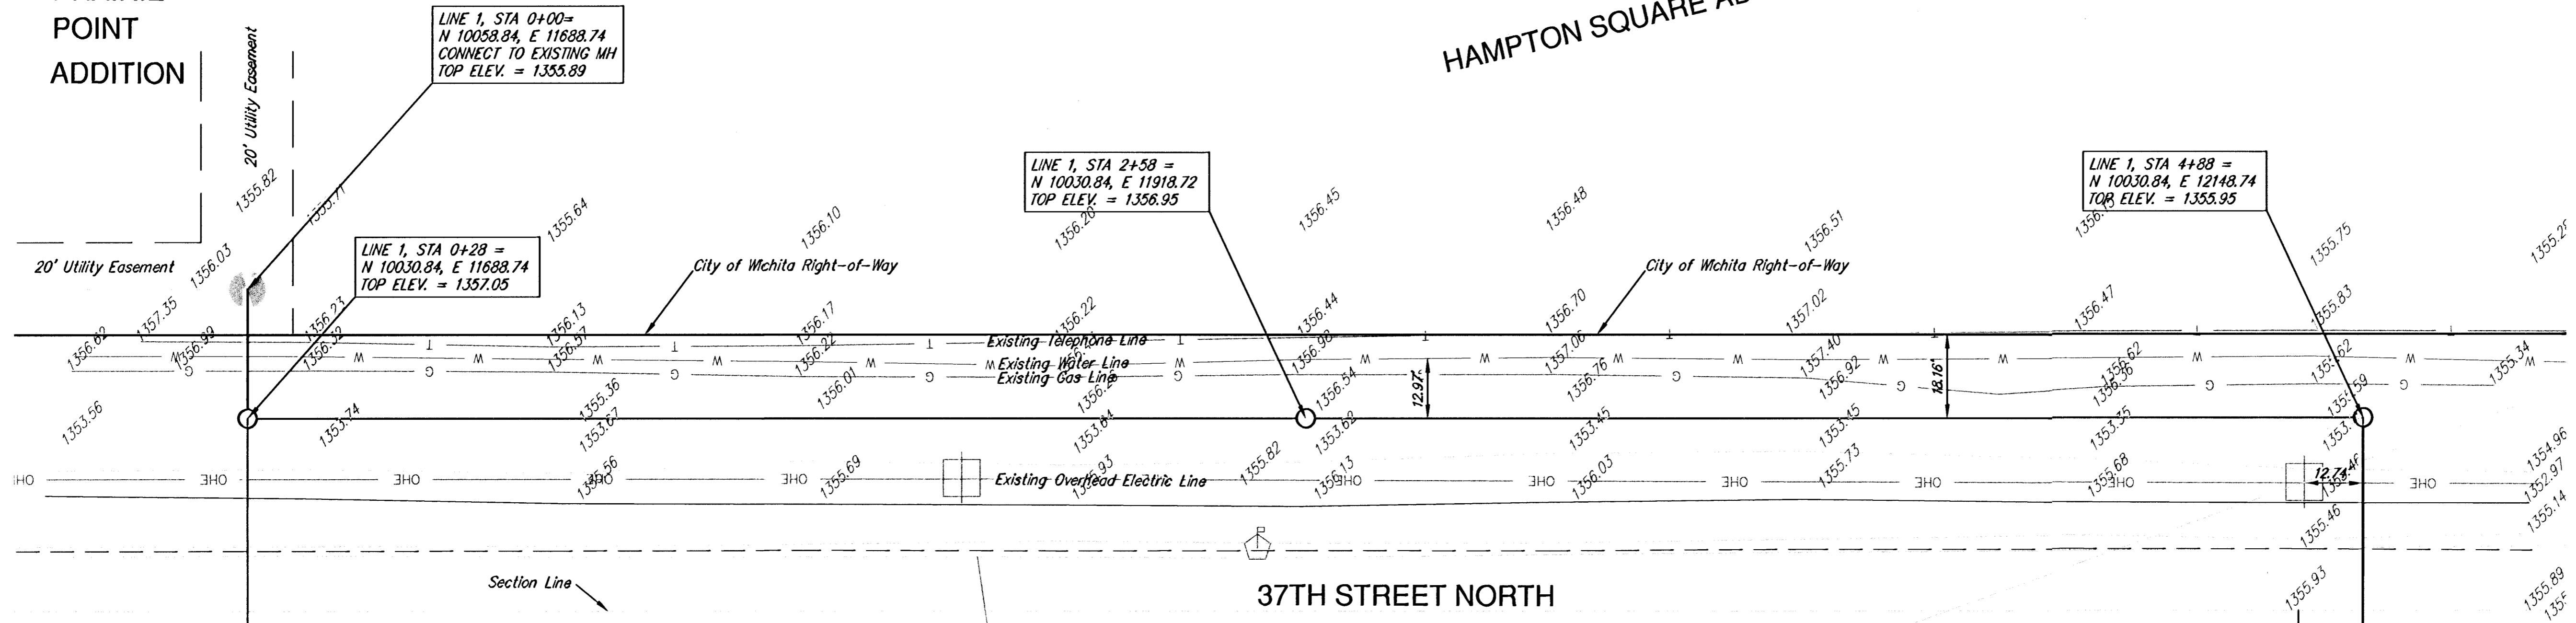

Per Plan  
15 R+B  
9-28-06  
SDR 35

DESIGN	TCR	DATE	April 6, 2006
DRAWN	RLS	REVIEW	
PROJECT NUMBER	1664 PPW (607861)		
DRAWING FILE	Base [SS]		
GOODWILL INDUSTRIES SANITARY SEWER PLAN & PROFILE WICHITA, KANSAS			
RB JOB	2839E		
SHEET	2 of 5		

**Ruggles & Bohm, P.A.**  
Engineering, Surveying, Land Planning  
924 North Main  
Wichita, Kansas 67203  
www.rbkansas.com  
(316) 264-8008  
(316) 264-4621 fax  
E-mail: info@rbkansas.com