
BENCHMARK:
CITY OF WICHITA DISC – MAIZE RD. & STERLING, (2400 BLOCK N.), TOP OF CURB, WEST END OF MEDIAN ON C OF STERLING.
61' E. OF C OF MAIZE RD.
ELEV. = 1353.57 NGVD29

SMALL RAILROAD SPIKE IN E. FACE OF POWER POLE, 34.6' S. & 6.9' W. OF THE NW COR. OF LOT 2, BLOCK A.
ELEV. = 1351.99 NGVD29

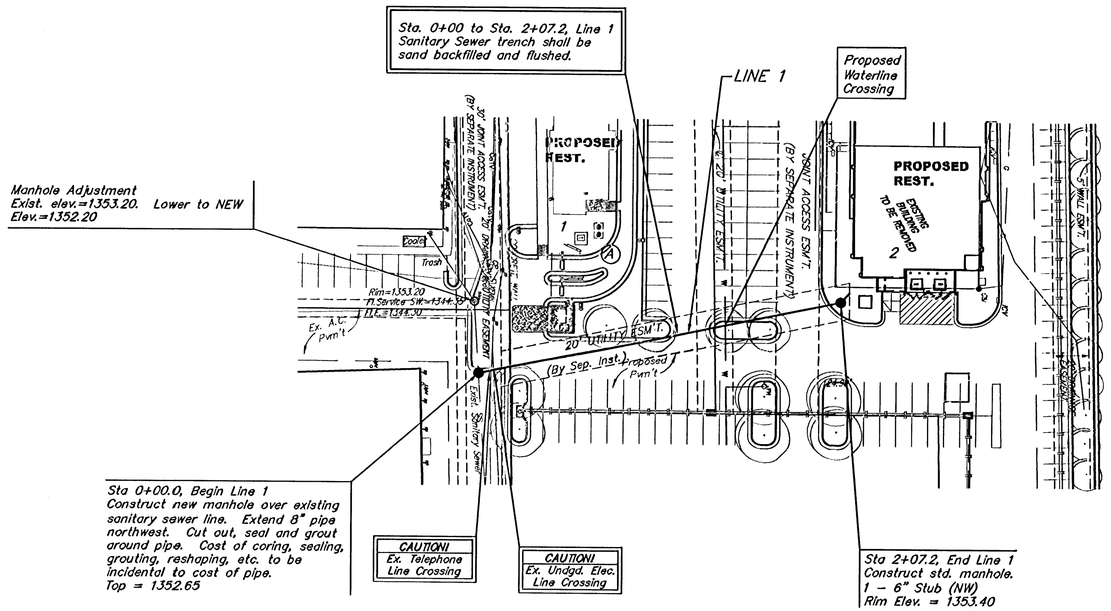


Scale: 1" = 40' Horizontal
1" = 5' Vertical
• = Iron

Sta. 0+00 to Sta. 2+07.2, Line 1 Sanitary Sewer trench shall be sand backfilled and flushed.

Existing Utilities on site should be disconnected prior to start of Construction. Contractor to verify and coordinate with General Contractor.

Contractor to remove trees, fence, signs, poles, etc. as needed for sanitary sewer construction. Removal of items shall be incidental to "Site Clearing and Restoration".

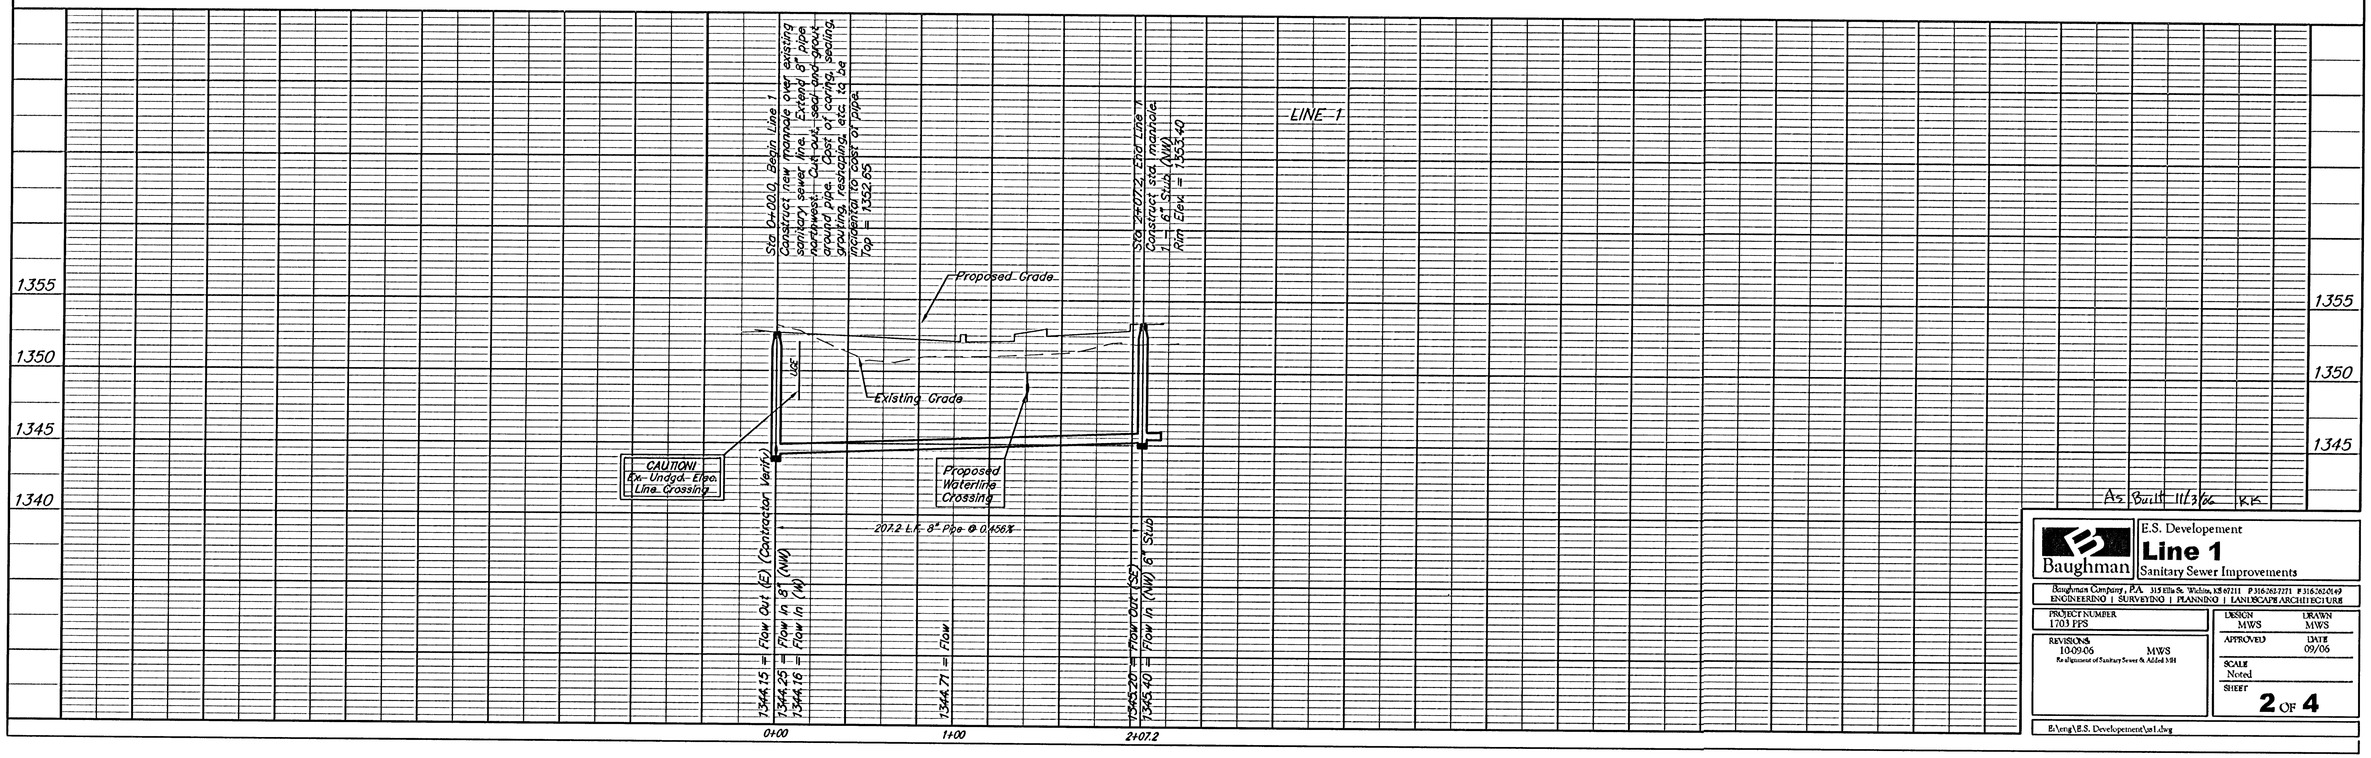

As Built 11/3/06 KS

Baughman

E.S. Developement
Line 1
Sanitary Sewer Improvements

Baughman Company, P.A. 315 Ellis St. Wichita, KS 67211 P 316.263.7271 F 316.262.0149
ENGINEERING | SURVEYING | PLANNING | LANDSCAPE ARCHITECTURE

PROJECT NUMBER 1703 FPS

DESIGN MWS | DRAWN MWS

REVISIONS 10-09-06 MWS Re-alignment of Sanitary Sewer & Added 3-91

APPROVED | DATE 09/06

SCALE Noted

SHEET **2** OF **4**

E:\eng\E.S. Developement\sn1.dwg