PRIVATE STORM WATER SEWER EXTENSION

TO SERVE


INTRUST BANK WESTLAKE CENTER

PART OF LOT 2, BLOCK A, THUNDERBIRD OFFICE PARK


PRIVATE PROJECT NO. 1729 PPS (607861)

CITY OF WICHITA, KANSAS

JAMES L. ARMOUR, P.E. - CITY ENGINEER

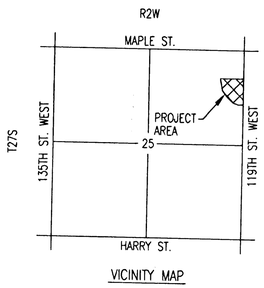

VICINITY MAP

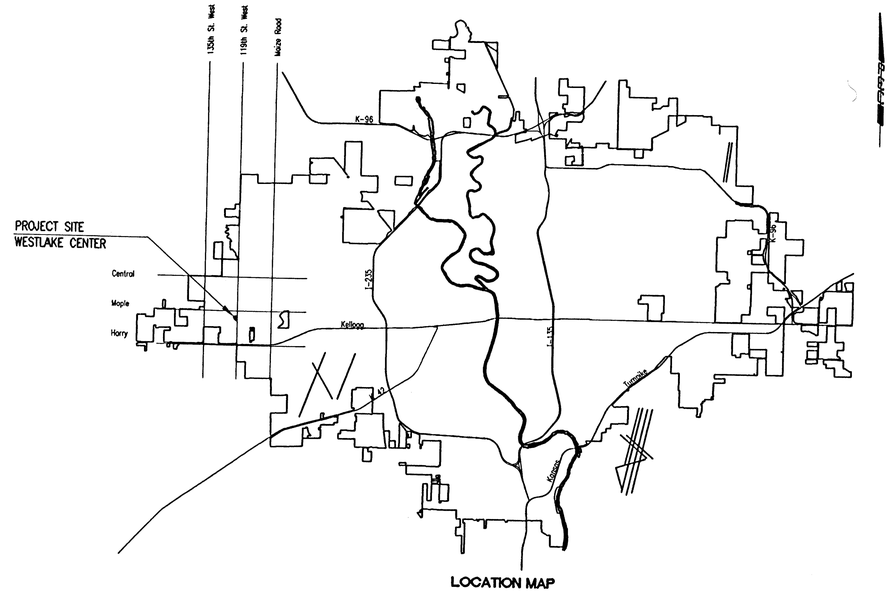

LOCATION MAP

INDEX OF SHEETS

SHEET NO. 1	TITLE SHEET
SHEET NO. 2	KEY MAP AND GENERAL NOTES
SHEET NO. 3	PLAT
SHEET NO. 4	PLAN/PROFILE
SHEET NO. 5	TYPE 1 CURB INLET DETAILS
SHEET NO. 6-9	SOIL EROSION BMP DETAILS

SEE SUPPLEMENTAL SHEETS C-1.5 AND C-1.7 FOR GRADING AND SWPP PLAN.

APPROVED AS NOTED
By CITY ENGINEER OF WICHITA

Sanitary Sewers _____

Storm Sewers dgh 11/21/06

Driveway Approaches _____

Paving _____

NOTE TO CONTRACTOR

INSPECTION AND TESTING FOR THIS PROJECT IS TO BE PROVIDED BY A LICENSED CONSULTING ENGINEERING FIRM CONTRACTED BY THE OWNER/DEVELOPER. SAID INSPECTION TO BE IN ACCORDANCE WITH THE CITY OF WICHITA STANDARD CONSTRUCTION ENGINEERING PRACTICES AND CERTIFIED BY A LICENSED PROFESSIONAL ENGINEER. NO WORK SHALL BE PERFORMED IN DEDICATED EASEMENTS OR PUBLIC RIGHT-OF-WAY BY THE CONTRACTOR UNTIL SUCH INSPECTION IS ARRANGED FOR AND REQUIRED BONDS HAVE BEEN SUBMITTED TO AND APPROVED BY THE CITY NOR SHALL ANY WORK BE COMMENCED IN DEDICATED EASEMENTS OR PUBLIC RIGHT-OF-WAY WITHOUT WRITTEN AUTHORIZATION BY THE CITY ENGINEER. IMPROVEMENTS PERFORMED UNDER THIS PROJECT SHALL NOT BE ACCEPTED BY THE CITY UNTIL ALL APPLICABLE DOCUMENTATION HAS BEEN SUBMITTED TO THE CITY ENGINEER. THIS MAY INCLUDE: RECORD DRAWINGS, INSPECTION LOGS, TEST DOCUMENTATION, TV TAPES, AND A CERTIFICATE OF COMPLETION. THE ABOVE SHALL BE PERFORMED BY THE CONSULTING FIRM CONTRACTED TO INSPECT THIS PROJECT.

AS-BUILT
3/29/07
Data I.C.E. Miller
Signed

NOVEMBER 2006

PLANS PREPARED BY

PROFESSIONAL ENGINEERING CONSULTANTS, P.A.

ENGINEERS

WICHITA, KANSAS

DWAYNE RUMSEY A.I.A.
ARCHITECT
322 LAURA · WICHITA, KS 67211 · 316-262-0011

DAVID W. HERRINGTON
LICENSED
16758
11-20-06
KANSAS
PROFESSIONAL ENGINEER

A NEW BRANCH BANK
INTRUST BANK
WESTLAKE CENTER
405 S. 119th STREET
WICHITA, KANSAS

date: NOV. 20, 2006

project: 2410

C-2.1

OF SEVENTEEN

Professional Engineering Consultants, P.A.
303 S. TOPEKA • WICHITA, KANSAS 67202 • 316-262-2691 • FAX 316-262-3003
www.pec1.com

Saved 11-21-2006 2:36:14 PM by JAN
Plot Scale 1:1 11-21-2006 2:37:37 PM by JAN
Q:\2006\06801\PPS\06801-C- SWSTITLE