



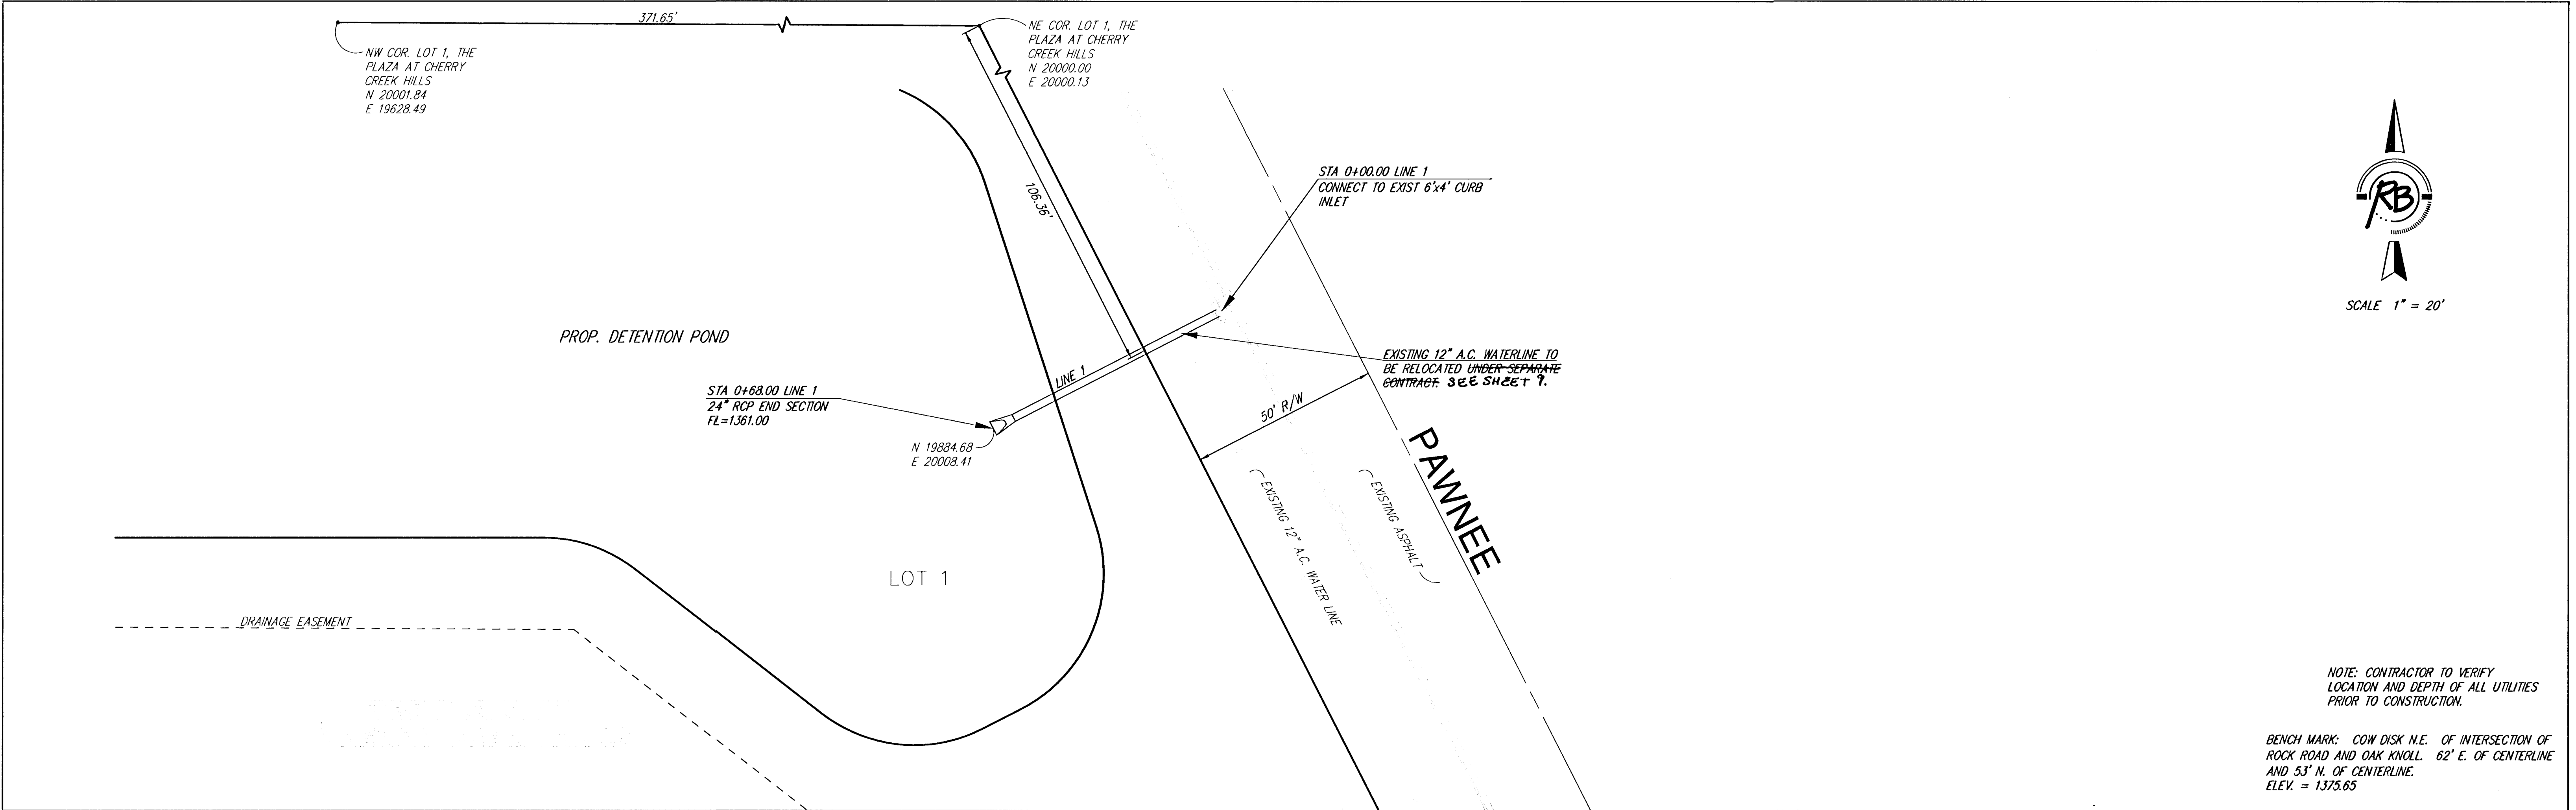

SCALE 1" = 20'

NOTE: CONTRACTOR TO VERIFY LOCATION AND DEPTH OF ALL UTILITIES PRIOR TO CONSTRUCTION.

BENCH MARK: COW DISK N.E. OF INTERSECTION OF ROCK ROAD AND OAK KNOLL. 62' E. OF CENTERLINE AND 53' N. OF CENTERLINE. ELEV. = 1375.65

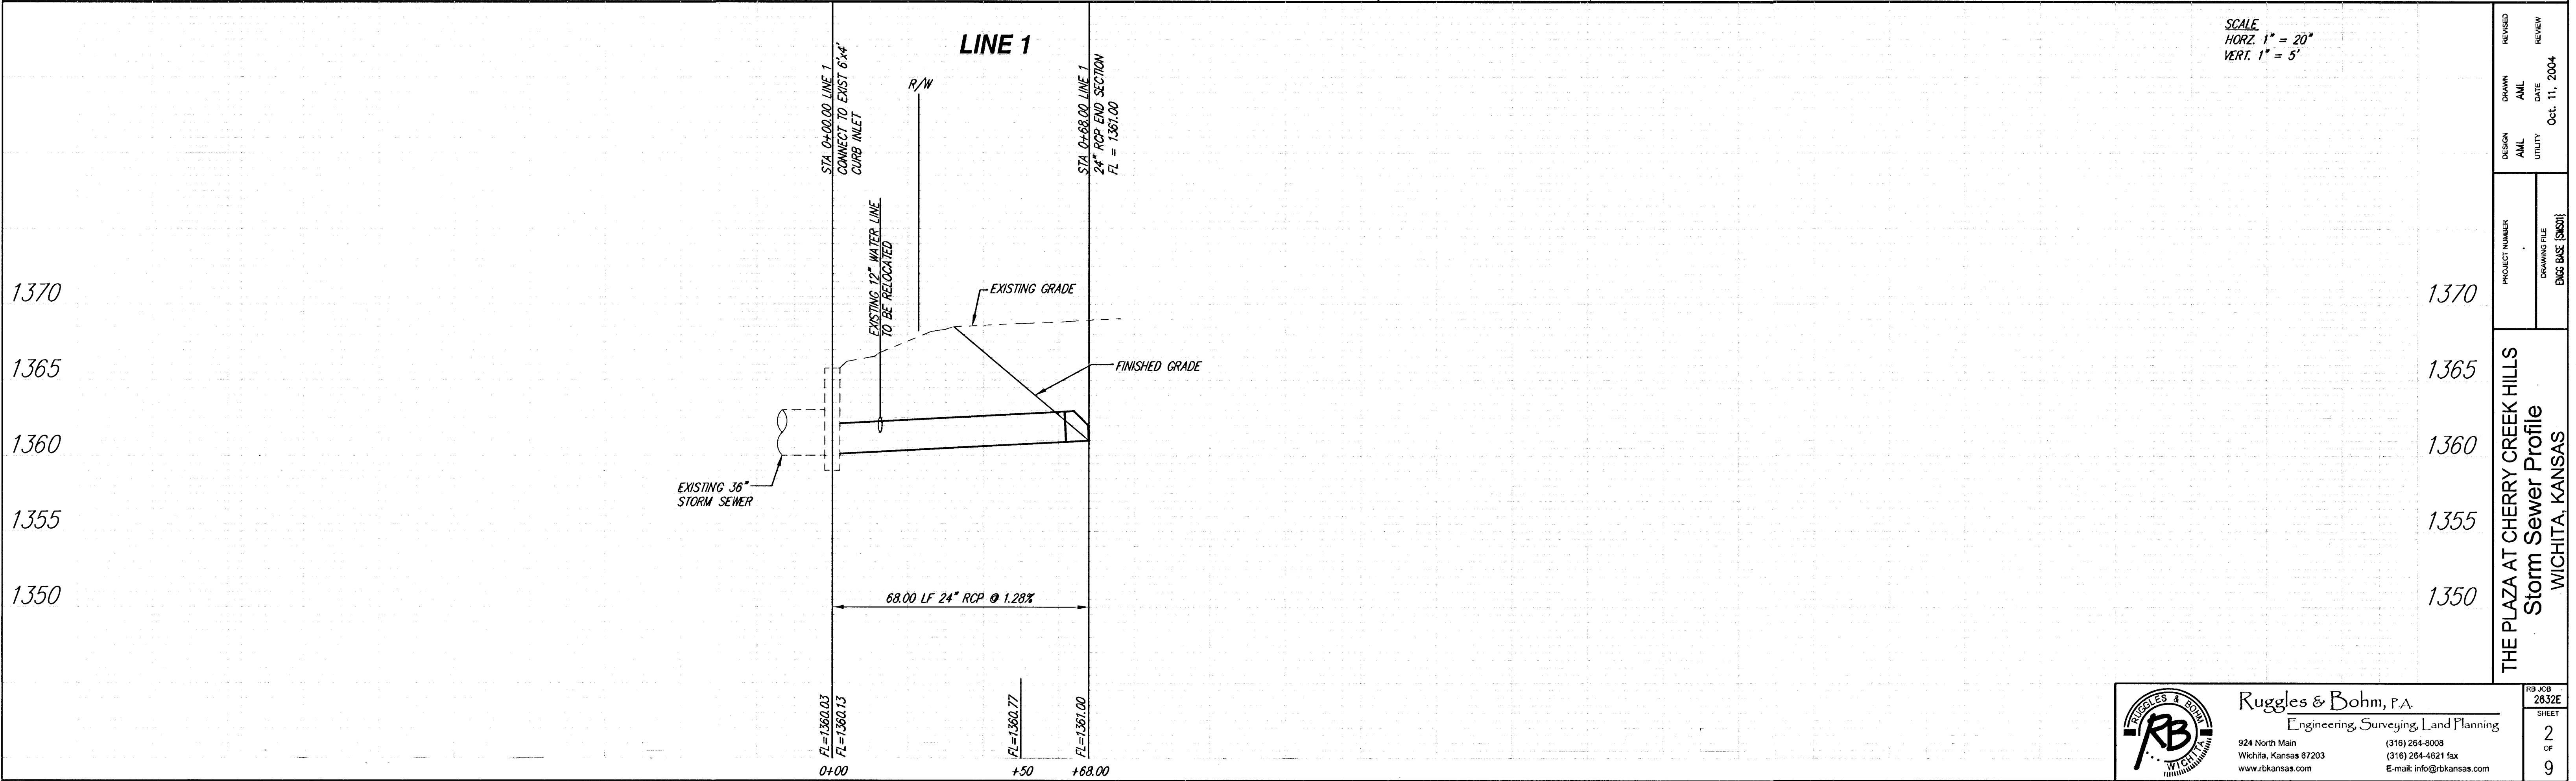


SCALE
HORZ. 1" = 20'
VERT. 1" = 5'

DESIGN	DRAWN	REVIEWED
AML	AML	AML
UTILITY	DATE	REVIEW
	Oct 11, 2004	

PROJECT NUMBER	DRAWING FILE
	ENG BASE (S&S)

THE PLAZA AT CHERRY CREEK HILLS
Storm Sewer Profile
WICHITA, KANSAS

RB JOB	2632E
SHEET	2
OF	9

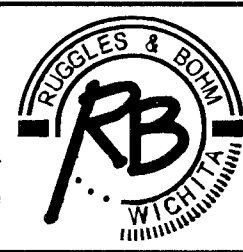

Ruggles & Bohm, P.A.
Engineering, Surveying, Land Planning
924 North Main
Wichita, Kansas 67203
www.rbkansas.com
(316) 264-8008
(316) 264-4621 fax
E-mail: info@rbkansas.com