


Benchmark:
City Disc In T.C. Adj. to F.H.
38' South of intersection of
Onewood and Auburn Hills.
Elev. = 178.48 (City Datum)

"□" cut in south curb of
Onewood 272' west of C.L.
Auburn Hills.
Elev. = 179.73 (City Datum)



Scale: 1" = 40' Horizontal
1" = 5' Vertical
• = Iron

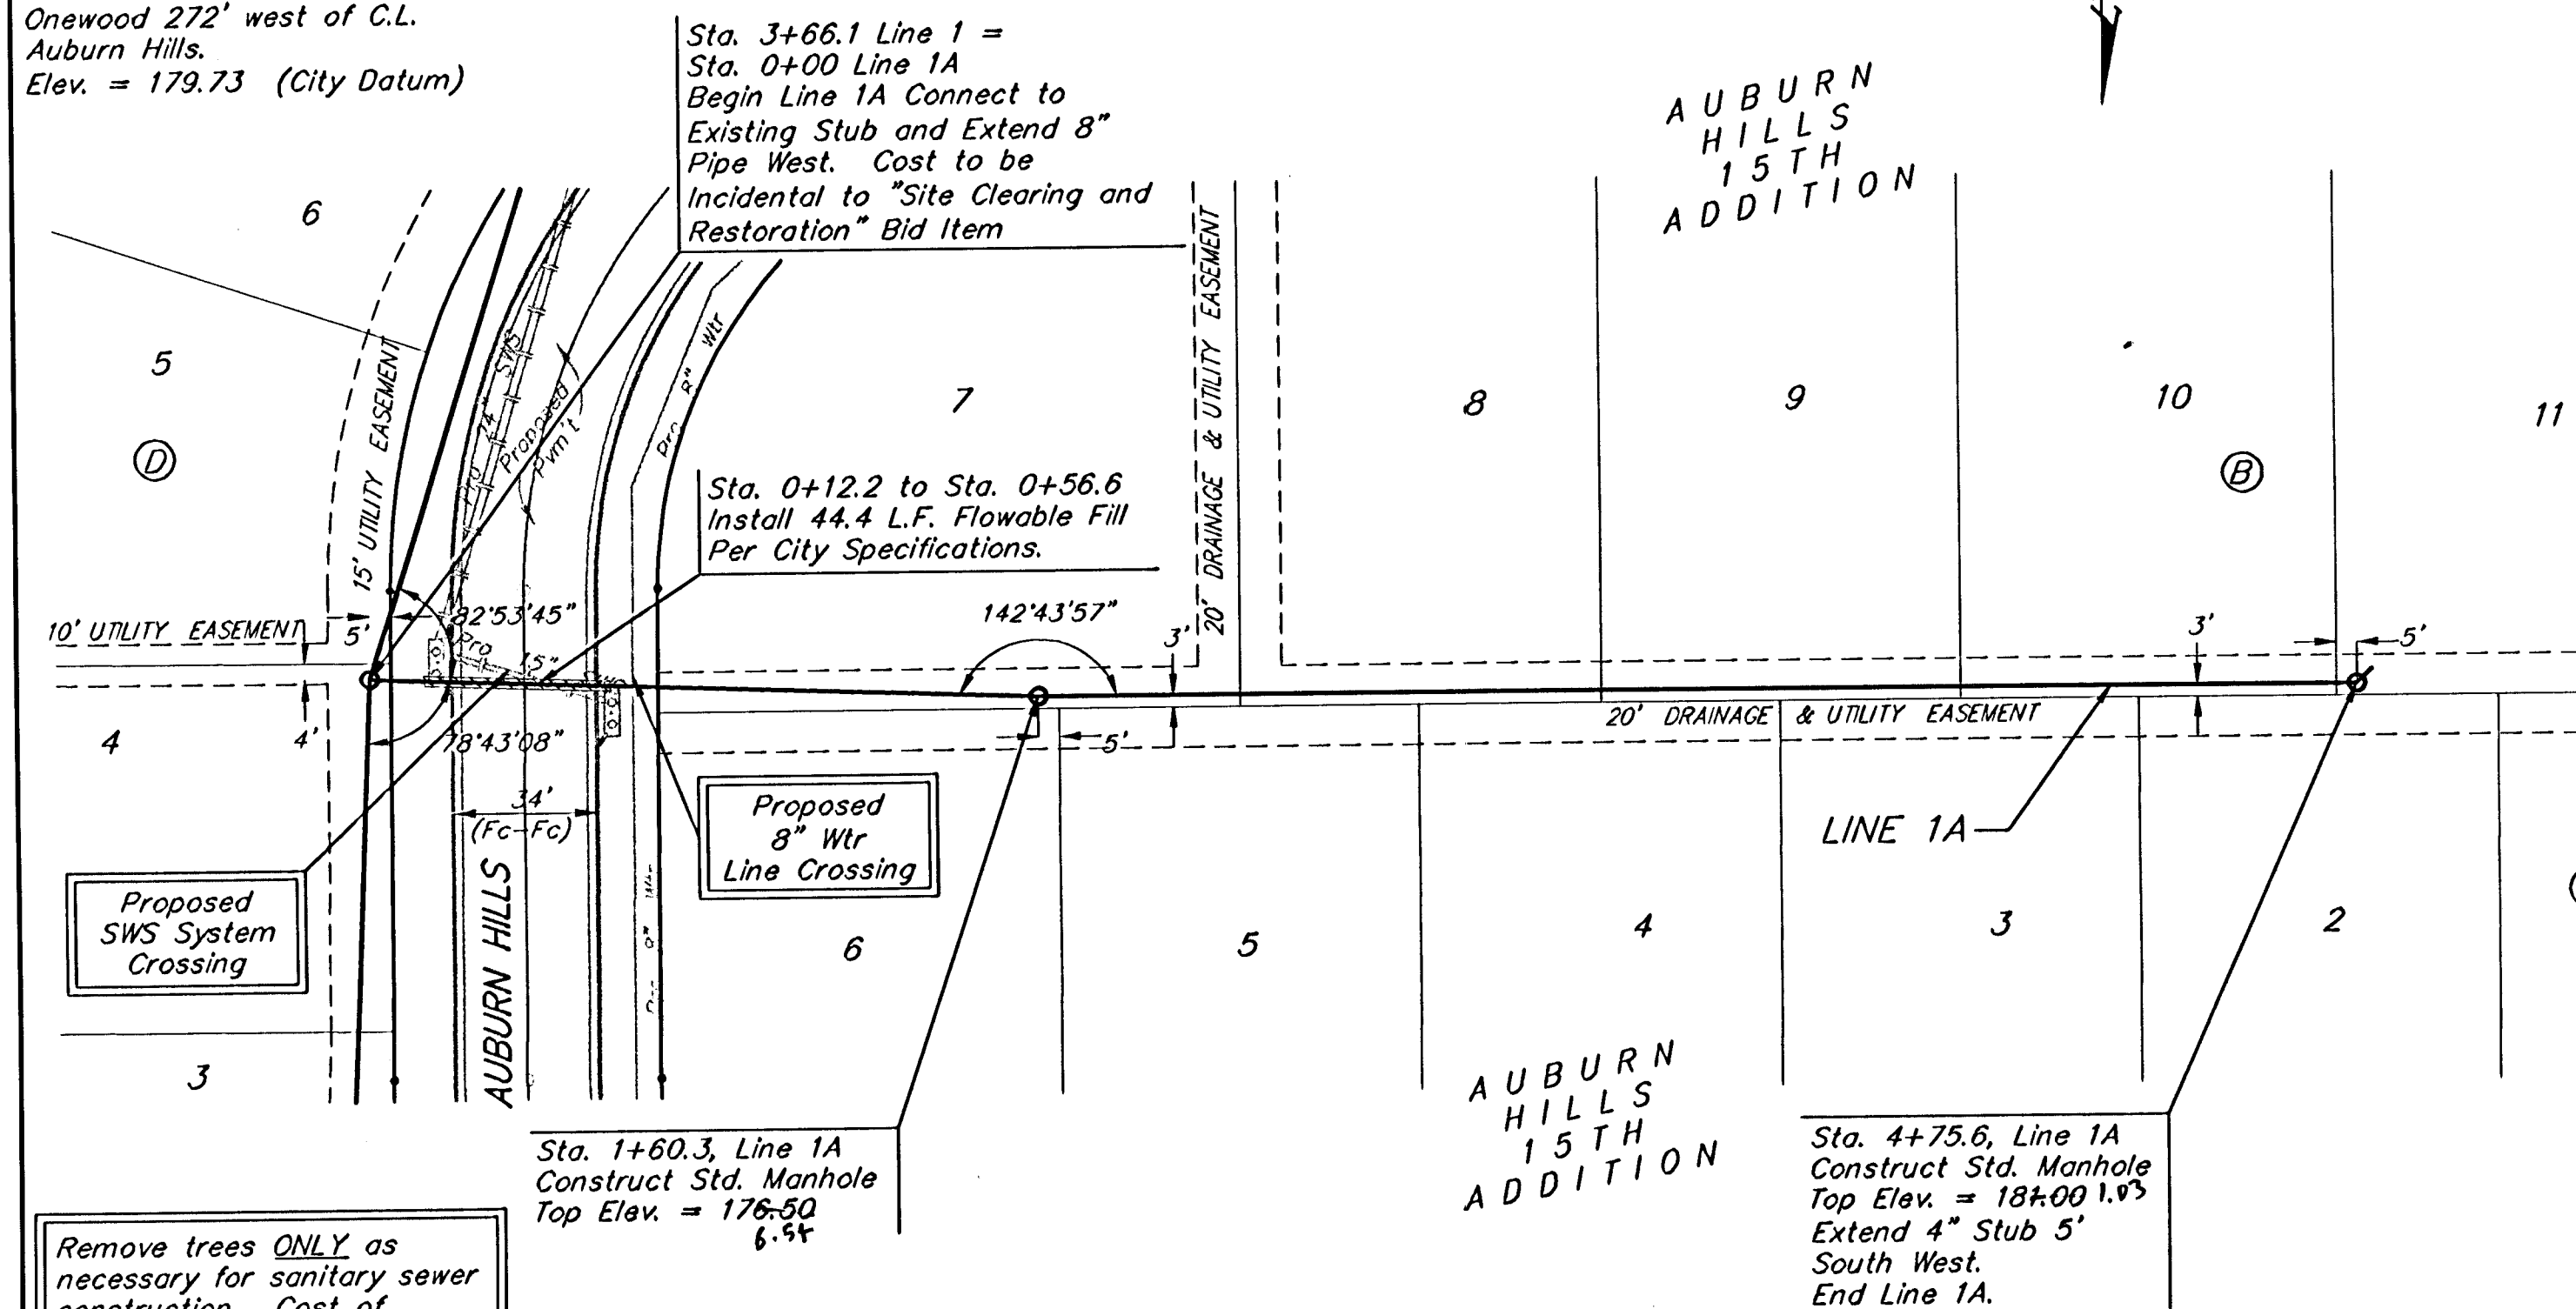

Remove trees ONLY as necessary for sanitary sewer construction. Cost of removal to be incidental to lump sum bid item "Site Clearing & Restoration".

Remove trees ONLY as necessary for sanitary sewer construction. Cost of removal to be incidental to lump sum bid item "Site Clearing & Restoration".

The contractor shall be required to backfill trench with sand from Sta. 0+00 to Sta. 3+20.0, Line 2 excluding locations where flowable fill is called out. All costs shall be subsidiary to pipe cost.

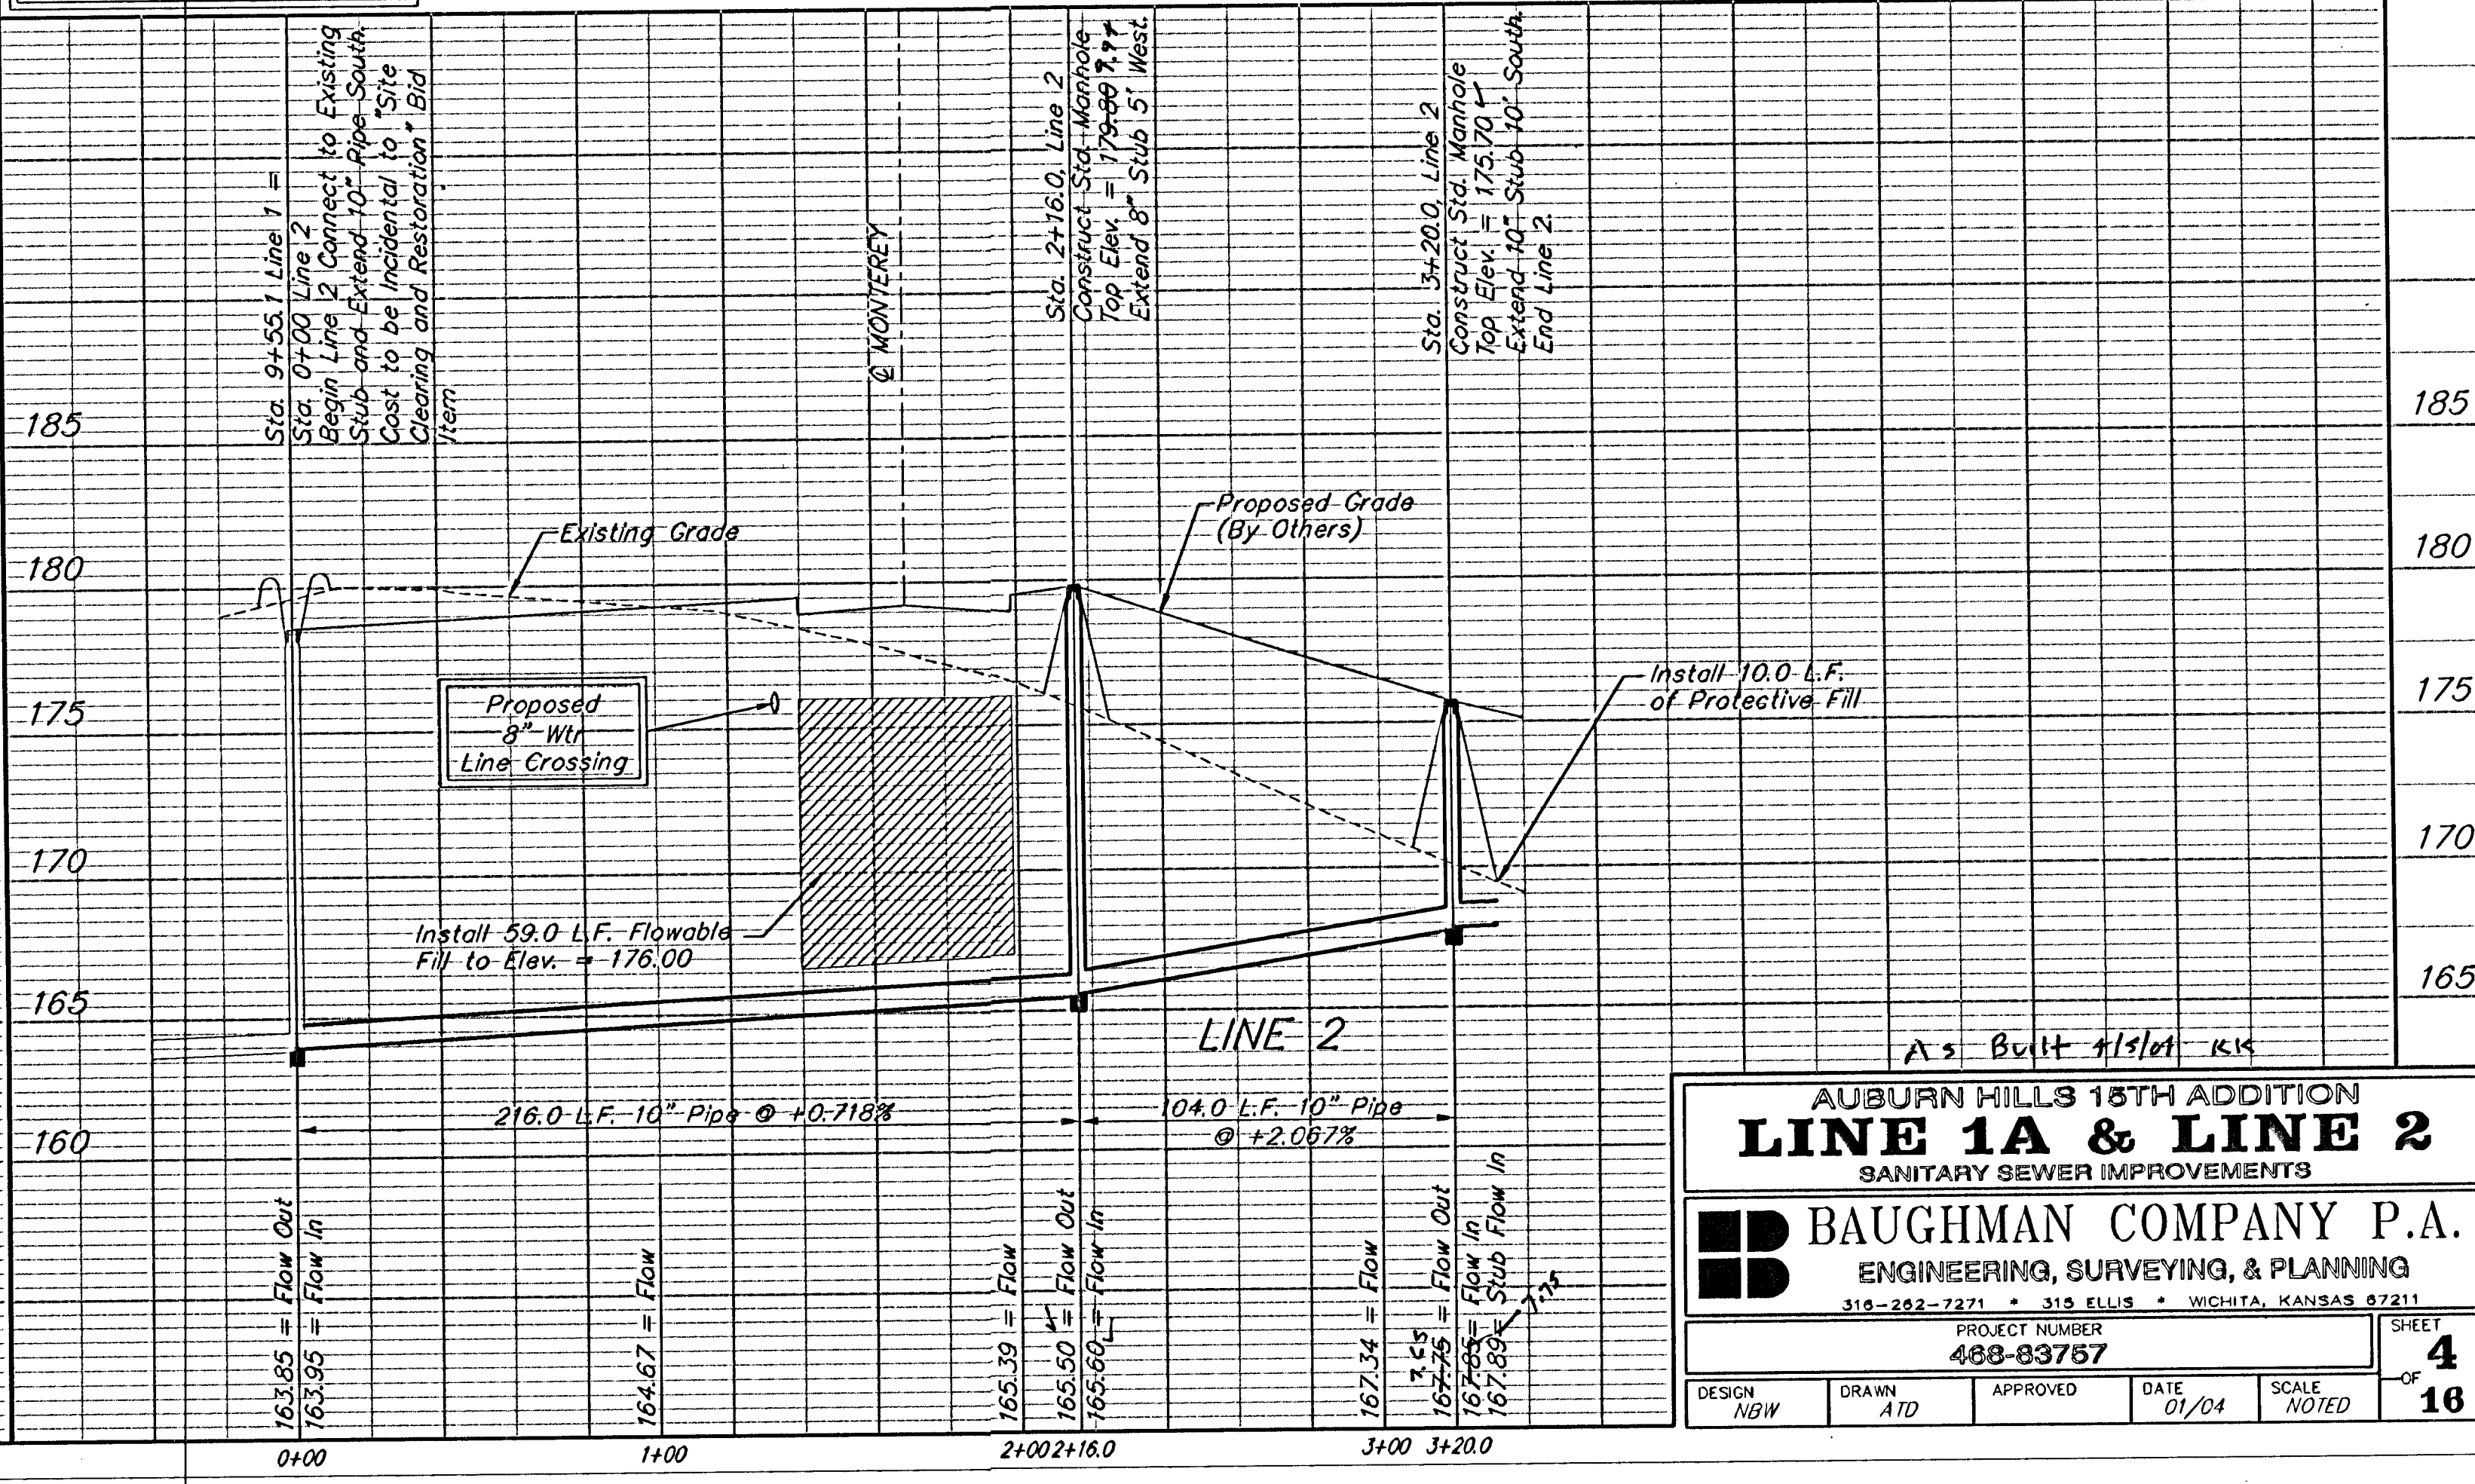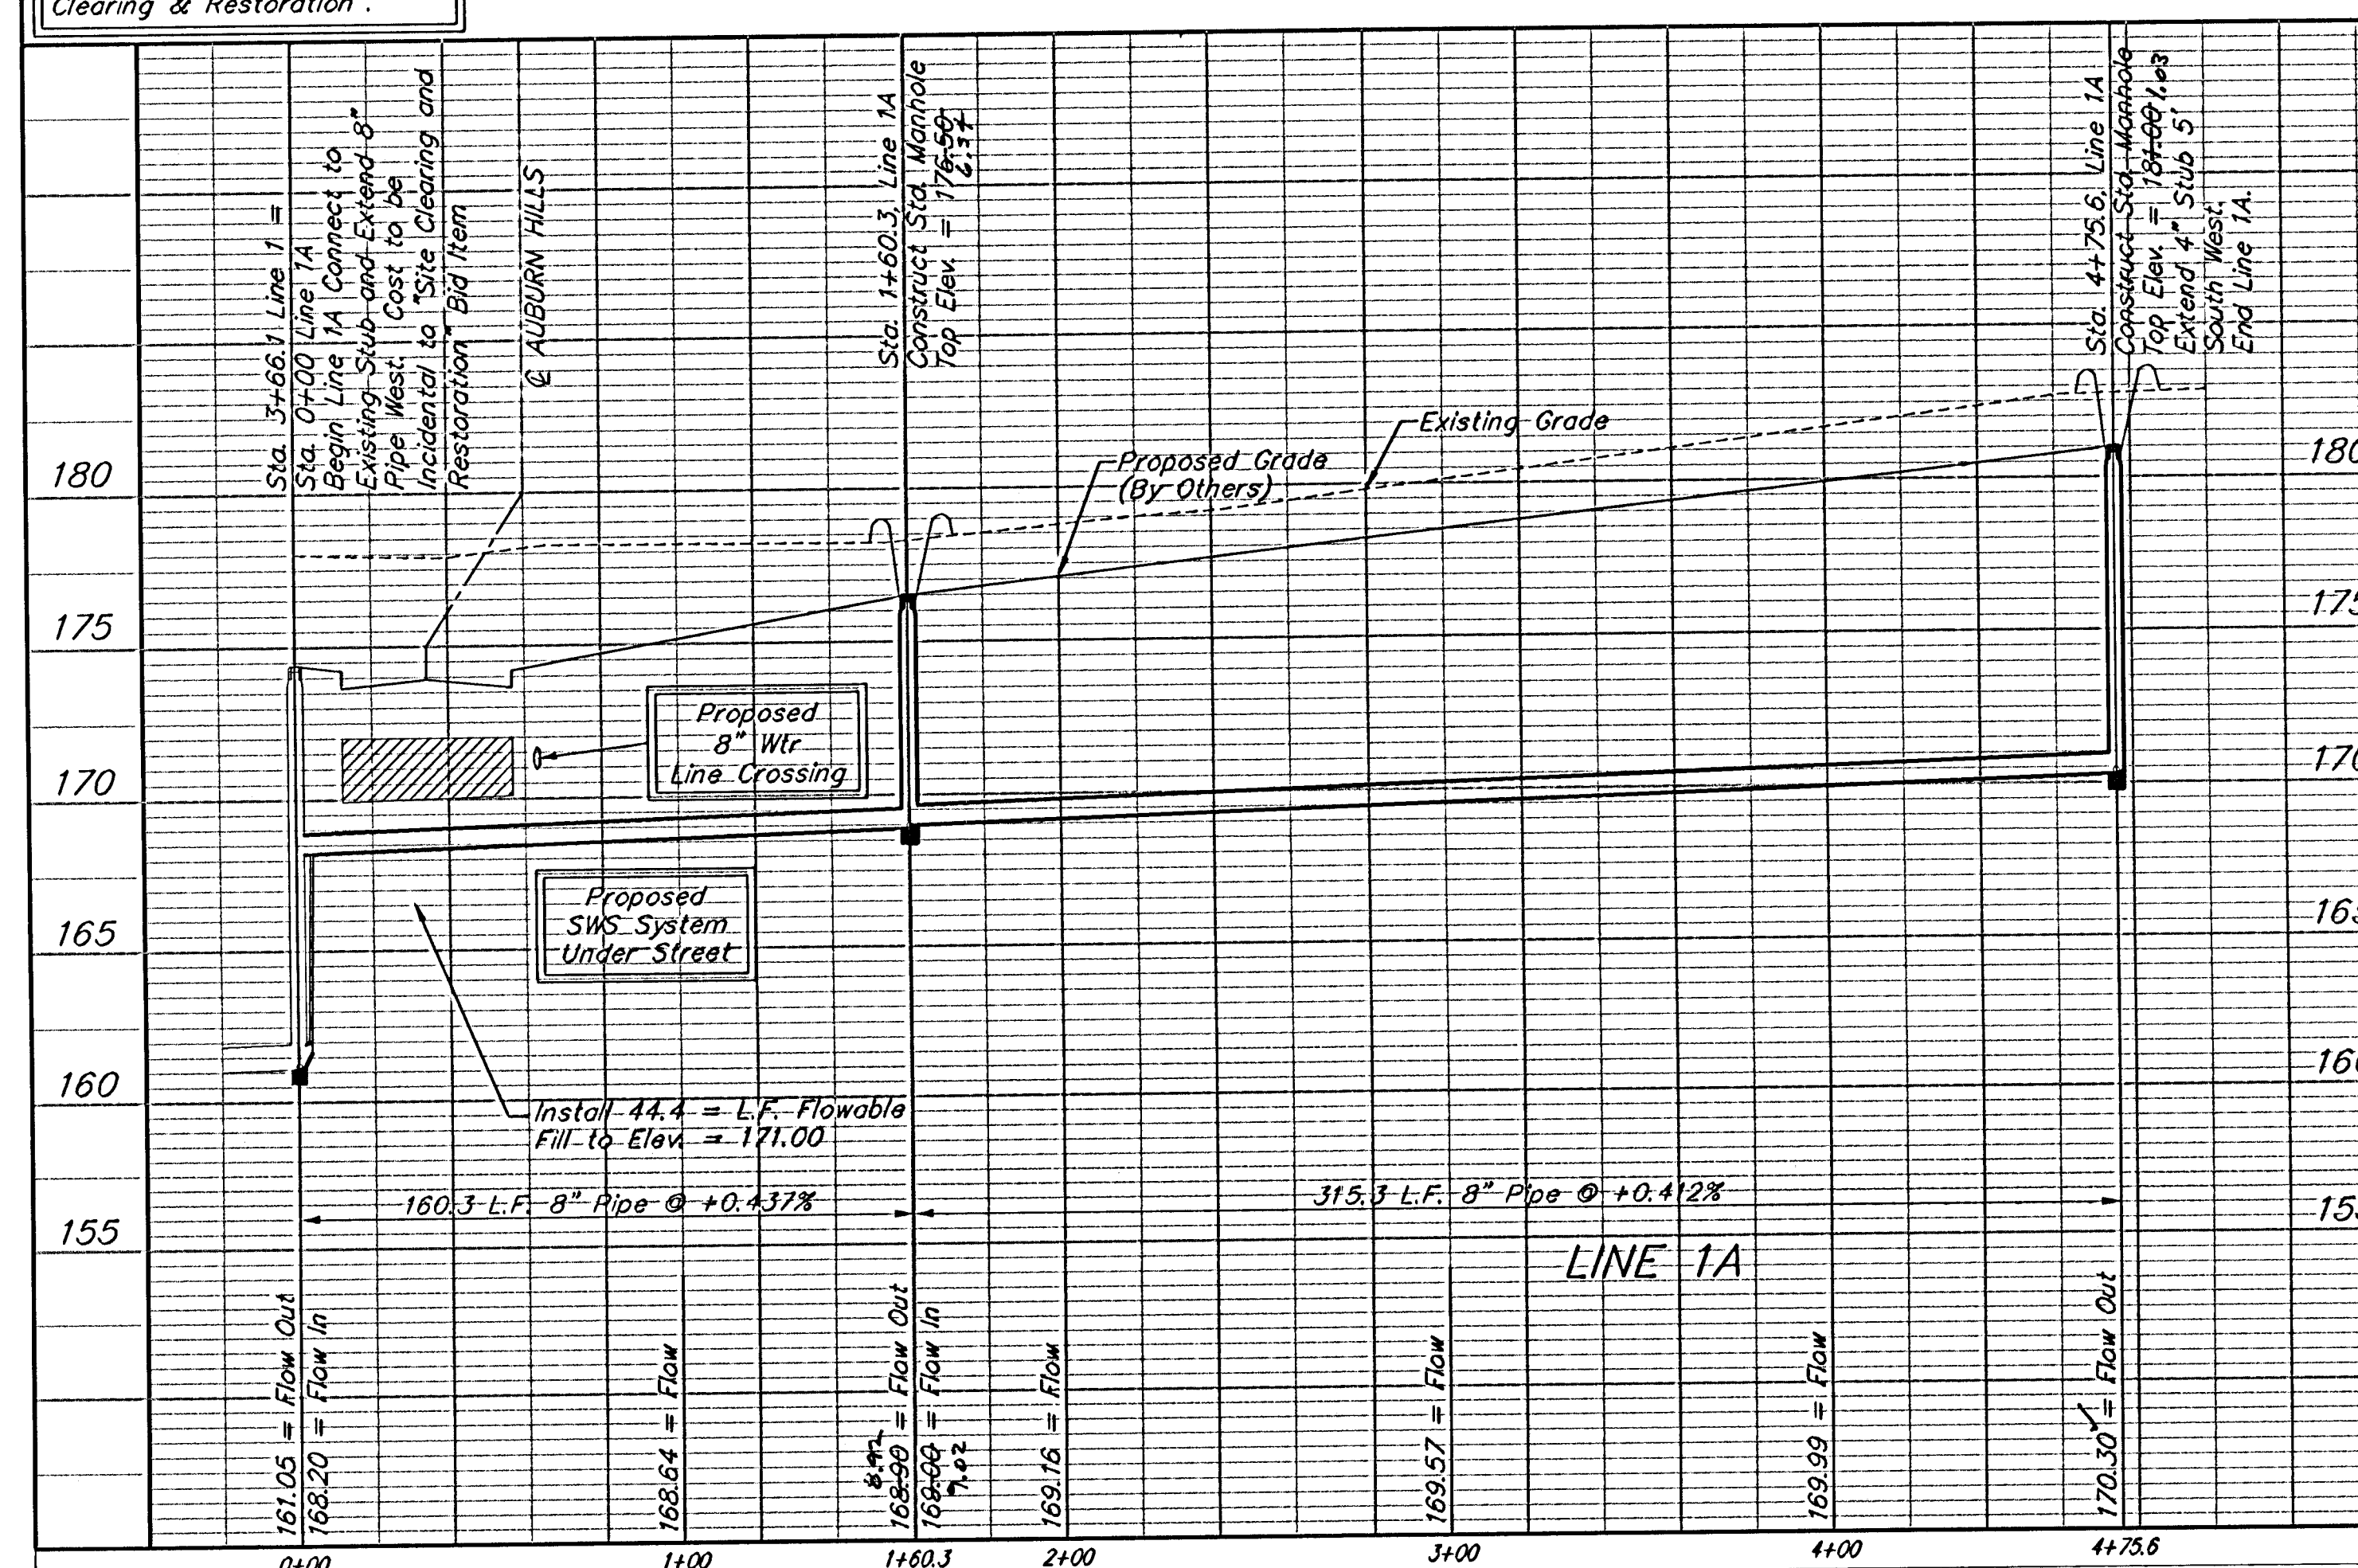

AUBURN HILLS 15TH ADDITION
LINE 1A & LINE 2
SANITARY SEWER IMPROVEMENTS
BAUGHMAN COMPANY P.A.
ENGINEERING, SURVEYING, & PLANNING
DESIGN NBW DRAWN ATD APPROVED DATE 01/04 SCALE NOTED
SHEET **4** OF **16**