


Benchmark:
City Disc In T.C. Adj. to F.H.
38' South of intersection of
Onewood and Auburn Hills.
Elev. = 178.48 (City Datum)
"□" cut in south curb of
Onewood 272' west of C.L.
Auburn Hills.
Elev. = 179.73 (City Datum)


Sta. 2+16.0 Line 2 =
Sta. 0+00 Line 2A
Begin Line 2A Connect to Existing
Stub and Extend 8" Pipe West.
Cost to be Incidental to "Site
Clearing and Restoration" Bid Item

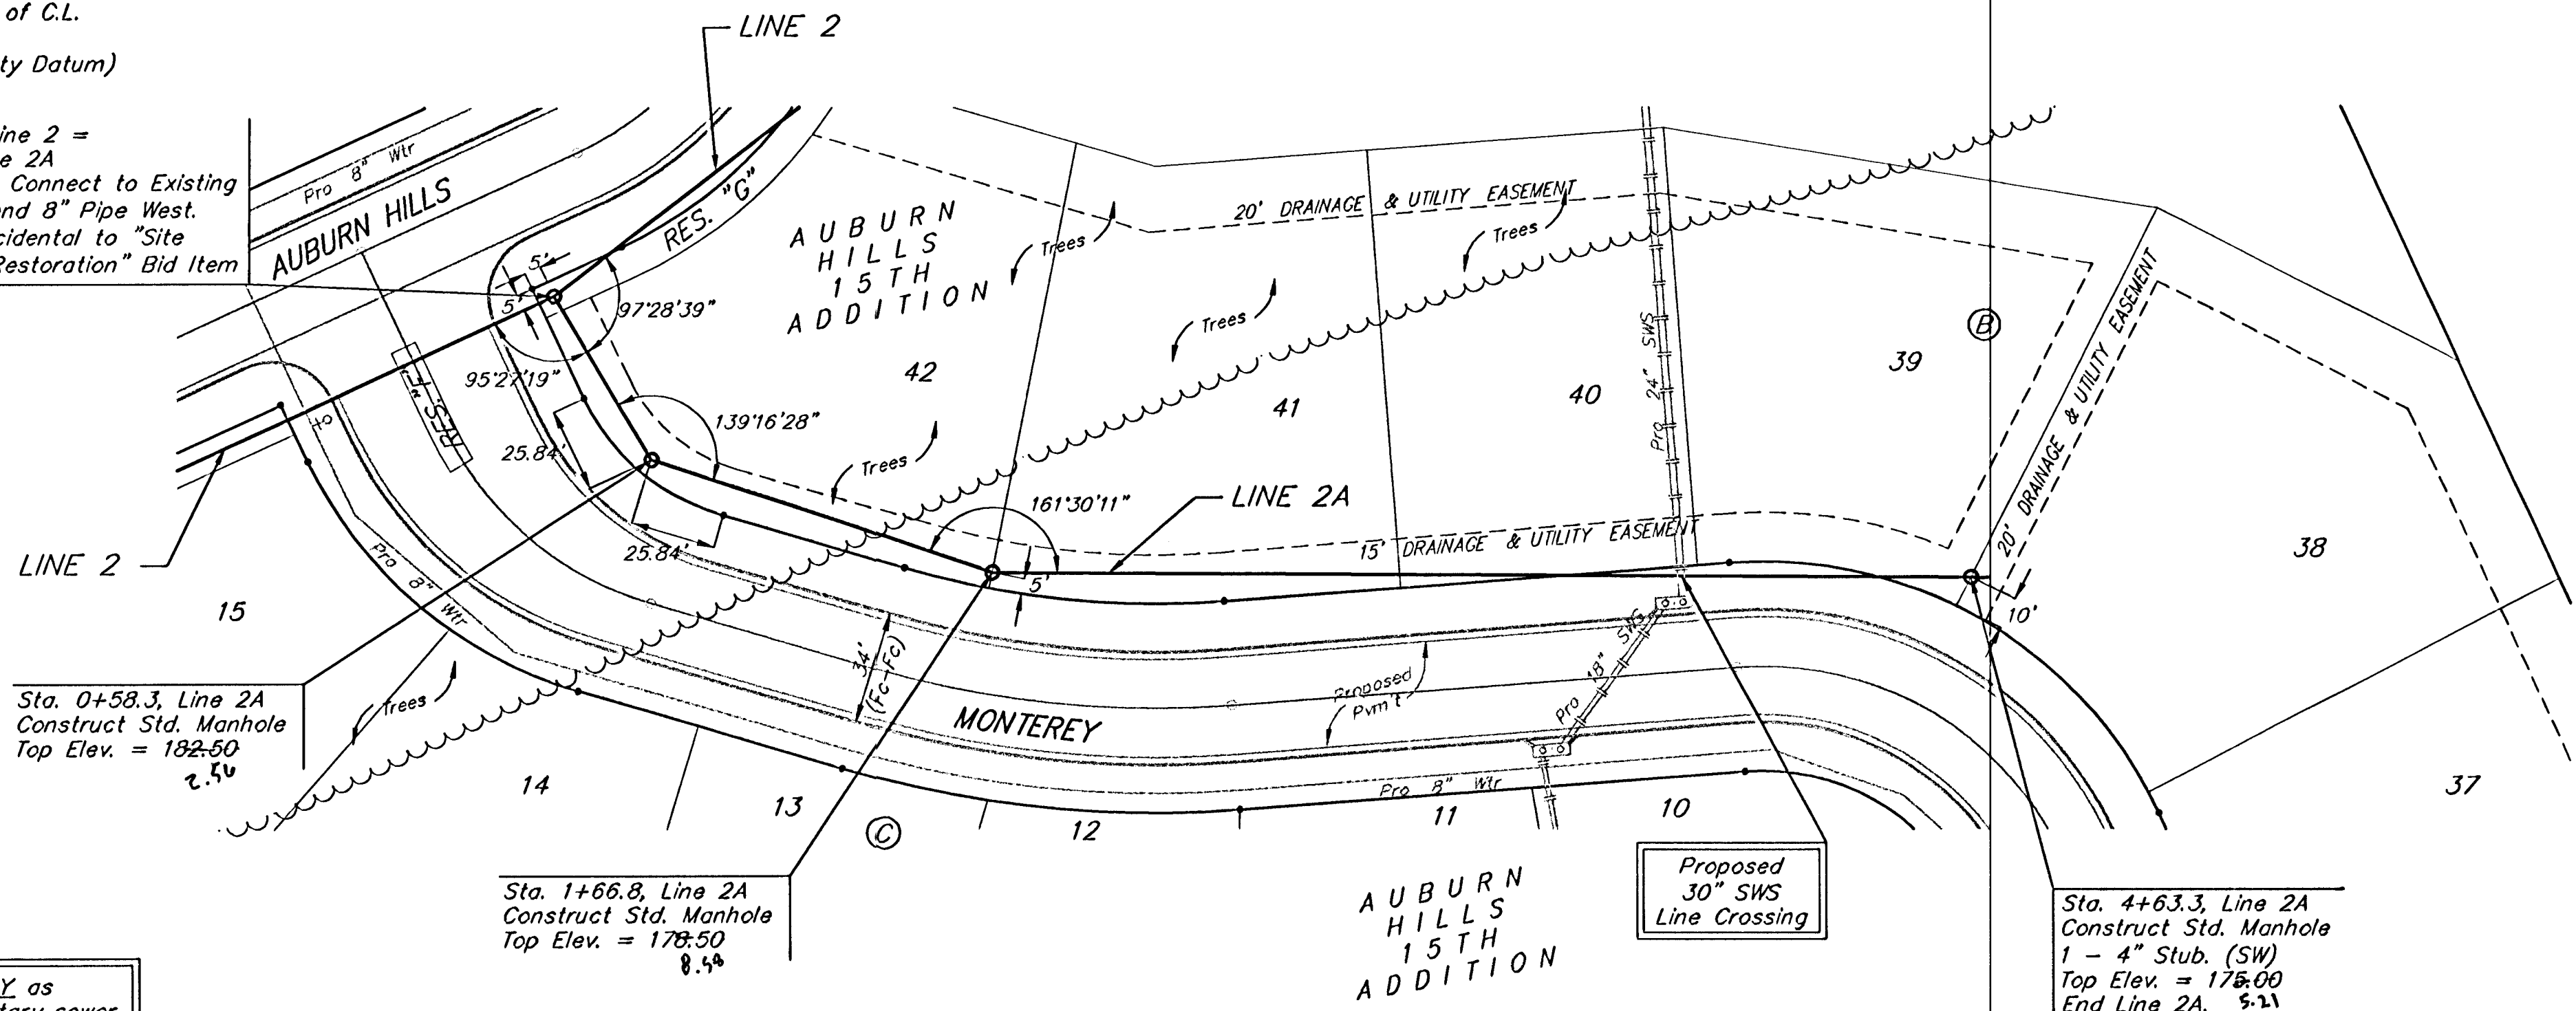


Scale: 1" = 40' Horizontal
1" = 5' Vertical
• = Iron

Scale: 1" = 40' Horizontal
1" = 5' Vertical
• = Iron


Sta. 0+00, Begin Line 3
Connect to Existing Stub and
Extend 8" Pipe West. Cost to
be Incidental to "Site Clearing
and Restoration" Bid Item

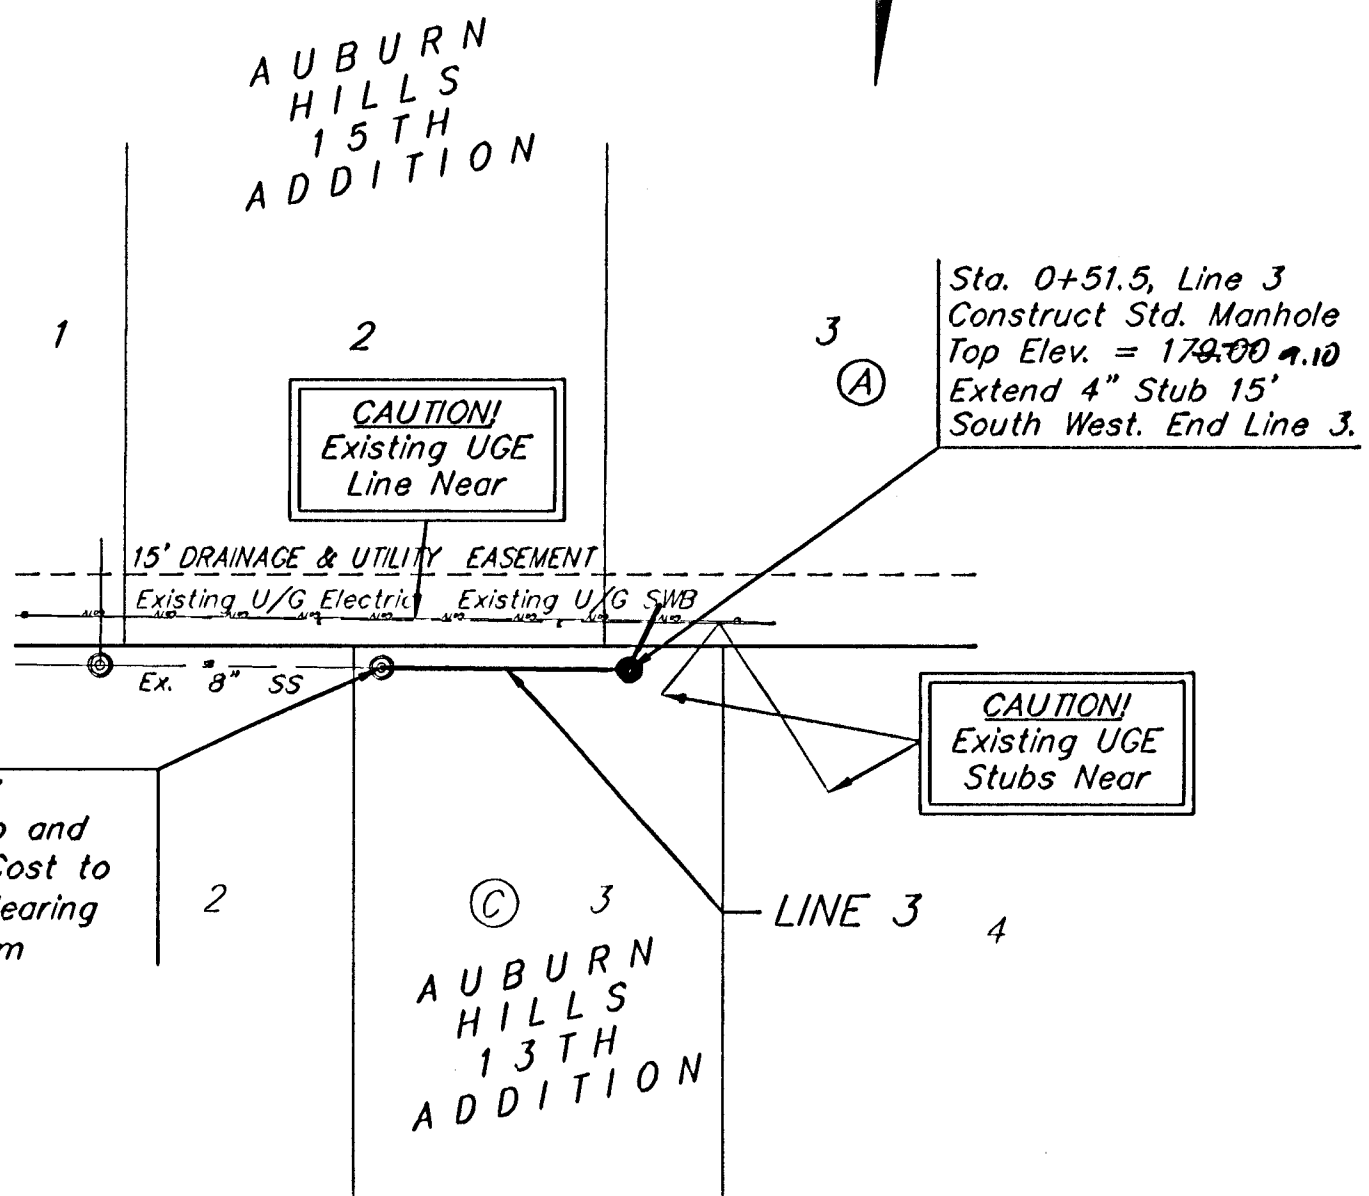

Remove trees ONLY as
necessary for sanitary sewer
construction. Cost of
removal to be incidental to
lump sum bid item "Site
Clearing & Restoration".

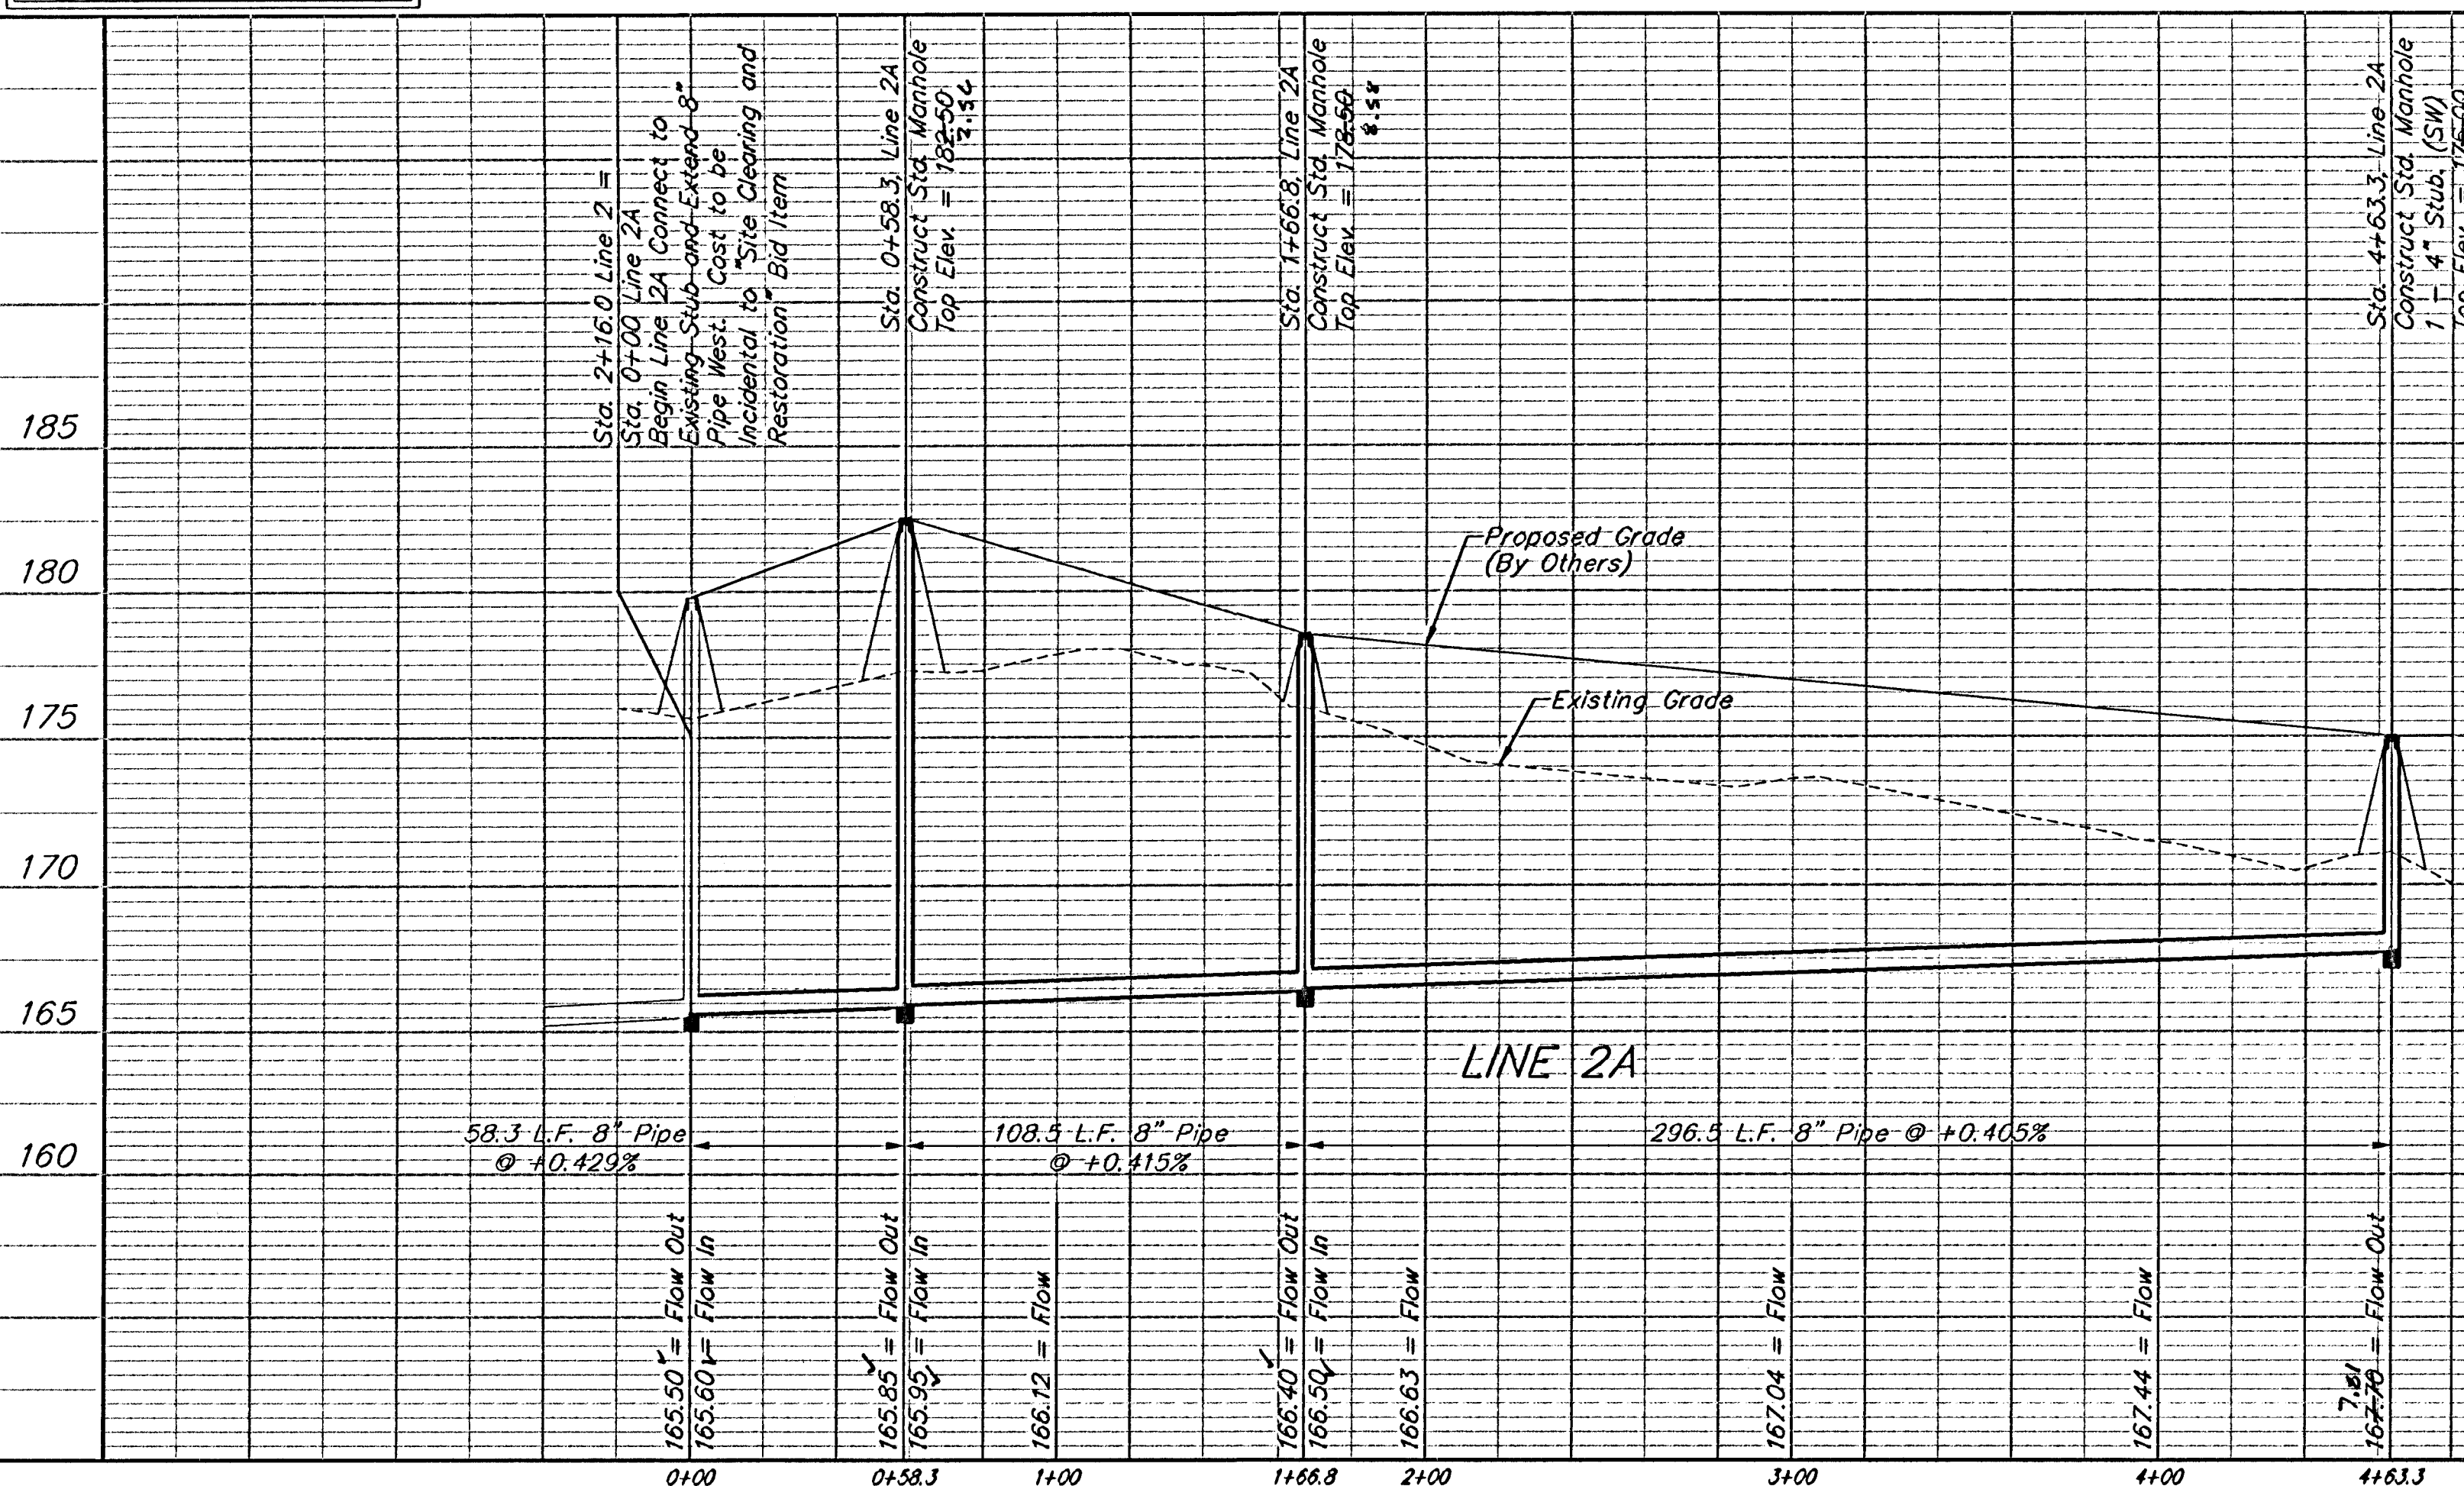

185
180
175
170
165
160

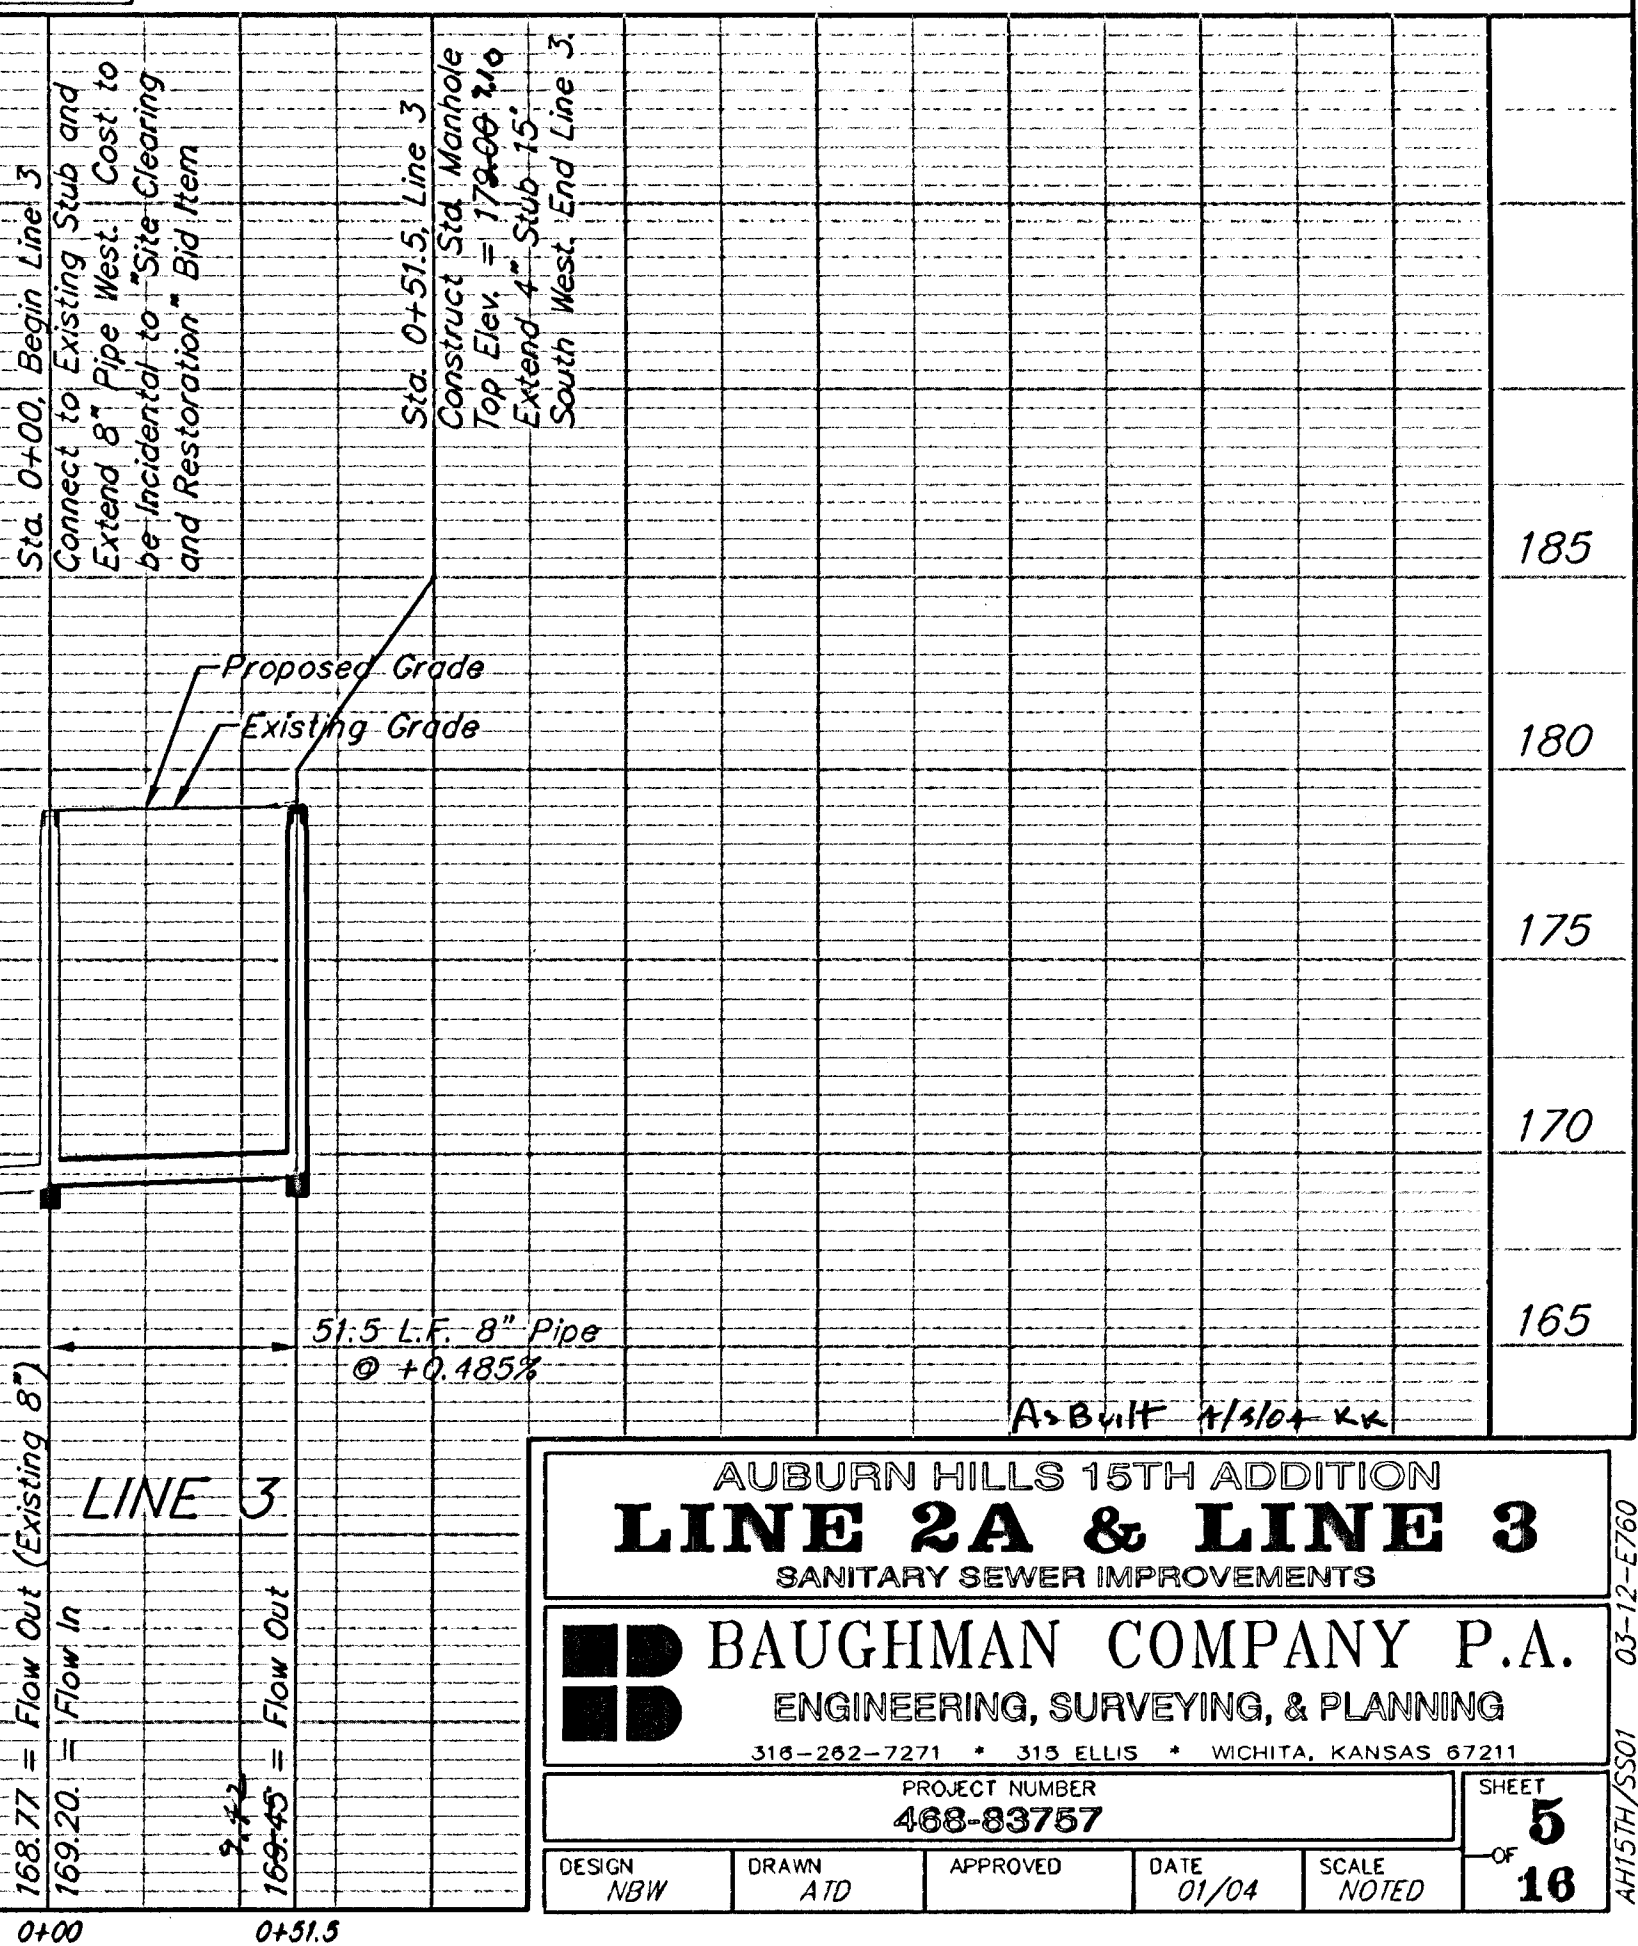

185
180
175
170
165
160

AUBURN HILLS 15TH ADDITION
LINE 2A & LINE 3
SANITARY SEWER IMPROVEMENTS
BAUGHMAN COMPANY P.A.
ENGINEERING, SURVEYING, & PLANNING
PROJECT NUMBER
SHEET
5
OF
16
DESIGN
NBW
DRAWN
ATD
APPROVED
DATE
01/04
SCALE
NOTED