


3/27/2020 11:06:48 AM
 BIM 360://198014-003 - Watson Park Events Center New Building/198014_MASTER
 STRUCT_R19.rvt

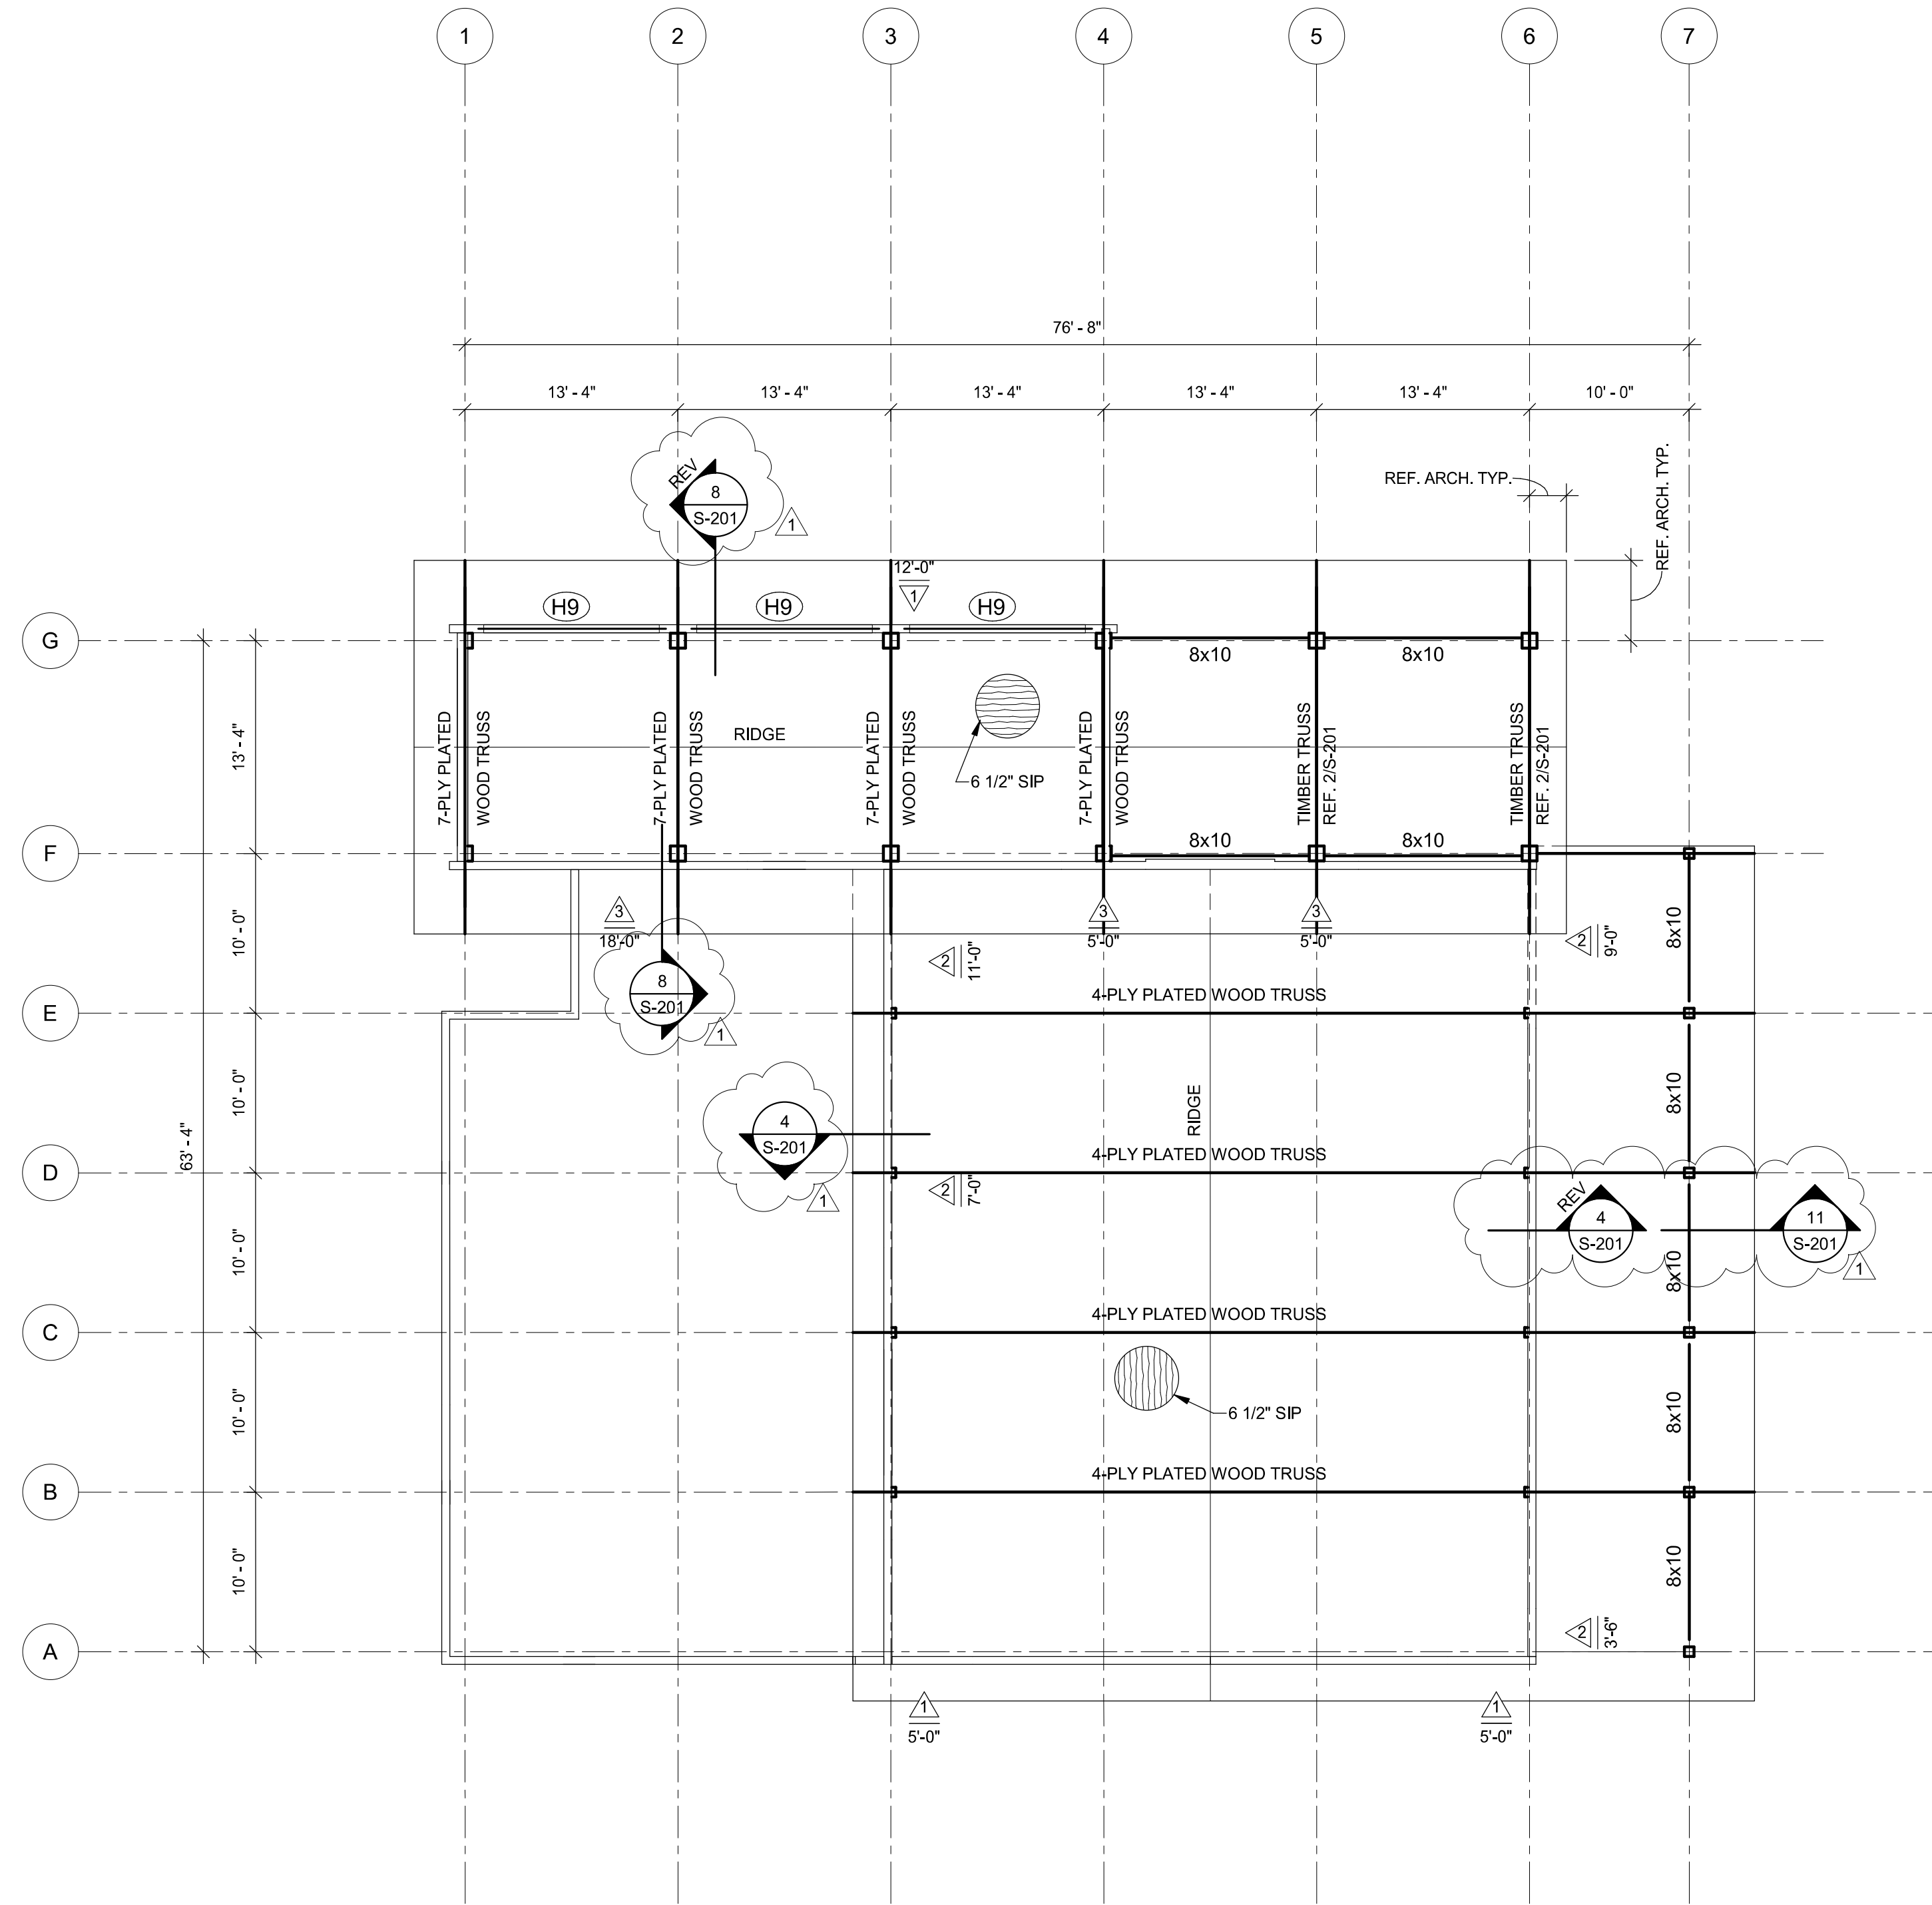

ROOF FRAMING NOTES:

- REFERENCE SHEET S-001 AND S-002 FOR GENERAL STRUCTURAL NOTES AND S-003 FOR SPECIAL INSPECTION REQUIREMENTS.

PLAN MARKS:

LENGTH
 SHEAR WALLS, REFERENCE SHEAR WALL SCHEDULE ON SHEET S-602

1 HIGH ROOF FRAMING PLAN - ADD./ALT. #2
 1/8" = 1'-0"