


COORDS SWS

Point Table			
Point #	Northing	Easting	Raw Description
7000	1652458.15	1629651.42	0+00
7001	1652316.50	1629726.99	1+60.5
7002	1652278.58	1629864.23	3+02.9
7003	1652269.81	1629904.64	3+44.3
7004	1652267.39	1630098.50	5+38.1
7005	1652277.22	1630107.32	5+51.4
7006	1652085.64	1630445.46	0+00
7007	1651932.89	1630448.45	1+52.8
7008	1651891.57	1630448.57	1+94.1
7009	1651748.77	1630447.86	3+36.9
7010	1651525.41	1630449.85	5+60.3
7011	1651747.17	1630579.33	1+31.5
7012	1651747.28	1630614.67	1+66.8
7013	1651932.51	1629629.83	0+00
7014	1651945.62	1629697.16	0+68.6

COORDS IRON

Point Table			
Point #	Northing	Easting	Raw Description
1	1652331.10	1629868.90	iron
2	1652306.16	1629927.84	iron
3	1652225.85	1629910.65	iron
4	1652227.21	1629846.67	iron
5	1652137.37	1629844.75	iron
6	1652137.36	1629908.76	iron
7	1652137.37	1629803.66	iron
8	1652073.37	1629803.66	iron
9	1652073.35	1630006.99	iron
10	1652137.35	1630007.00	iron
11	1652096.39	1630102.56	iron
12	1652052.25	1630056.22	iron
13	1651951.83	1630151.87	iron
14	1651995.98	1630198.21	iron
15	1651943.85	1630320.36	iron
16	1651879.85	1630320.55	iron
17	1651945.05	1630717.14	iron
18	1651881.05	1630717.33	iron
19	1651903.77	1630832.33	iron
20	1651963.03	1630808.16	iron
21	1651880.77	1630625.60	iron
22	1651880.60	1630567.60	iron
23	1651691.06	1630568.17	iron
24	1651691.23	1630626.17	iron
25	1651434.36	1630760.26	iron
26	1651524.37	1630434.85	iron
27	1651743.73	1630434.56	iron
28	1651743.63	1630159.56	iron
29	1651933.58	1630159.31	iron
30	1651933.40	1629669.31	iron

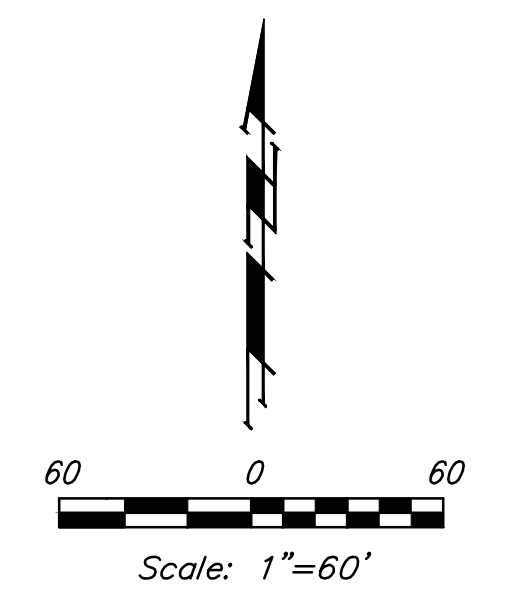

Baughman Company, P.A.
