


IRONS

Point Table			
Point #	Northing	Easting	Raw Description
1	1694524.34	1599464.68	iron
2	1694523.45	1599400.68	iron
3	1694589.50	1599399.76	iron
4	1694590.39	1599463.76	iron
5	1694653.50	1599472.18	iron
6	1694629.72	1599526.50	iron
7	1694682.85	1599549.76	iron
8	1694706.63	1599495.43	iron
9	1694746.93	1599526.95	iron
10	1695361.23	1600046.01	iron
11	1695316.16	1600091.45	iron
12	1695521.85	1600173.00	iron
13	1695520.17	1600109.03	iron
14	1695339.89	1600024.85	iron
15	1695298.71	1599984.01	iron
16	1695336.33	1599889.12	iron
17	1695394.31	1599887.60	iron
18	1695384.65	1599520.06	iron
19	1695326.67	1599521.59	iron
20	1695250.65	1599448.57	iron
21	1695249.84	1599390.57	iron
22	1694997.77	1599394.08	iron
23	1694998.58	1599452.07	iron
24	1694833.18	1599522.34	iron
25	1694792.00	1599481.50	iron
26	1694894.76	1599673.54	iron
27	1694935.94	1599714.38	iron
28	1694633.17	1599937.32	iron
29	1694674.35	1599978.16	iron
30	1694830.56	1600133.07	iron
31	1694876.01	1600178.14	iron
32	1695092.15	1599869.30	iron
33	1695137.59	1599914.36	iron
34	1695532.57	1600580.64	iron
35	1695498.29	1599267.10	iron
36	1694344.55	1599450.85	iron
37	1694381.09	1599503.64	iron
38	1694394.52	1599564.28	iron
39	1694402.27	1599847.01	iron
40	1694468.19	1599845.20	iron
41	1694469.94	1599909.17	iron
42	1694543.10	1599938.13	iron
43	1694588.17	1599892.69	iron
44	1695038.32	1600429.24	iron
45	1695117.47	1600417.60	iron

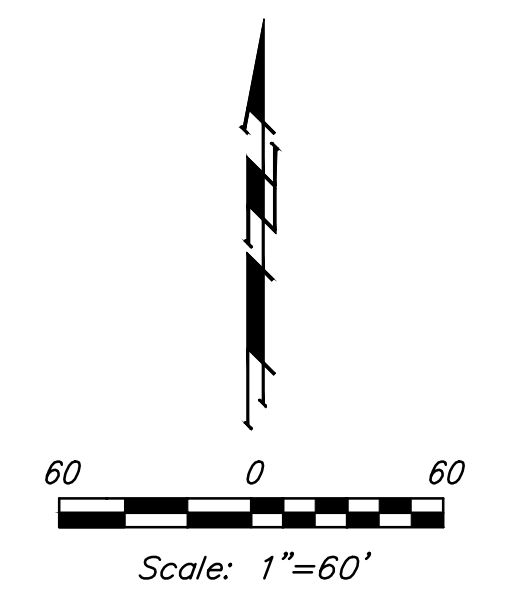

WATER DISTRIBUTION SYSTEM

Point Table			
Point #	Northing	Easting	Raw Description
6000	1694523.54	1599407.68	0+00
6001	1694589.60	1599406.76	0+66.06
6002	1694678.02	1599420.07	1+55.87
6003	1694787.07	1599486.47	2+84.73
6004	1694791.39	1599490.76	2+90.81
6005	1694939.15	1599637.30	4+98.92
6006	1695001.36	1599698.99	5+86.53
6007	1695071.65	1599768.70	7+86.71
6008	1695168.49	1599864.73	9+23.09
6009	1695174.91	1599868.98	9+30.78
6010	1695292.06	1599985.16	10+95.78
6011	1695296.36	1599991.54	11+03.47
6012	1695330.61	1600025.50	11+51.70
6013	1695338.47	1600033.29	11+62.77

Point Table			
Point #	Northing	Easting	Raw Description
6014	1695356.30	1600050.98	11+87.88
6015	1695495.37	1600115.29	13+44.25
6016	1695520.35	1600116.02	13+69.25
6017	1694656.67	1599479.89	0+63.51
6018	1694632.19	1599535.82	1+24.57
6019	1694610.16	1599544.44	1+48.23
6020	1694596.96	1599574.59	1+81.14
6021	1694608.95	1599605.24	2+14.05
6022	1694639.10	1599618.43	2+46.96
6023	1694669.75	1599606.45	2+79.87
6024	1694679.33	1599584.55	3+03.77
6025	1694997.86	1599400.08	2+31.63
6026	1695249.92	1599396.57	4+83.72
6027	1695292.18	1599403.18	5+26.69

Point Table			
Point #	Northing	Easting	Raw Description
6028	1695378.65	1599520.22	6+81.64
6029	1695388.31	1599887.76	10+49.31
6030	1694718.30	1599859.99	3+13.64
6031	1695036.76	1599678.91	6+36.71
6032	1695075.71	1599678.75	6+75.66
6033	1695099.08	1599701.92	7+08.57
6034	1695099.24	1599740.88	7+47.53
6035	1695057.12	1599985.57	1+64.33
6036	1694962.79	1600080.69	2+98.30
6037	1694756.07	1599821.91	2+60.00
6038	1695009.17	1599706.73	5+97.53
6039	1694798.38	1599483.61	0+10
6040	1695337.72	1600018.48	11+93.19

