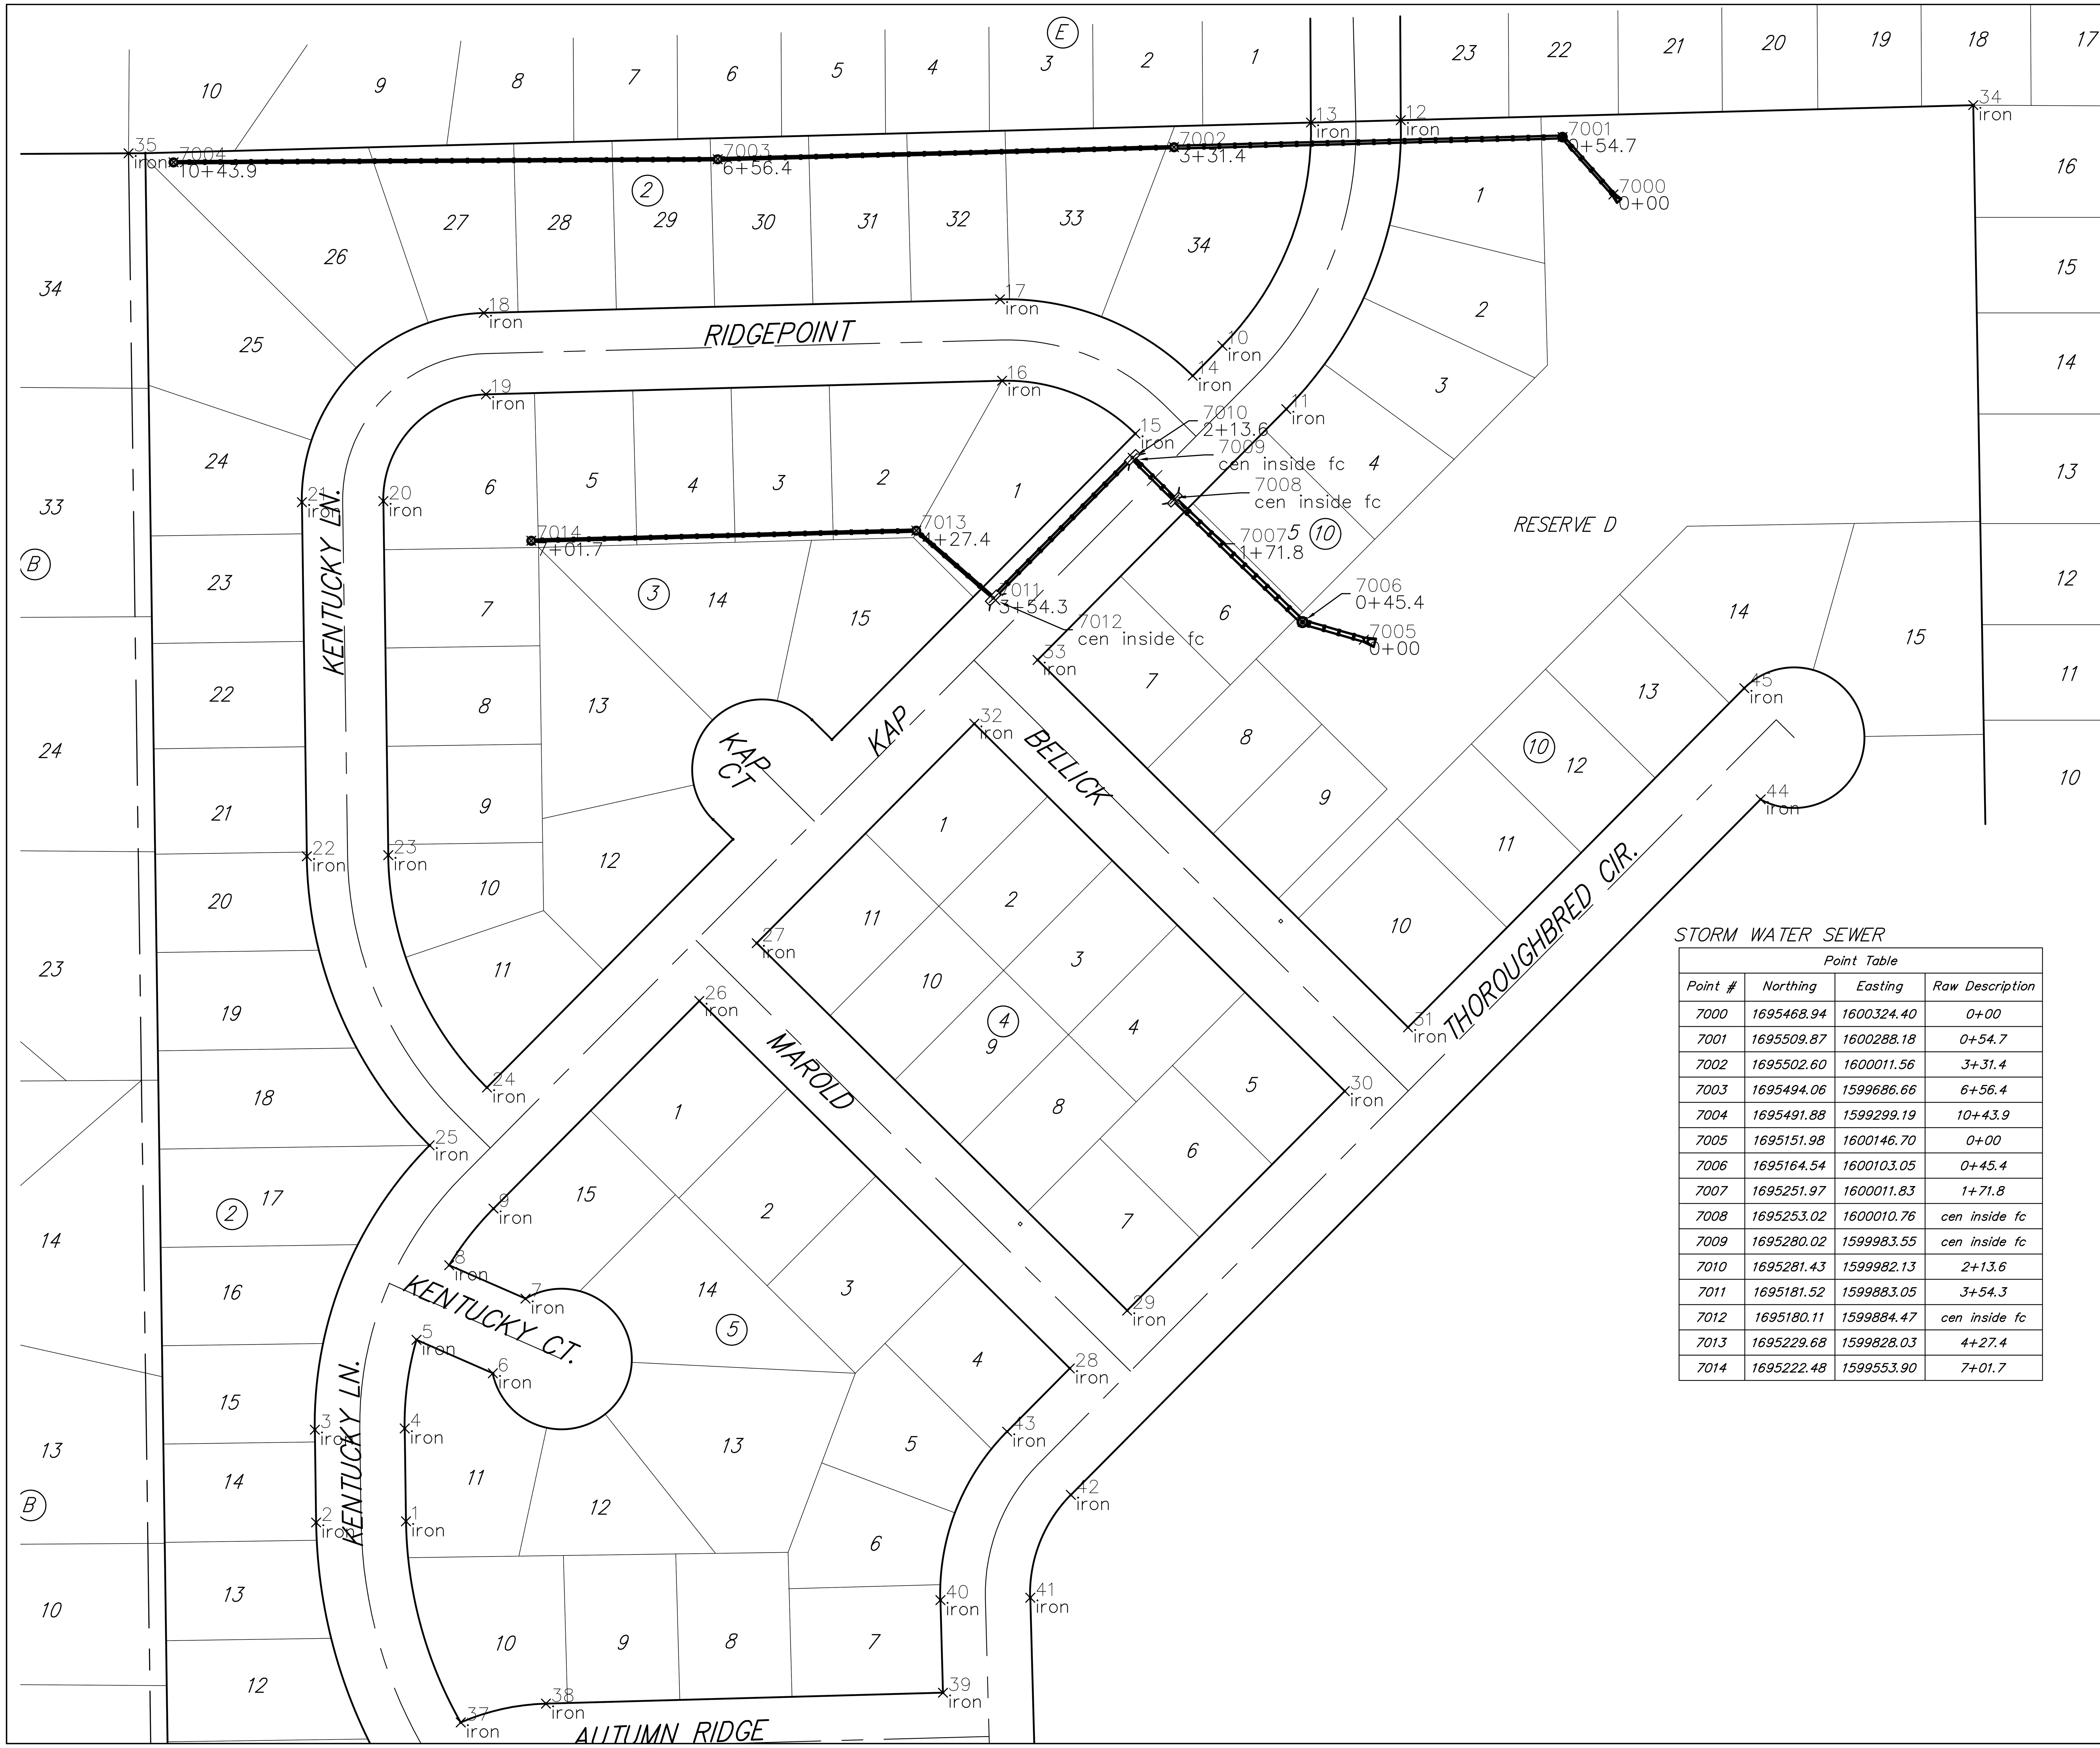

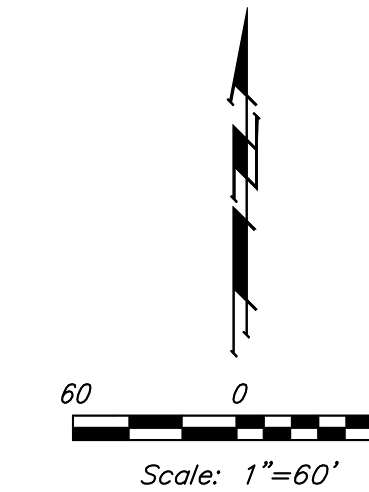

STORM WATER SEWER

Point Table			
Point #	Northing	Easting	Raw Description
7000	1695468.94	1600324.40	0+00
7001	1695509.87	1600288.18	0+54.7
7002	1695502.60	1600011.56	3+31.4
7003	1695494.06	1599686.66	6+56.4
7004	1695491.88	1599299.19	10+43.9
7005	1695151.98	1600146.70	0+00
7006	1695164.54	1600103.05	0+45.4
7007	1695251.97	1600011.83	1+71.8
7008	1695253.02	1600010.76	cen inside fc
7009	1695280.02	1599983.55	cen inside fc
7010	1695281.43	1599982.13	2+13.6
7011	1695181.52	1599883.05	3+54.3
7012	1695180.11	1599884.47	cen inside fc
7013	1695229.68	1599828.03	4+27.4
7014	1695222.48	1599553.90	7+01.7

IRONS

Point Table			
Point #	Northing	Easting	Raw Description
1	1694524.34	1599464.68	iron
2	1694523.45	1599400.68	iron
3	1694589.50	1599399.76	iron
4	1694590.39	1599463.76	iron
5	1694653.50	1599472.18	iron
6	1694629.72	1599526.50	iron
7	1694682.85	1599549.76	iron
8	1694706.63	1599495.43	iron
9	1694746.93	1599526.95	iron
10	1695361.23	1600046.01	iron
11	1695316.16	1600091.45	iron
12	1695521.85	1600173.00	iron
13	1695520.17	1600109.03	iron
14	1695339.89	1600024.85	iron
15	1695298.71	1599984.01	iron
16	1695336.33	1599889.12	iron
17	1695394.31	1599887.60	iron
18	1695384.65	1599520.06	iron
19	1695326.67	1599521.59	iron
20	1695250.65	1599448.57	iron
21	1695249.84	1599390.57	iron
22	1694997.77	1599394.08	iron
23	1694998.58	1599452.07	iron
24	1694833.18	1599522.34	iron
25	1694792.00	1599481.50	iron
26	1694894.76	1599673.54	iron
27	1694935.94	1599714.38	iron
28	1694633.17	1599937.32	iron
29	1694674.35	1599978.16	iron
30	1694830.56	1600133.07	iron
31	1694876.01	1600178.14	iron
32	1695092.15	1599869.30	iron
33	1695137.59	1599914.36	iron
34	1695532.57	1600580.64	iron
35	1695498.29	1599267.10	iron
36	1694344.55	1599450.85	iron
37	1694381.09	1599503.64	iron
38	1694394.52	1599564.28	iron
39	1694402.27	1599847.01	iron
40	1694468.19	1599845.20	iron
41	1694469.94	1599909.17	iron
42	1694543.10	1599938.13	iron
43	1694588.17	1599892.69	iron
44	1695038.32	1600429.24	iron
45	1695117.47	1600417.60	iron

Baughman Company, P.A.
315 Ellis St. Wichita, KS 67211 P 316-262-7271 F 316-262-0149
ENGINEERING | SURVEYING | PLANNING | LANDSCAPE ARCHITECTURE
Design: Drawn: Approved: Date: 08/20
File: SWDsws.dwg

CHERYL'S HOLLOW 2ND ADD. Ph. 3&4

COORDINATE SHEET

STORM WATER DRAIN IMPROVEMENTS

REVISIONS: