


BENCHMARKS:
 CHISELED "□", TOP OF CURB INLET, NW COR.
 OF CURB INLET, 77.8' W. & 16.1' N. OF NW
 COR., E1/2, NW1/4, SEC. 34, TWP. 27-S,
 R-2-E.
 ELEV. = 1332.09 NAVD88

CHISELED "□", TOP OF CURB INLET, NW COR.
 OF CURB INLET, 272.1' E. & 16.1' N. OF NW
 COR., E1/2, NW1/4, SEC. 34, TWP. 27-S,
 R-2-E.
 ELEV. = 1329.53 NAVD88

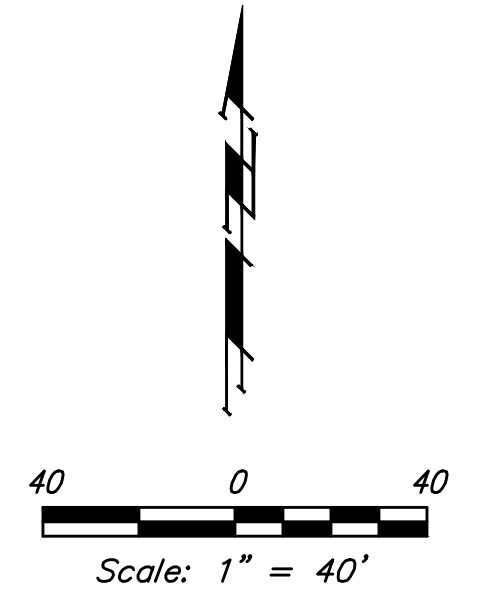


WILLOW CREEK EAST 4TH ADDITION

SLOAN'S ADDITION

WILLOW CREEK EAST 4TH ADDITION

WILLOW CREEK EAST 2ND ADDITION

SLOAN'S ADDITION₂₈

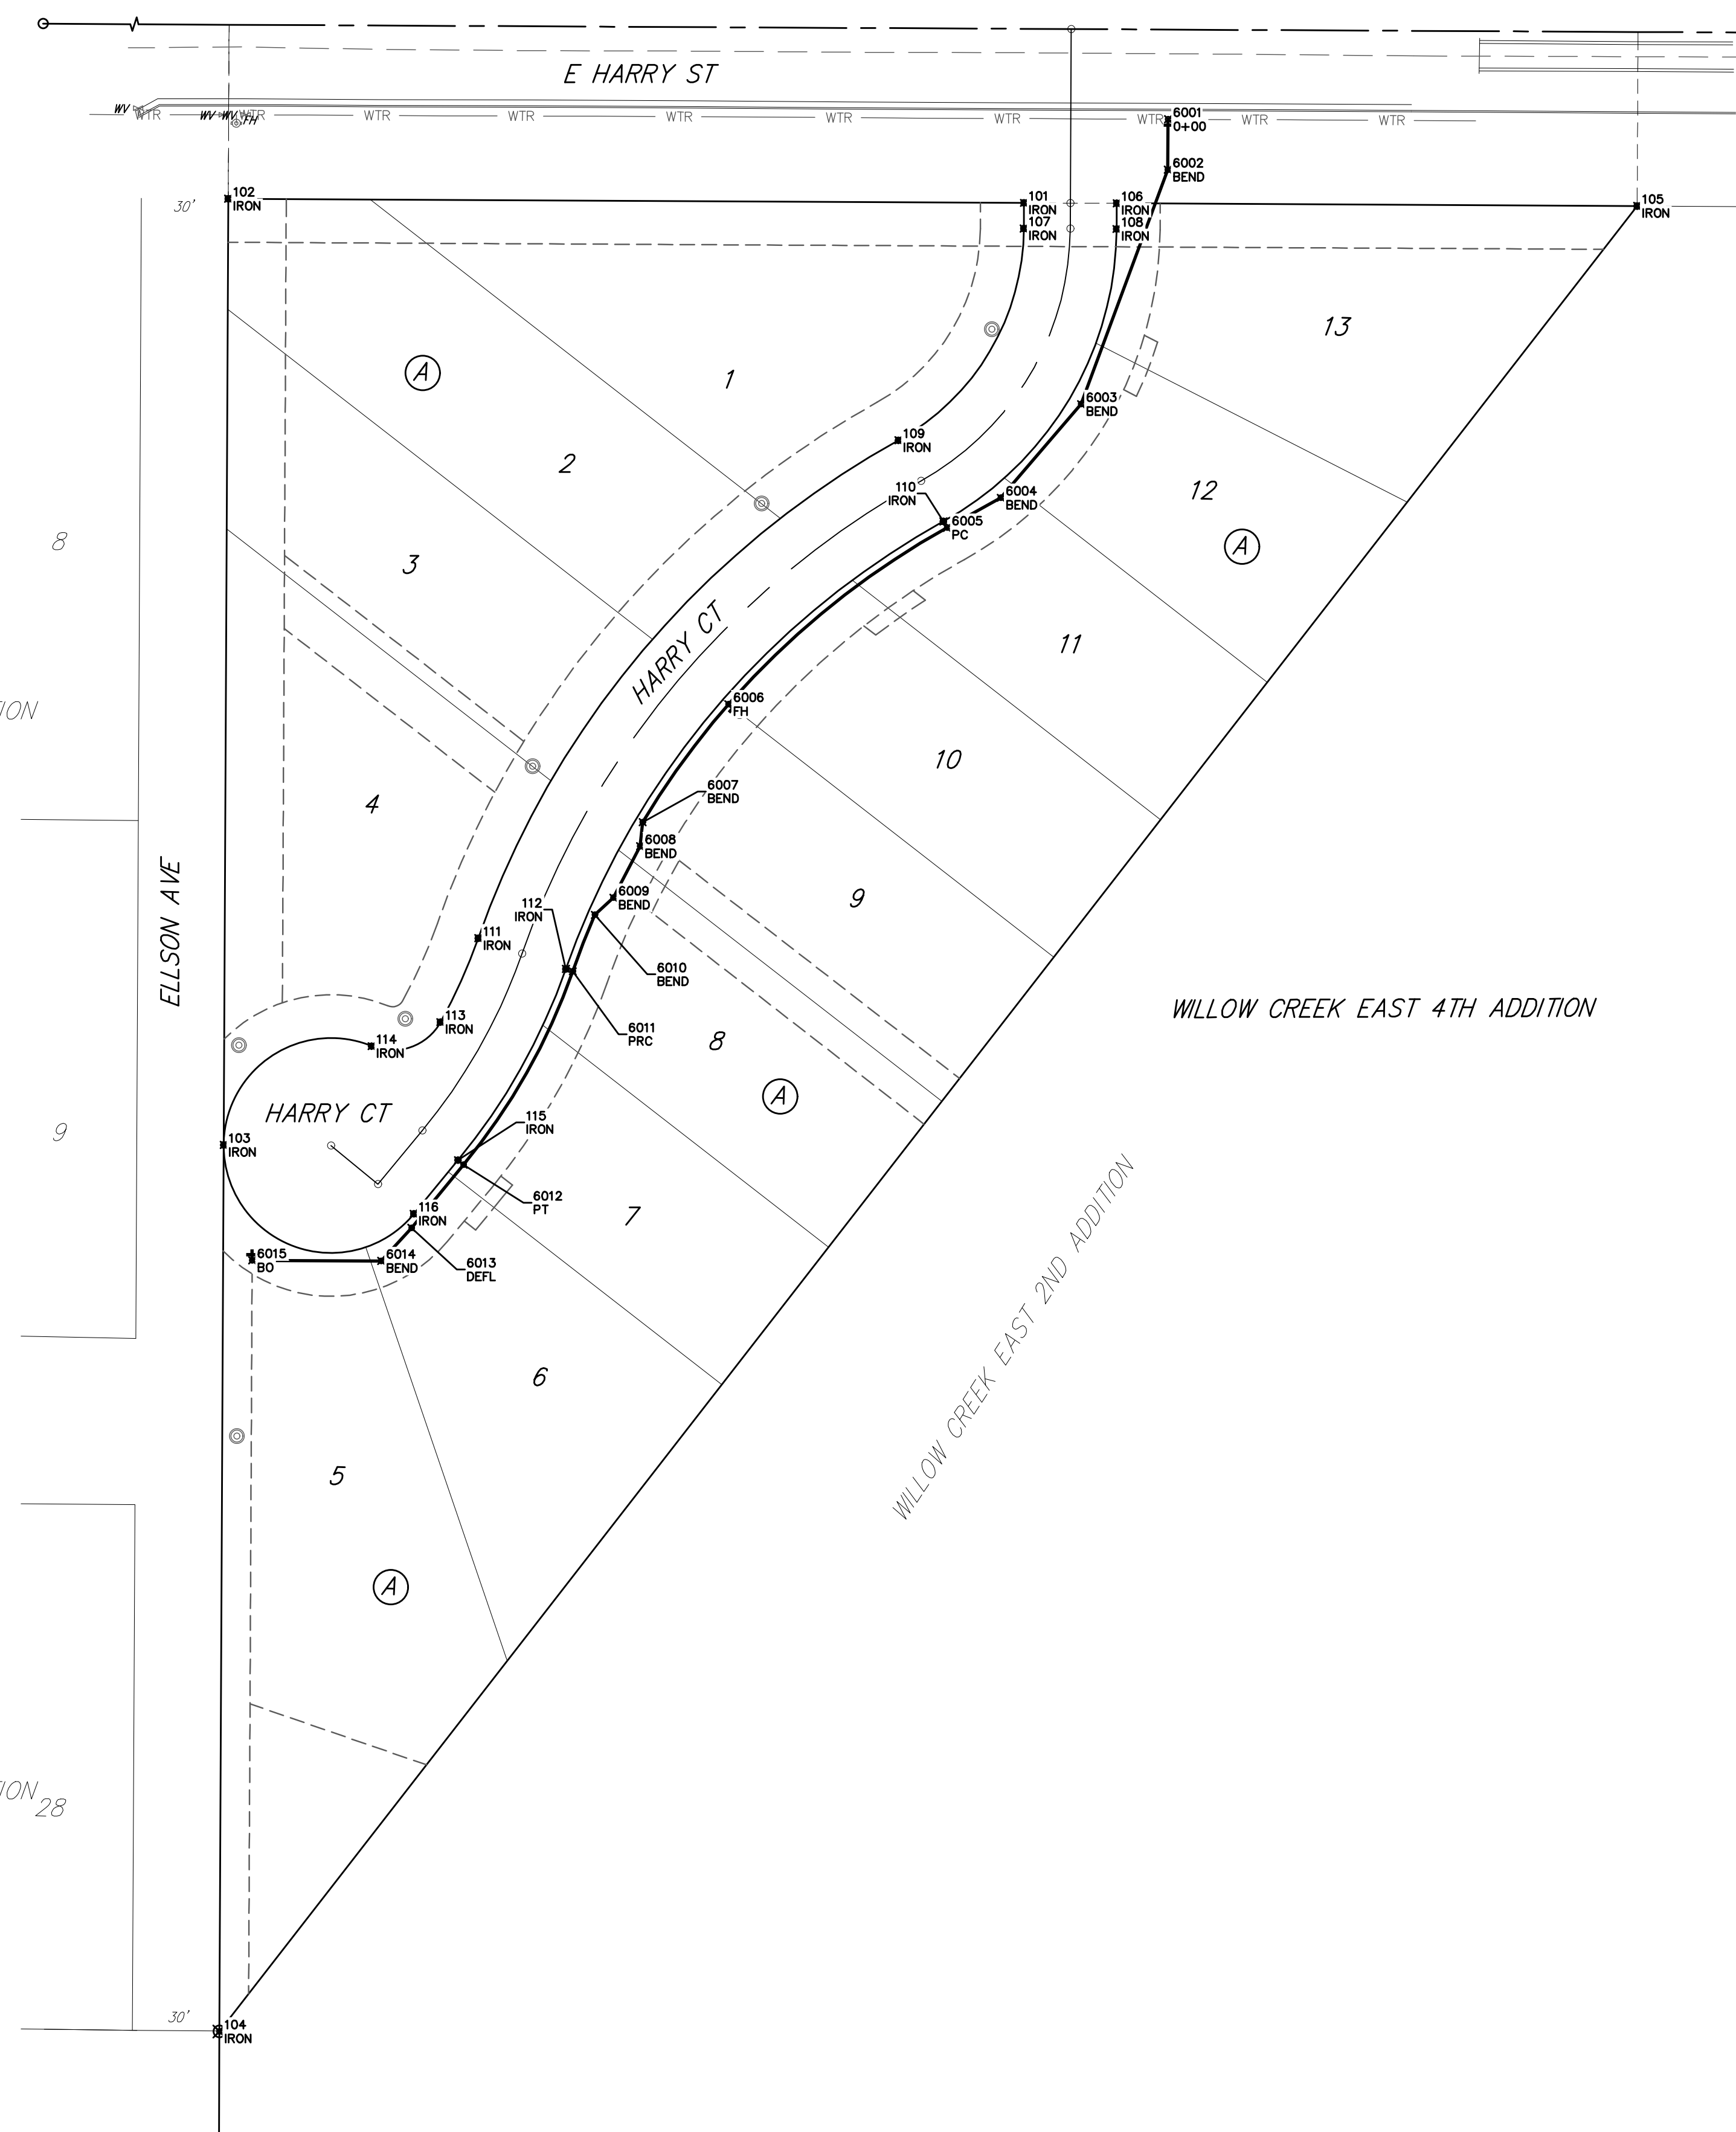

CONTROL POINTS			
Point #	Northing	Easting	Description
101	1,678,272.97	1,687,941.56	IRON
102	1,678,274.37	1,687,667.14	IRON
103	1,677,948.11	1,687,665.57	IRON
104	1,677,642.46	1,687,664.11	IRON
105	1,678,271.88	1,688,153.04	IRON
106	1,678,272.80	1,687,973.56	IRON
107	1,678,264.13	1,687,941.52	IRON
108	1,678,263.96	1,687,973.52	IRON
109	1,678,191.10	1,687,898.26	IRON
110	1,678,163.12	1,687,913.79	IRON
111	1,678,019.42	1,687,753.38	IRON
112	1,678,008.82	1,687,783.58	IRON
113	1,677,990.49	1,687,740.33	IRON
114	1,677,982.18	1,687,716.57	IRON
115	1,677,942.88	1,687,746.38	IRON
116	1,677,924.39	1,687,731.12	IRON
117	1,678,350.85	1,687,589.71	IRON
118	1,678,349.04	1,687,939.60	IRON

WTR POINTS			
Point #	Northing	Easting	Description
6001	1,678,301.79	1,687,991.26	0+00
6002	1,678,294.37	1,687,991.18	BEND
6003	1,678,203.52	1,687,961.29	BEND
6004	1,678,171.25	1,687,933.59	BEND
6007	1,678,058.40	1,687,910.05	BEND
6008	1,678,051.13	1,687,809.16	BEND
6009	1,678,033.35	1,687,799.98	BEND
6010	1,678,027.46	1,687,793.59	BEND
6011	1,678,007.99	1,687,785.94	PRC
6012	1,677,941.29	1,687,748.30	PT
6013	1,677,919.52	1,687,730.34	DEFL
6014	1,677,908.12	1,687,719.89	BEND
6015	1,677,908.34	1,687,675.38	BO

	Willow Creek East 4th Addition	
	COORDINATES	
Water Distribution System		
<small>Baughman Company, P.A. 315 Ellis St. Wichita, KS 67211 P 316-262-7271 F 316-262-0149 ENGINEERING SURVEYING PLANNING LANDSCAPE ARCHITECTURE</small>		
PROJECT NUMBER 448-2020-012803	DESIGN AEG	DRAWN HWJ
REVISIONS:	APPROVED	DATE 09/14/20
	SCALE Noted	SHEET 11 OF 12