
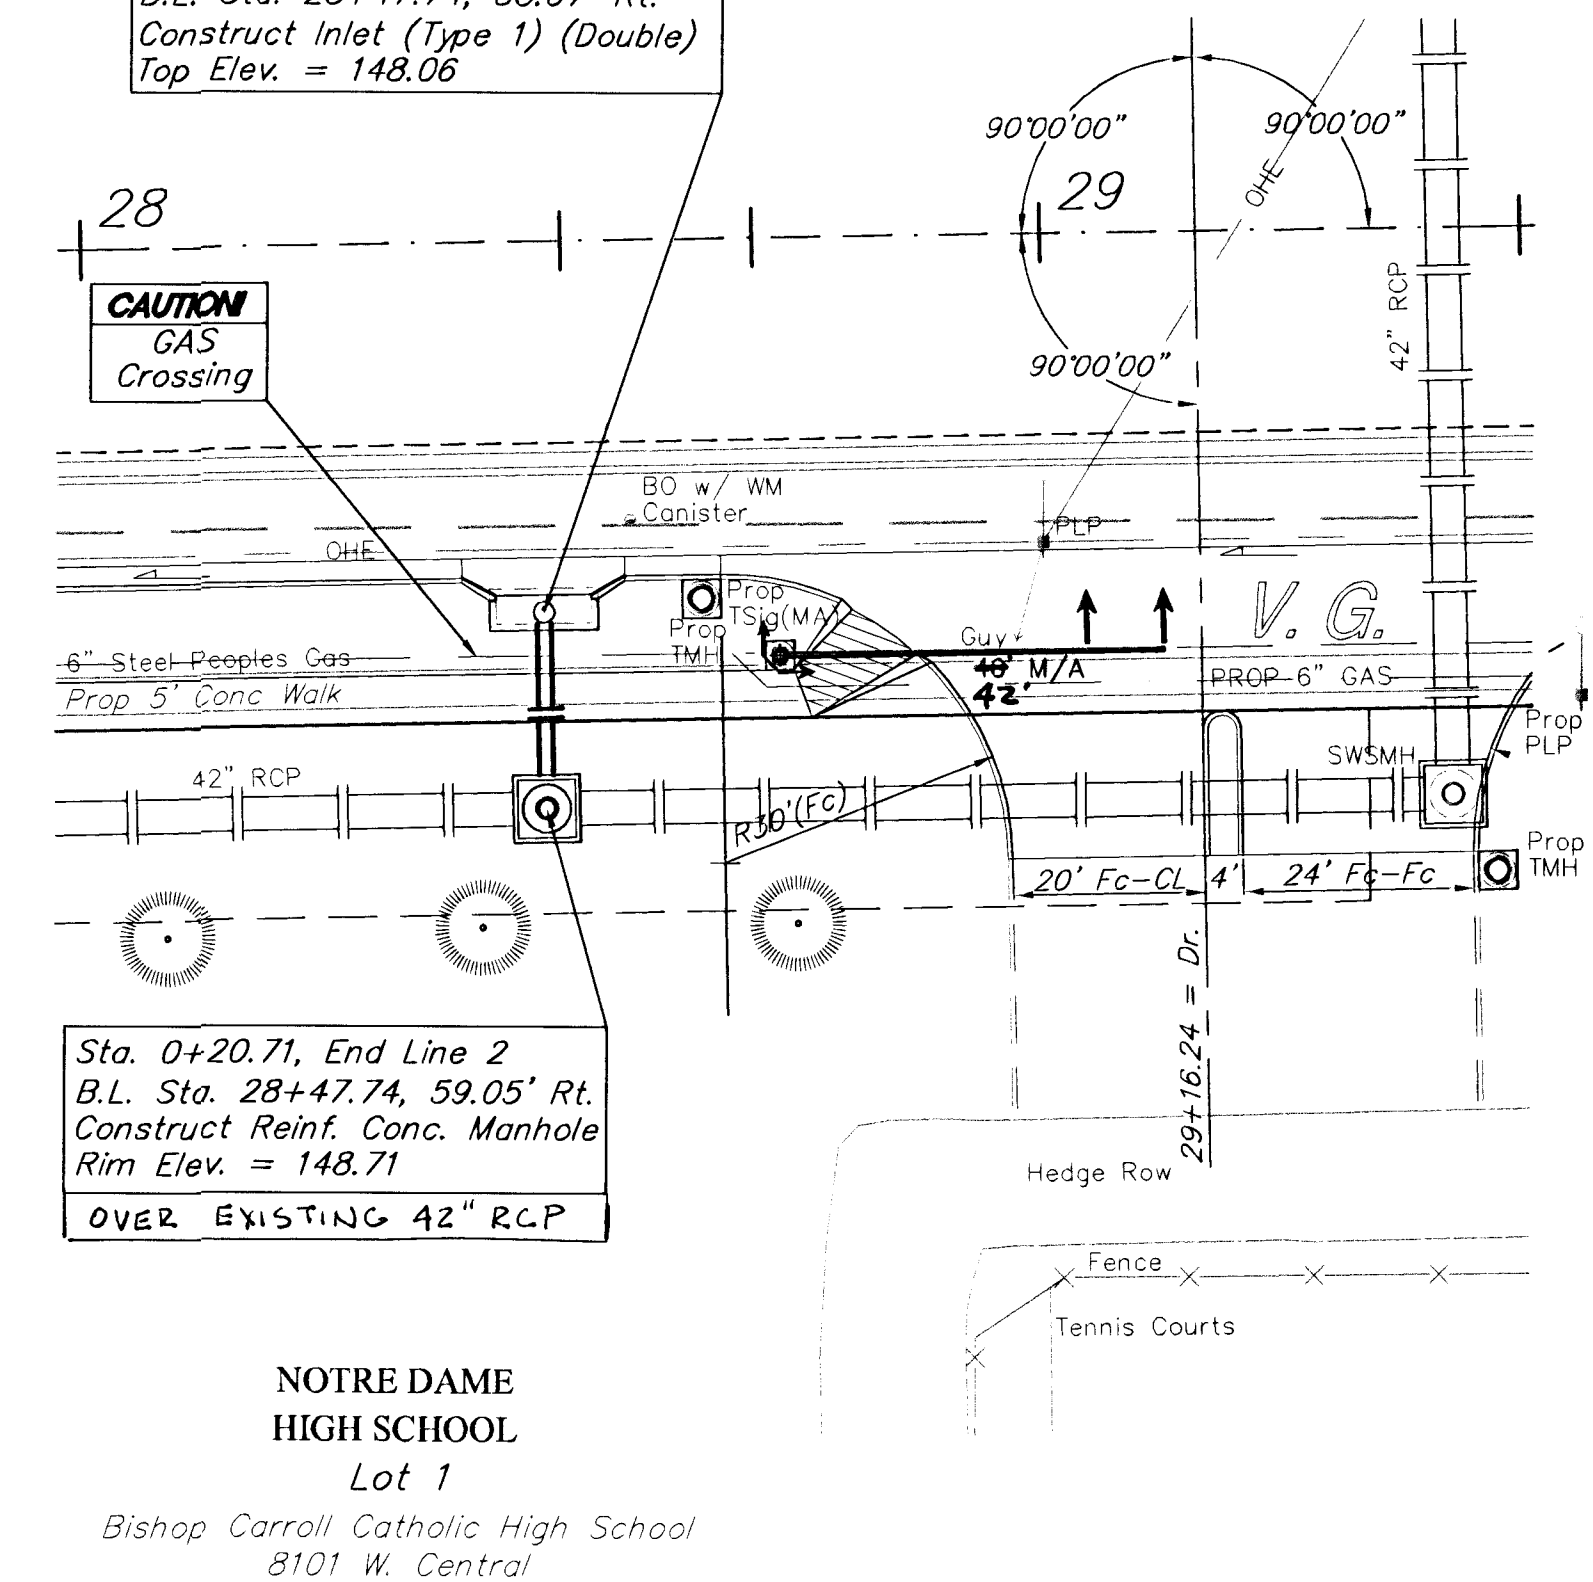


BM#2 - V-Notch on Back of Walk at SE
Corner of Fazoli's Restaurant Parcel,
NE of Central Avenue & Tyler Road,
64.89'± North and 987.32'± East
of Centerline of Both.
Sta. 19+87.32
Elev. = 146.84 (City Datum)

BM#3 - "□" Cut at SE Corner, Lot 4,
Tyler Acres 5th Addition, NW of
Central Avenue & Socora Lane,
65.10'± North and 34.94'± West
of Centerline of Both.
Sta. 28+81.30
Elev. = 148.79 (City Datum)

Sta. 11+67.04, Line 1
B.L. Sta. 22+80.02, 47.59' Rt.
Construct Reinf. Conc. Manhole
Rim Elev. = 147.10

Sta. 0+00.00, Begin Line 2
B.L. Sta. 28+47.74, 38.67' Rt.
Construct Inlet (Type 1) (Double)
Top Elev. = 148.06

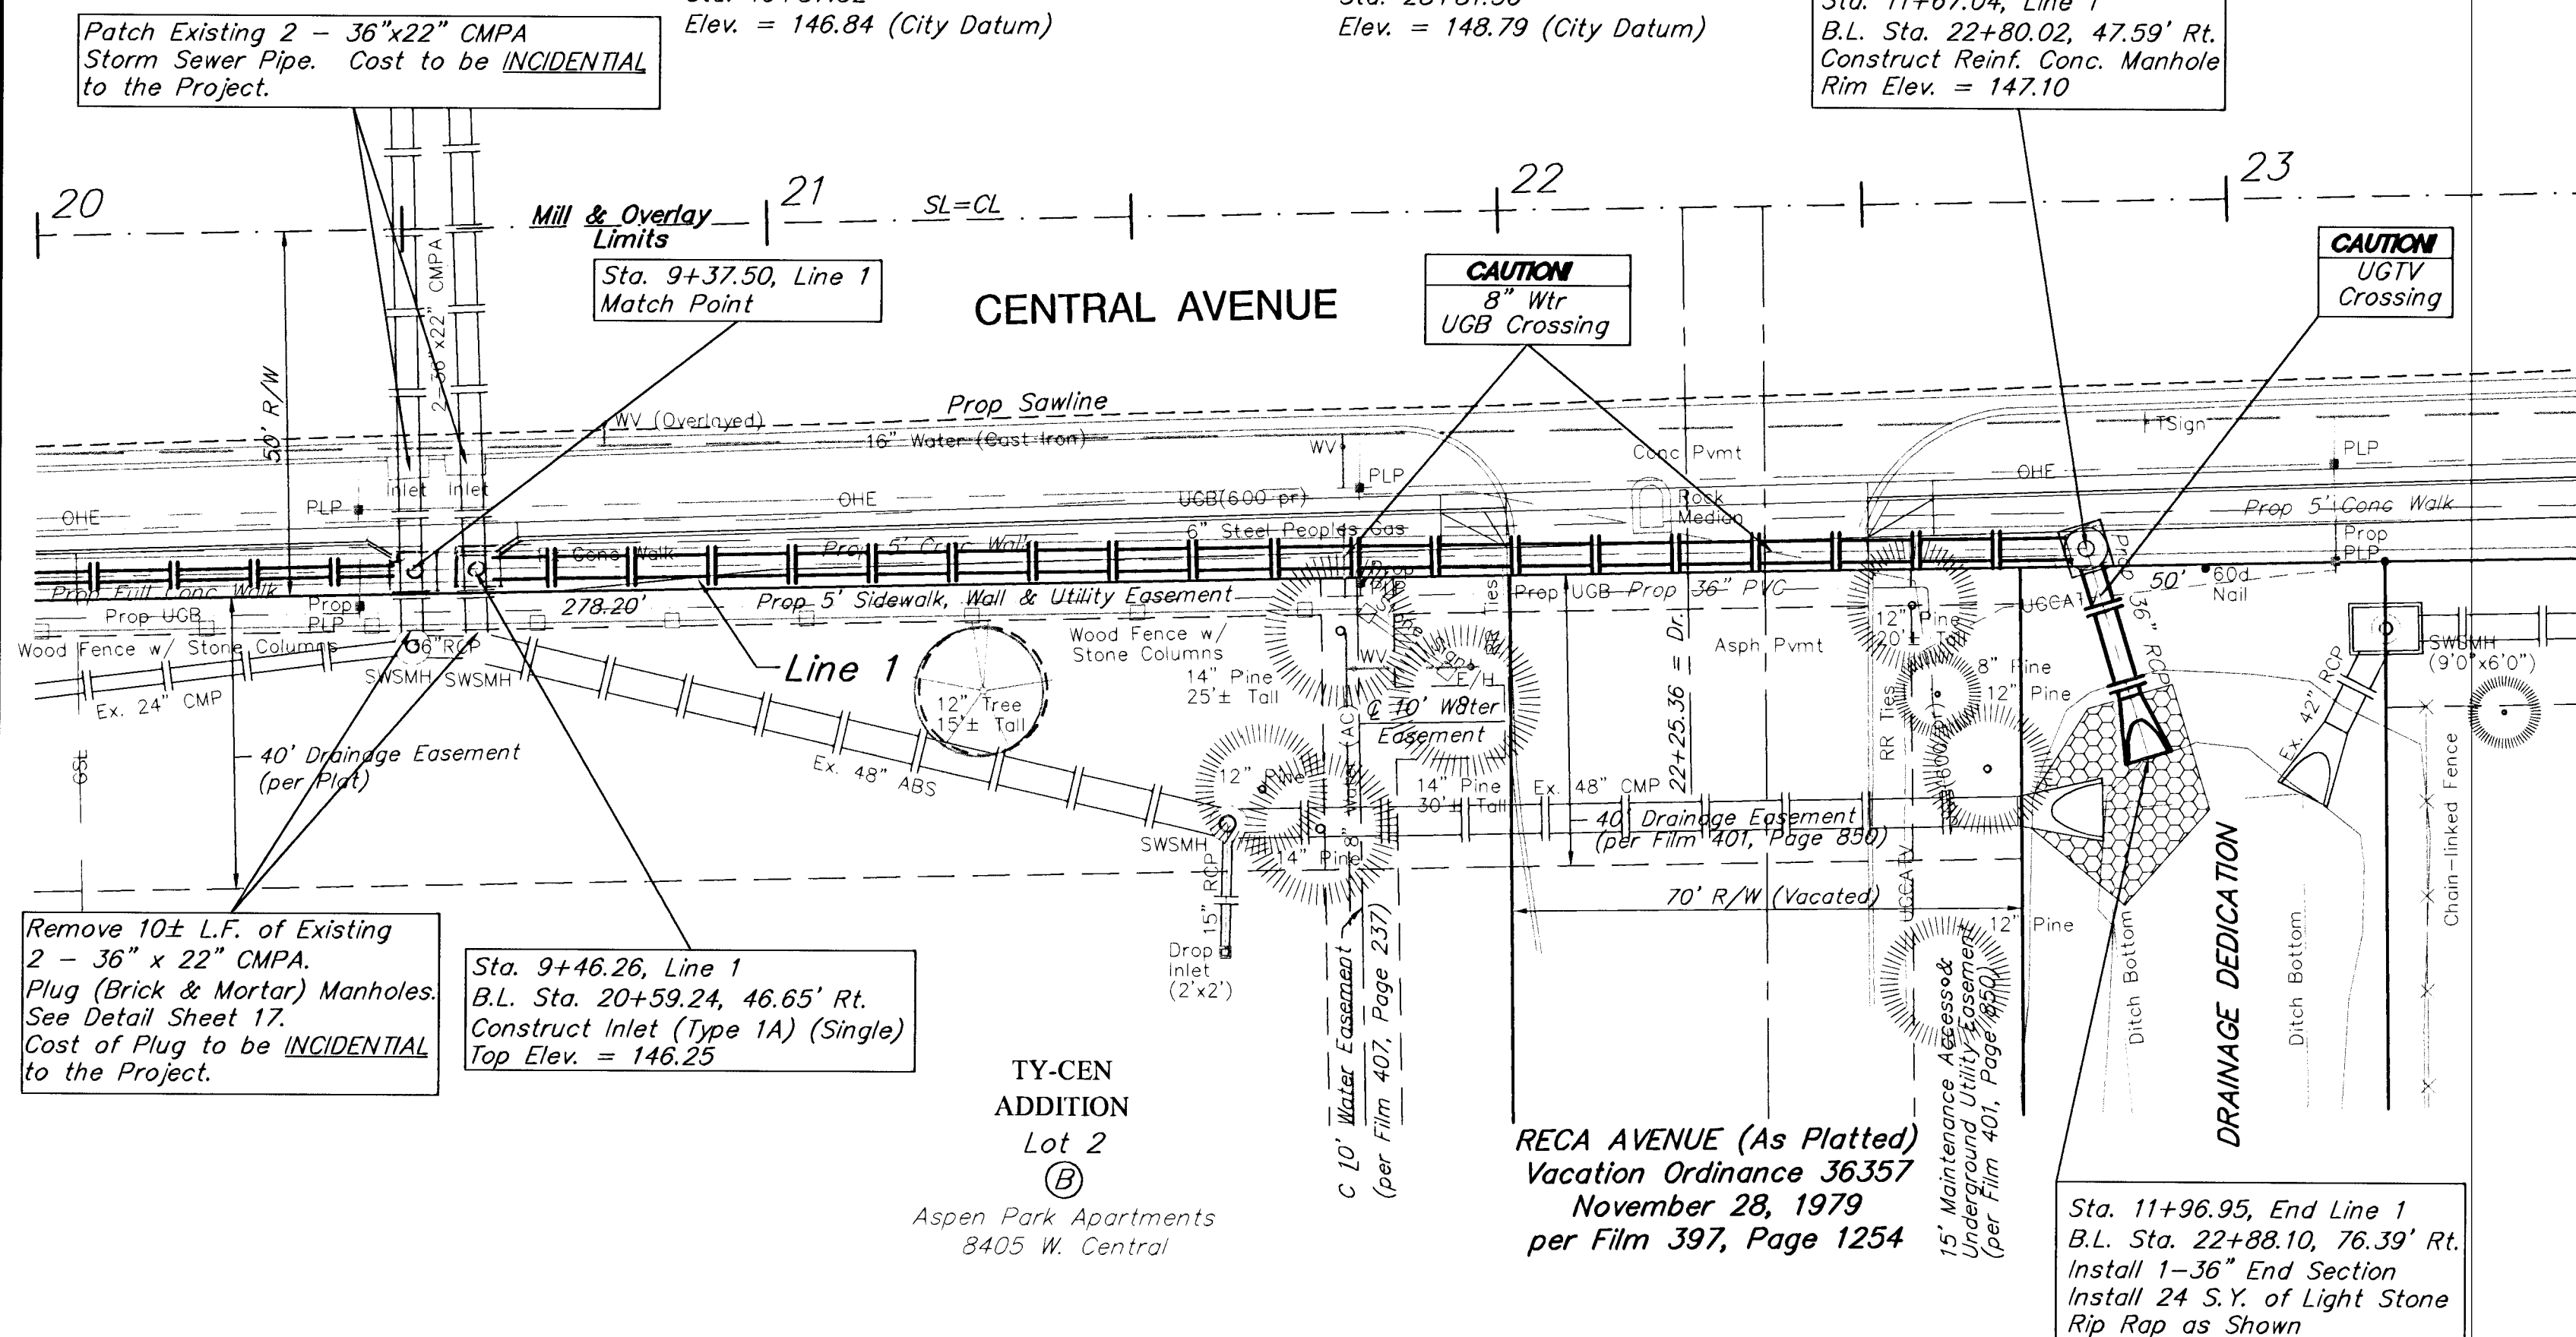

SCALE: 1" = 20'

