
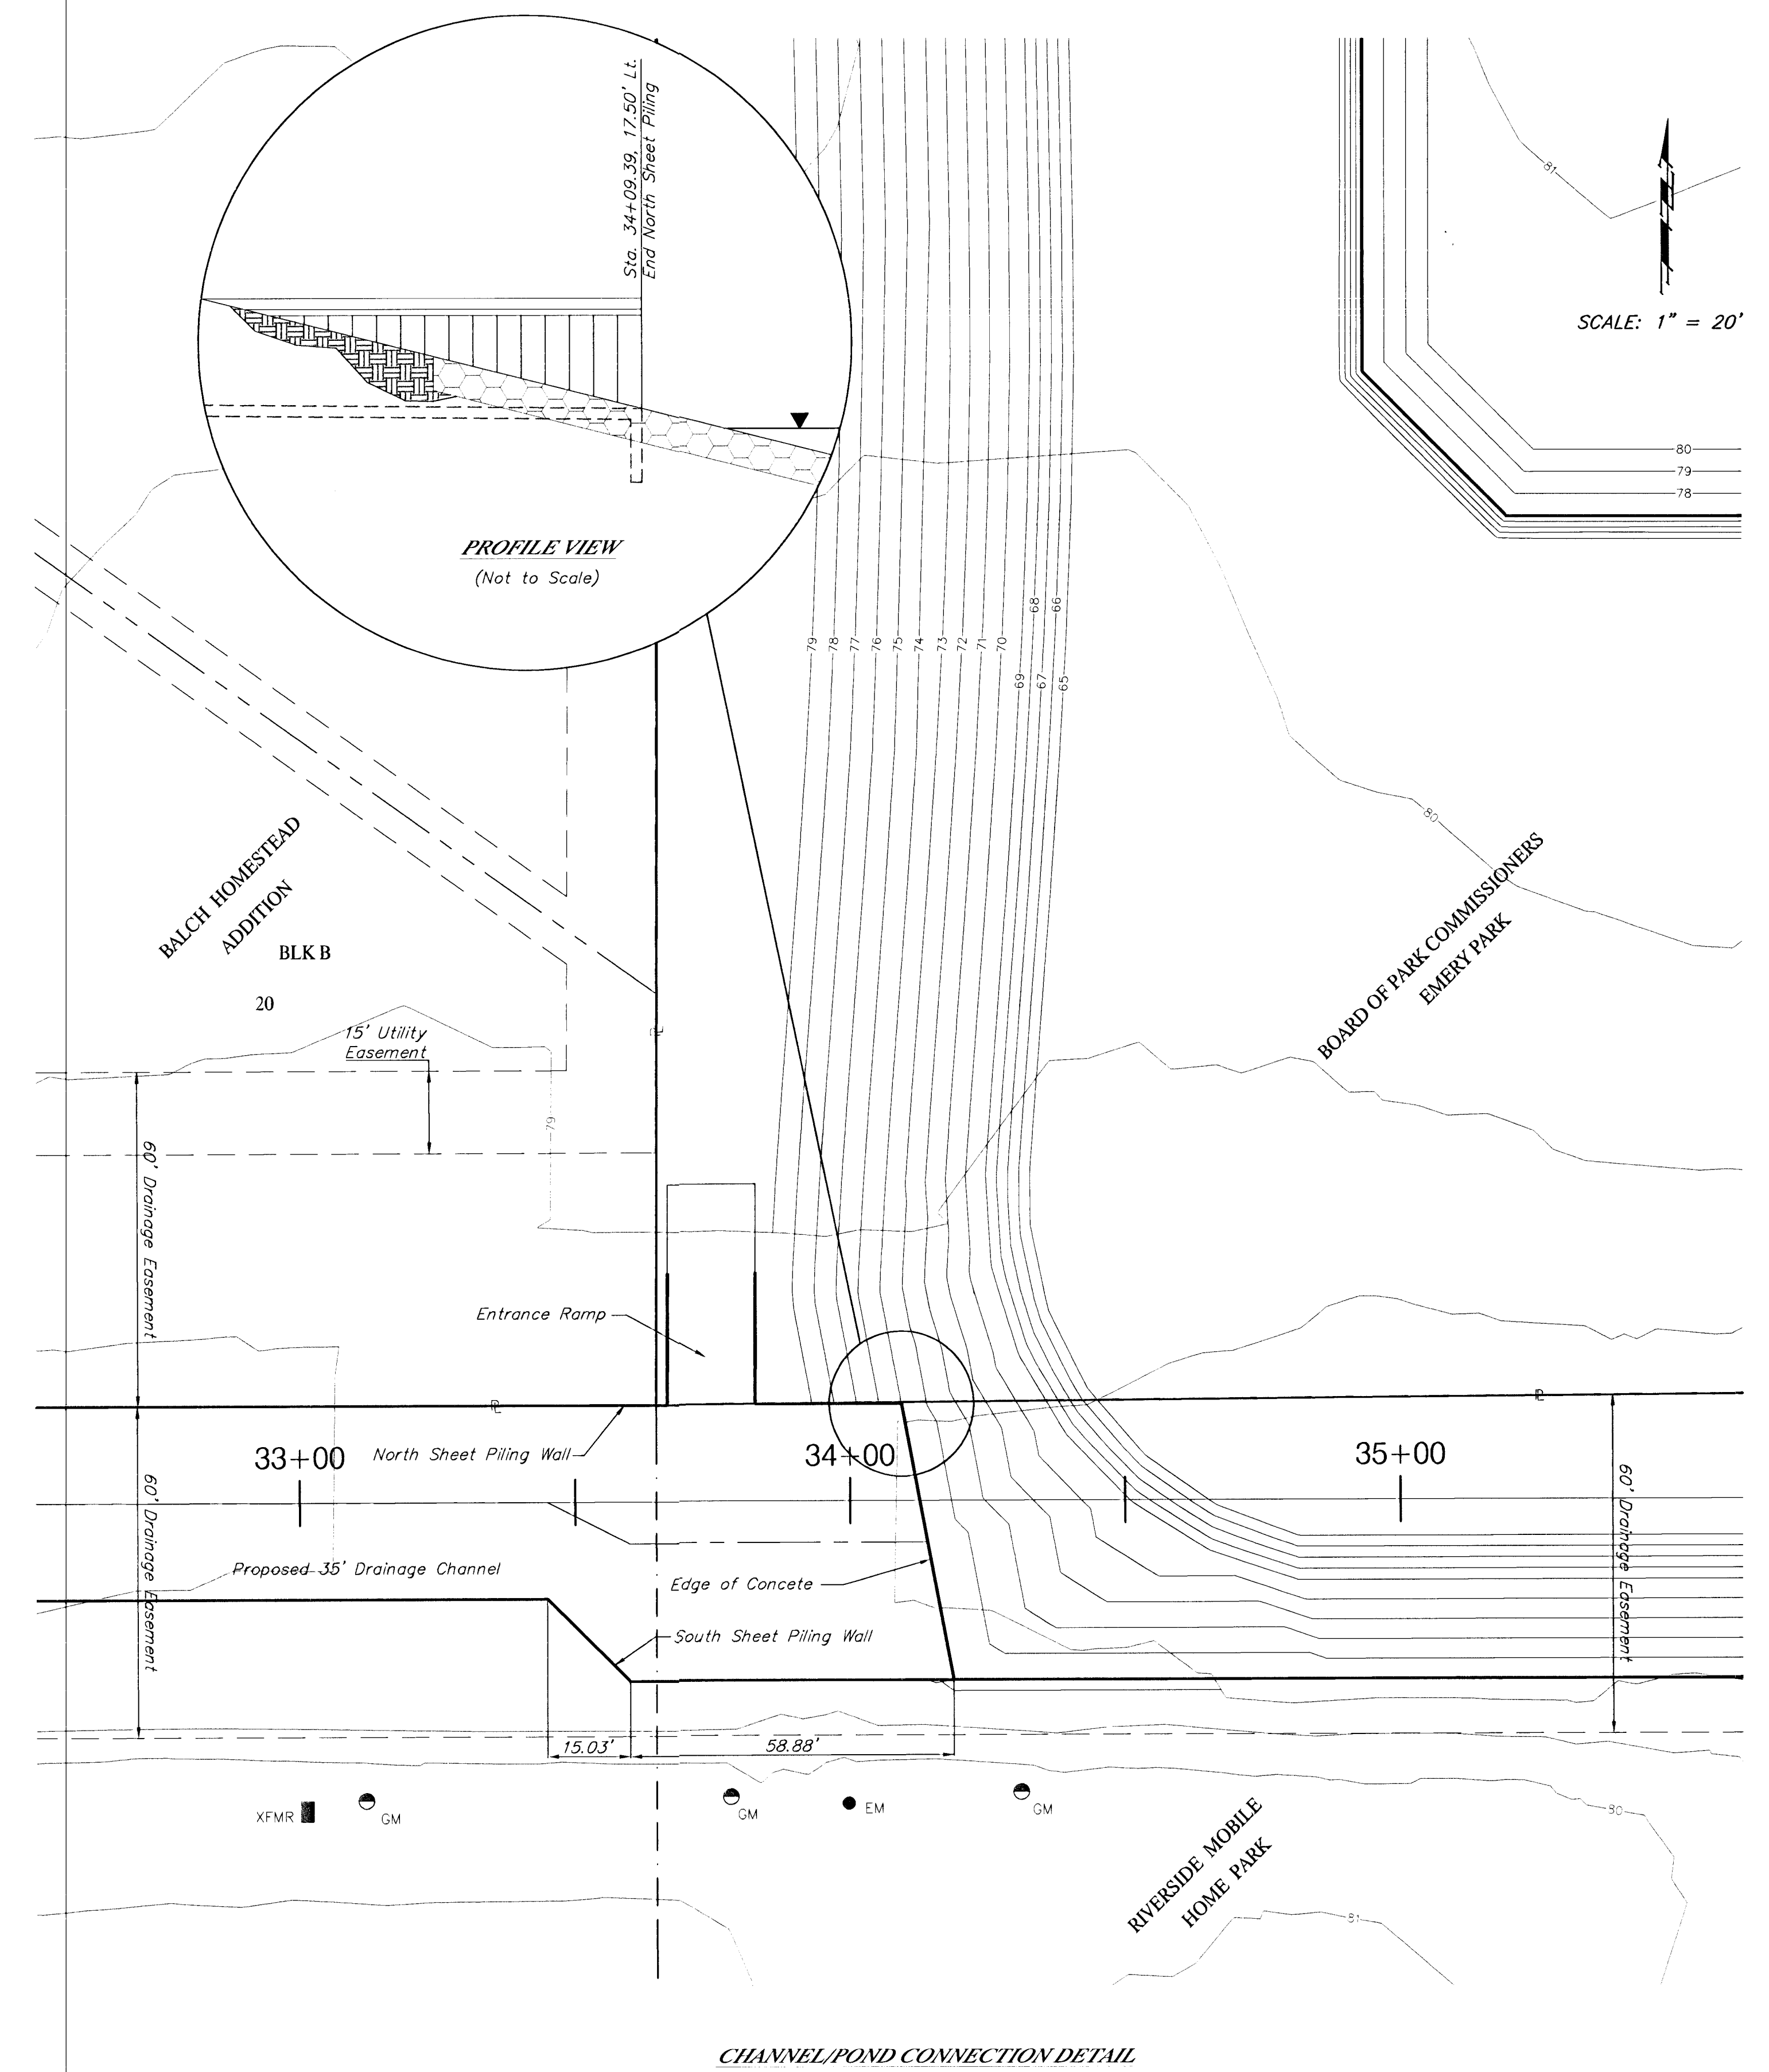
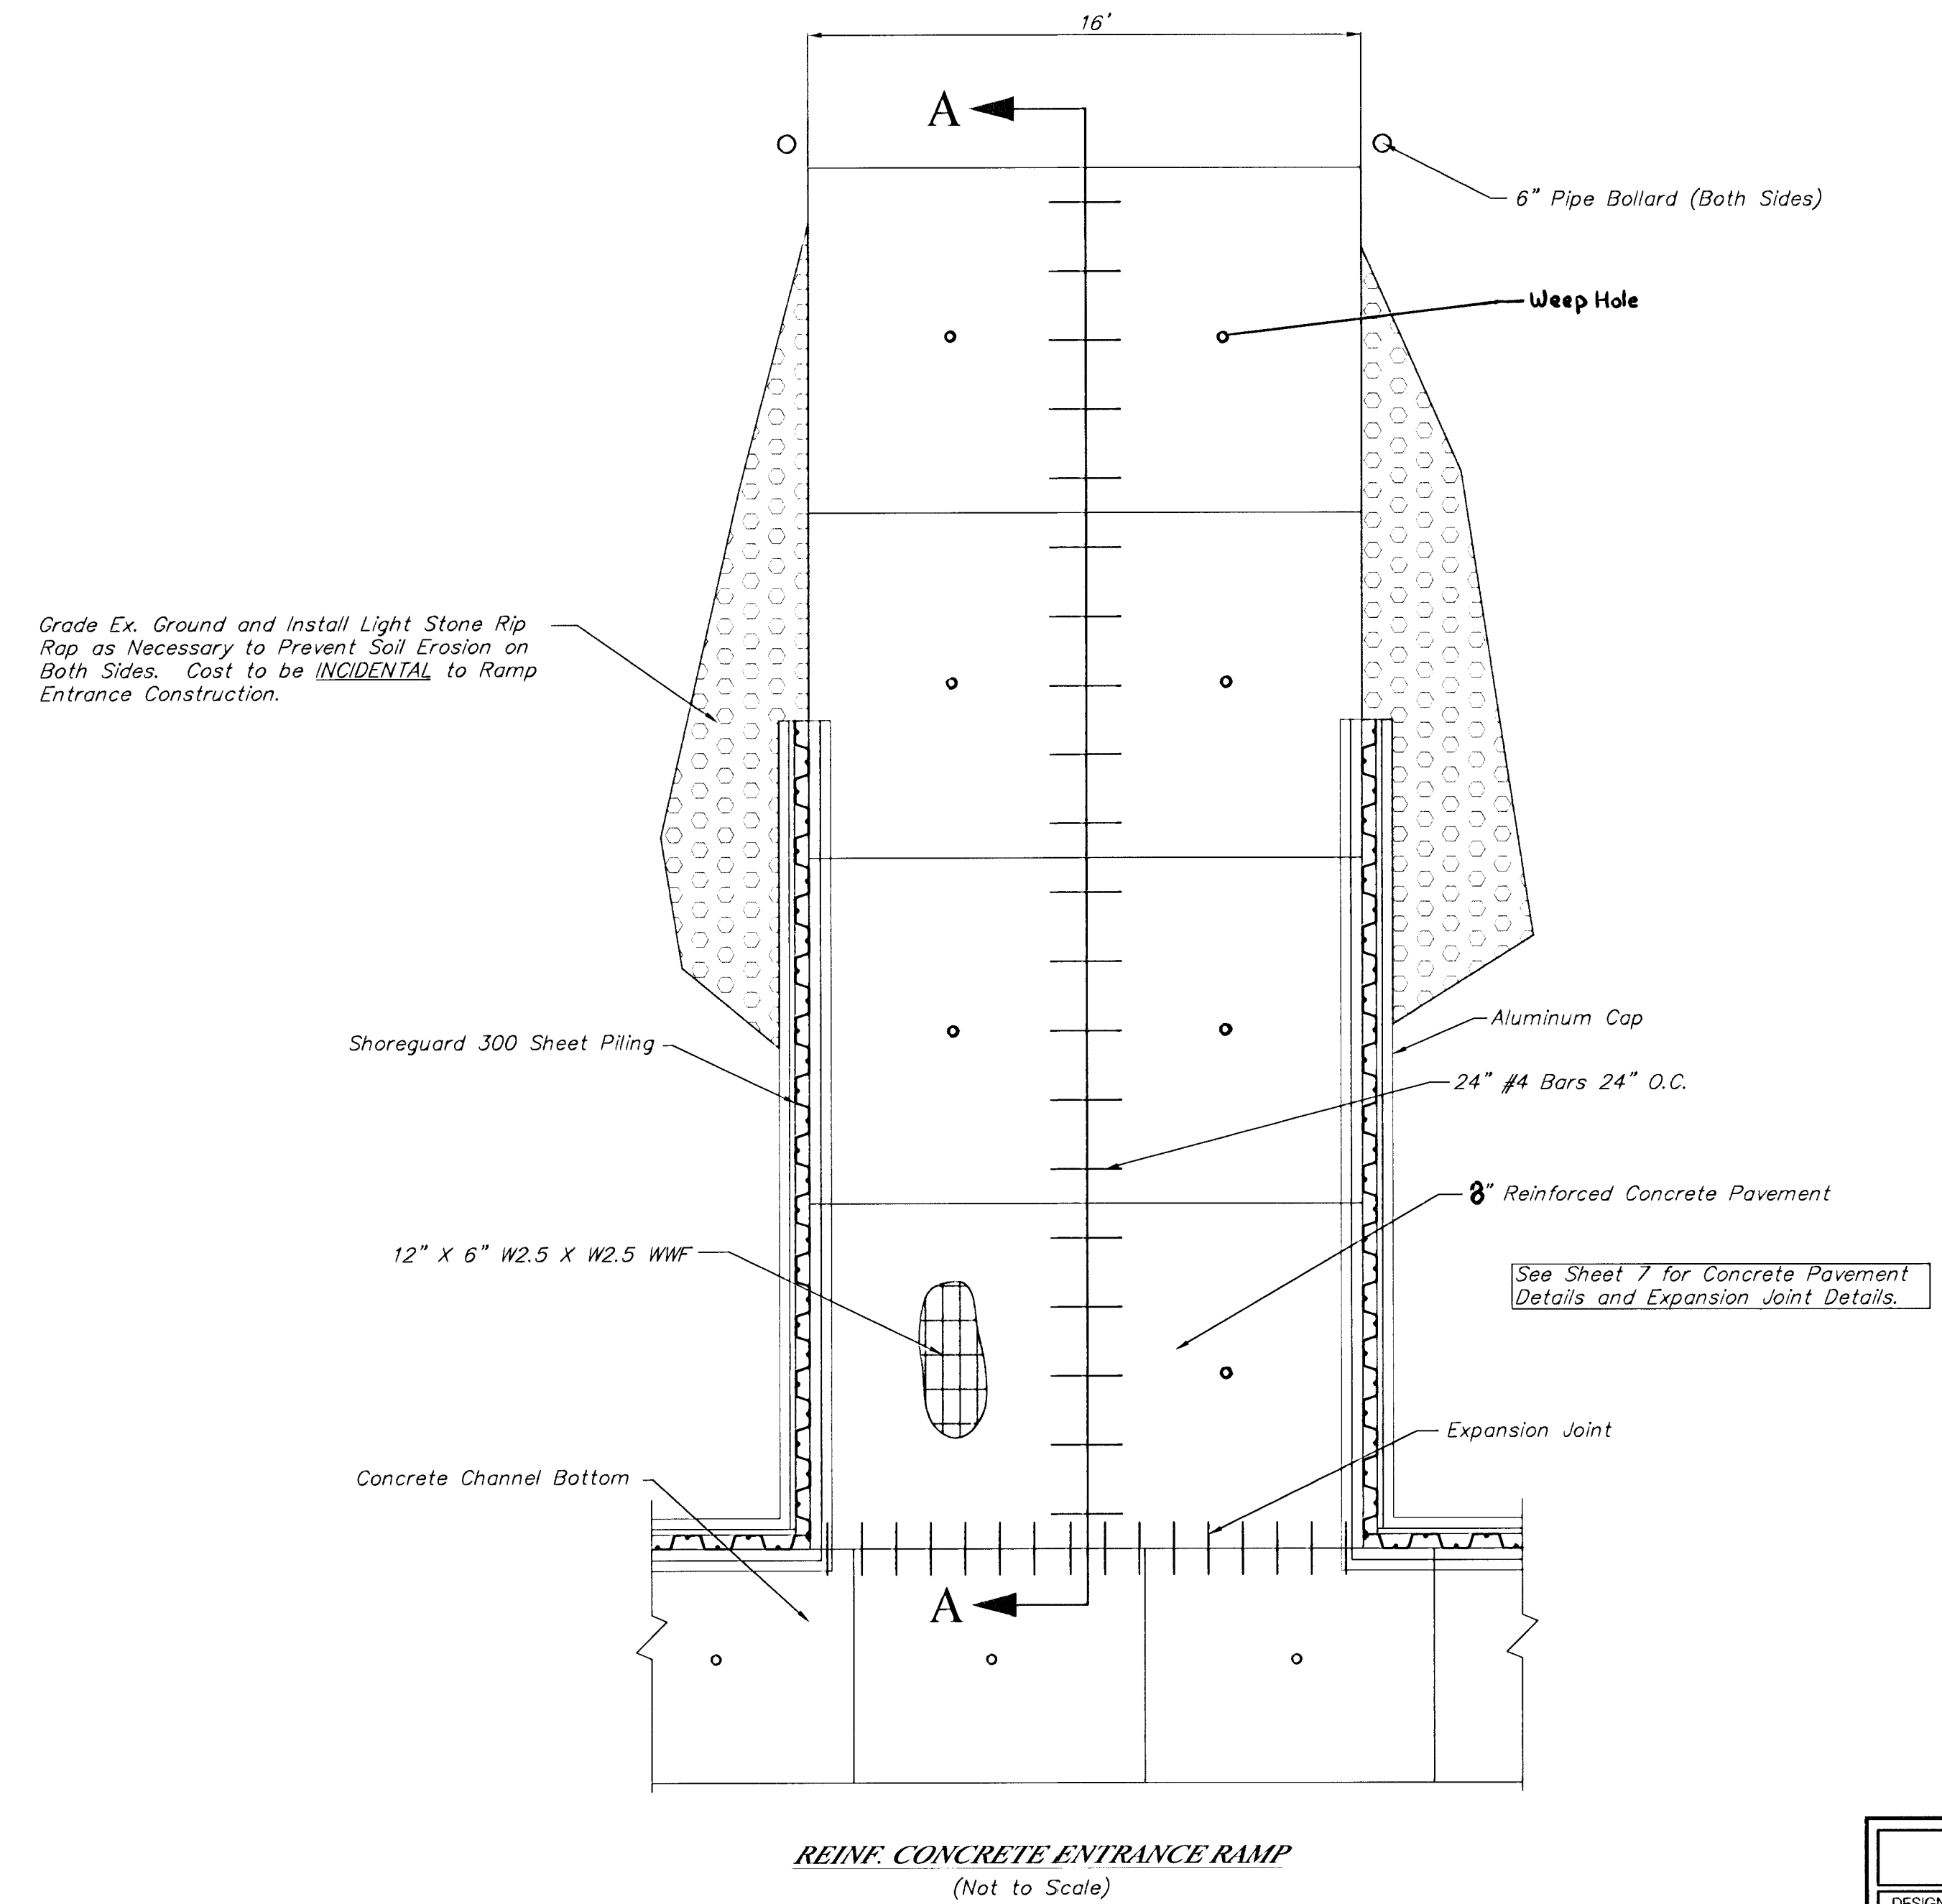


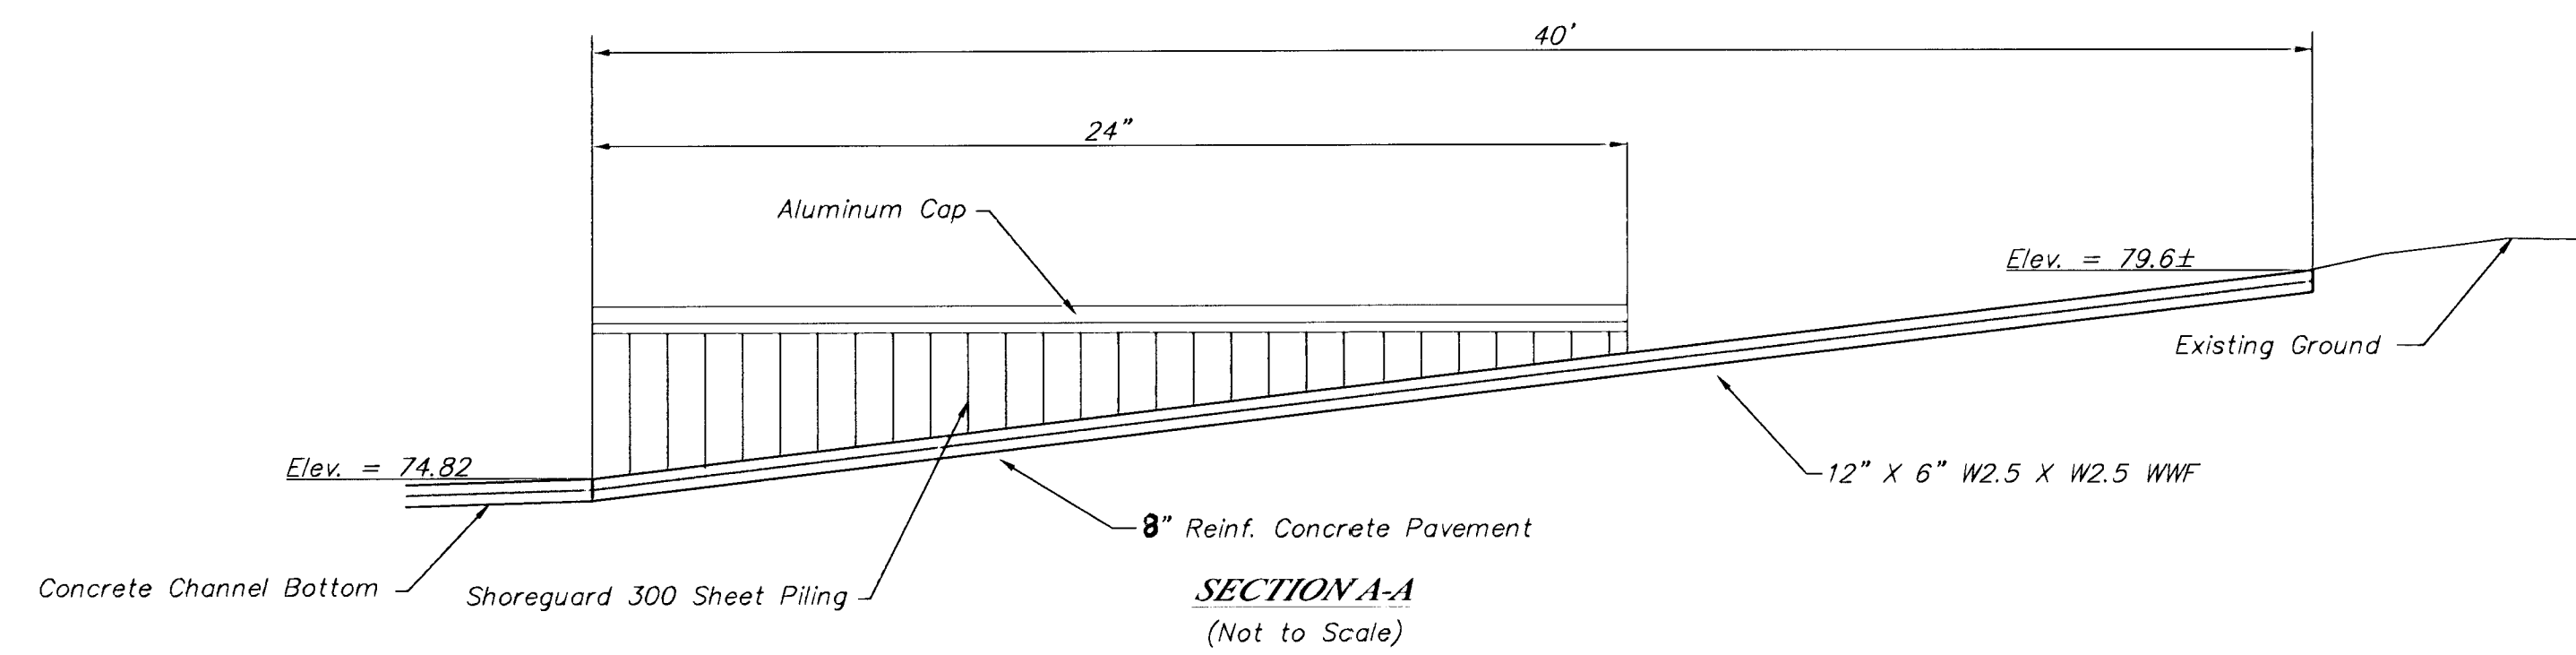

PROJECT NUMBER 472-76-245-83324			SHEET NAME Ramp Detail		ENGINEERING DIRECTORY F:\Hydraulic\Pond		CAPITAL IMPROVEMENT PROJECT REINF. CONCRETE ENTRANCE RAMP AND CHANNEL/POND CONNECTION DETAILS		BAUGHMAN COMPANY, P.A. ENGINEERING, SURVEYING, & PLANNING 316-262-7271 • 315 ELLIS • WICHITA, KANSAS 67211		SHEET 16
DESIGN TPV/JFB	DRAWN TPV	APPROVED JFB	DATE Sept 2001	SCALE Noted	BAUGHMAN NO 99-09-E453		HYDRAULIC AVENUE PAVING - INCIDENTAL DRAINAGE IMPROVEMENTS - PHASE 2				OF 47

F:\Eng\Hydraulic\Pond\Ramp_Detail.dwg Sun Sep 16 10:00:55 2001