
BENCHMARK:

BM #2 – RR Spike in West face of HLP, East side of Hydraulic, South of Fernwood and North of 46th St. South.
Sta. 122+83, 41' Rt.
Elev. = 85.33 (City Datum)

0 5 10

SCALE: 1" = 10'

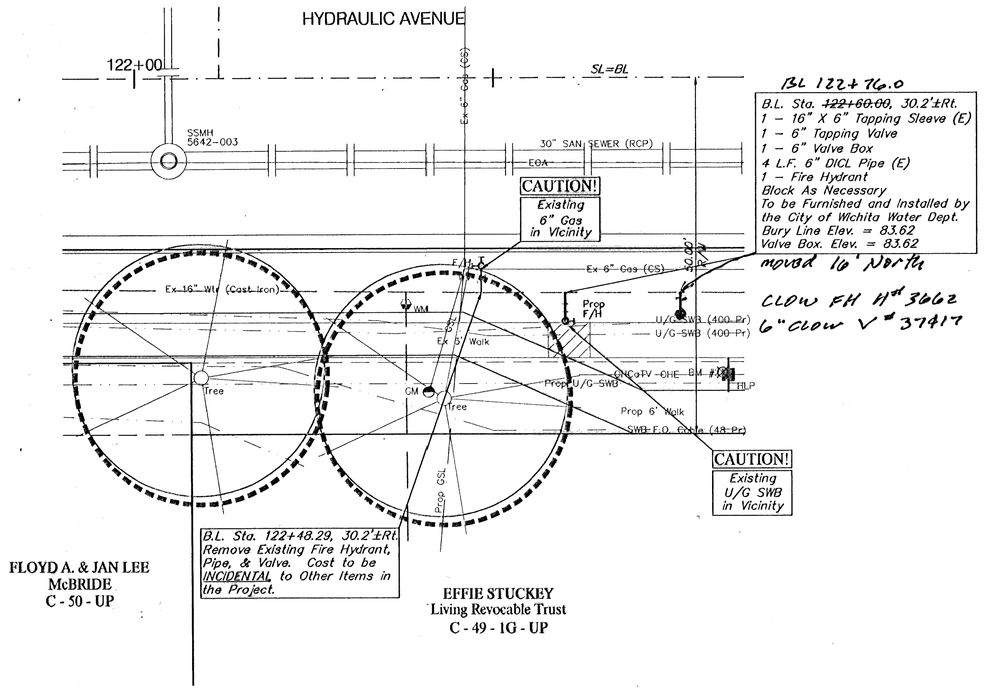

BL 122+76.0

B.L. Sta. ~~122+60.00~~, 30.2'±Rt.
1 – 16" X 6" Tapping Sleeve (E)
1 – 6" Tapping Valve
1 – 6" Valve Box
4 L.F. 6" DICL Pipe (E)
1 – Fire Hydrant
Block As Necessary
To be Furnished and Installed by the City of Wichita Water Dept.
Bury Line Elev. = 83.62
Valve Box. Elev. = 83.62

moved 16' North

CLOW FH H# 3662
6" CLOW V# 37417

B.L. Sta. 122+48.29, 30.2'±Rt. Remove Existing Fire Hydrant, Pipe, & Valve. Cost to be INCIDENTAL to Other Items in the Project.

FLOYD A. & JAN LEE McBRIDE
C - 50 - UP


EFFIE STUCKEY Living Revocable Trust
C - 49 - 1G - UP

BENCHMARK:

BM #9 – City of Wichita Bench Mark Disc, 48.6' South and 32.4' West of Centerlines Hydraulic and Mac Arthur
Sta. 168+35.3, 32.4' Rt.
Elev. = 86.98 (City Datum)

0 5 10

SCALE: 1" = 10'

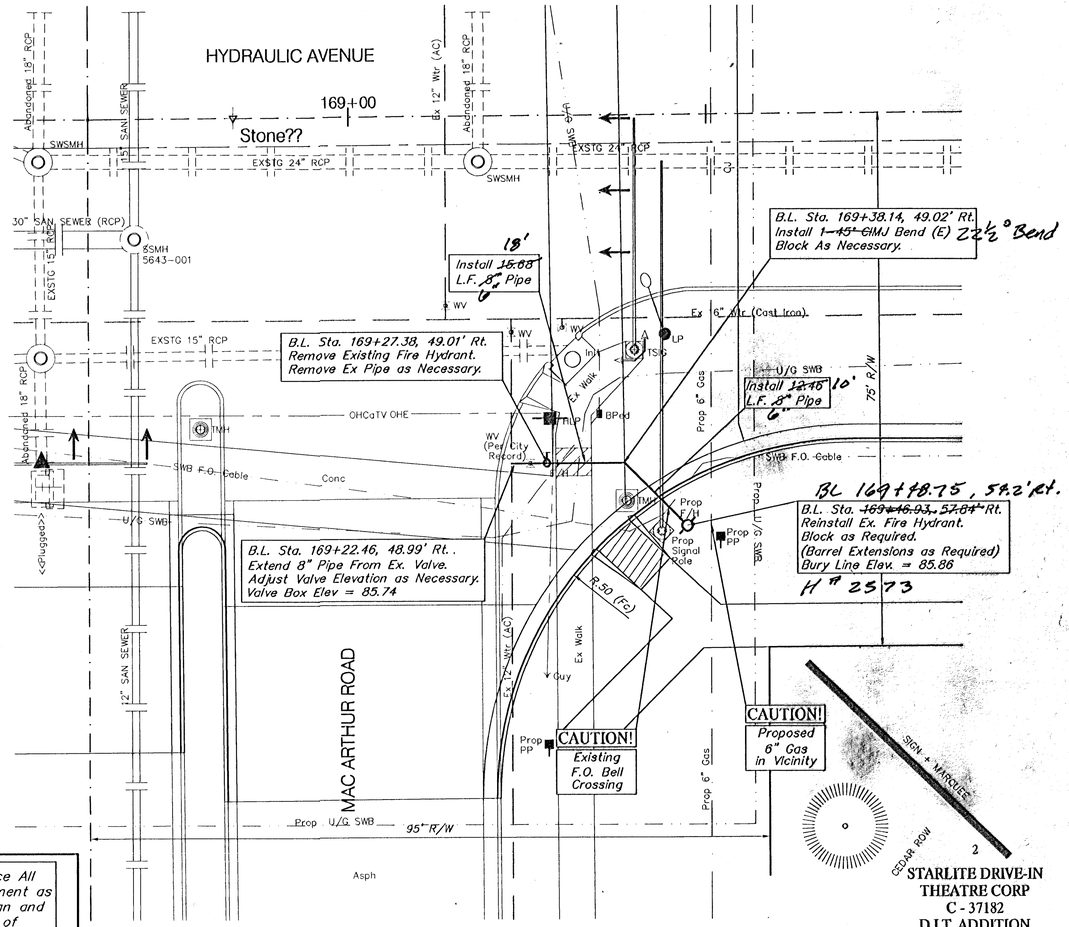

STARLITE DRIVE-IN THEATRE CORP
C - 37182
D.I.T. ADDITION

Contractor Shall Temporarily Replace All Roadway, Drive and Sidewalk Pavement as Necessary to Maintain All Pedestrian and Vehicular Traffic Until Construction of Permanent Pavement is Complete.

Note:
Pavement, Sidewalks, and Etc. To Be Removed Are Indicated By:

PROJECT NUMBER	SHEET NAME	ENGINEERING DIRECTORY
472-76-245-83324	FH02	F:\Eng\Hydraulic\wtr

DESIGN	DRAWN	APPROVED	DATE	SCALE	BAUGHMAN NO
JFB	KWR	JFB	Sept. 2002	Noted	99-09-E450

CAPITAL IMPROVEMENT PROJECT
FIRE HYDRANT RELOCATIONS
HYDRAULIC AVENUE PAVING - 47TH STREET SOUTH TO MACARTHUR ROAD

BAUGHMAN COMPANY, P.A.
ENGINEERING, SURVEYING, & PLANNING
316-262-7271 • 315 ELLIS • WICHITA, KANSAS 67211

SHEET 52 OF 102