PROJECT NO.	SHEET NO.	TOTAL SHEETS
	51	82

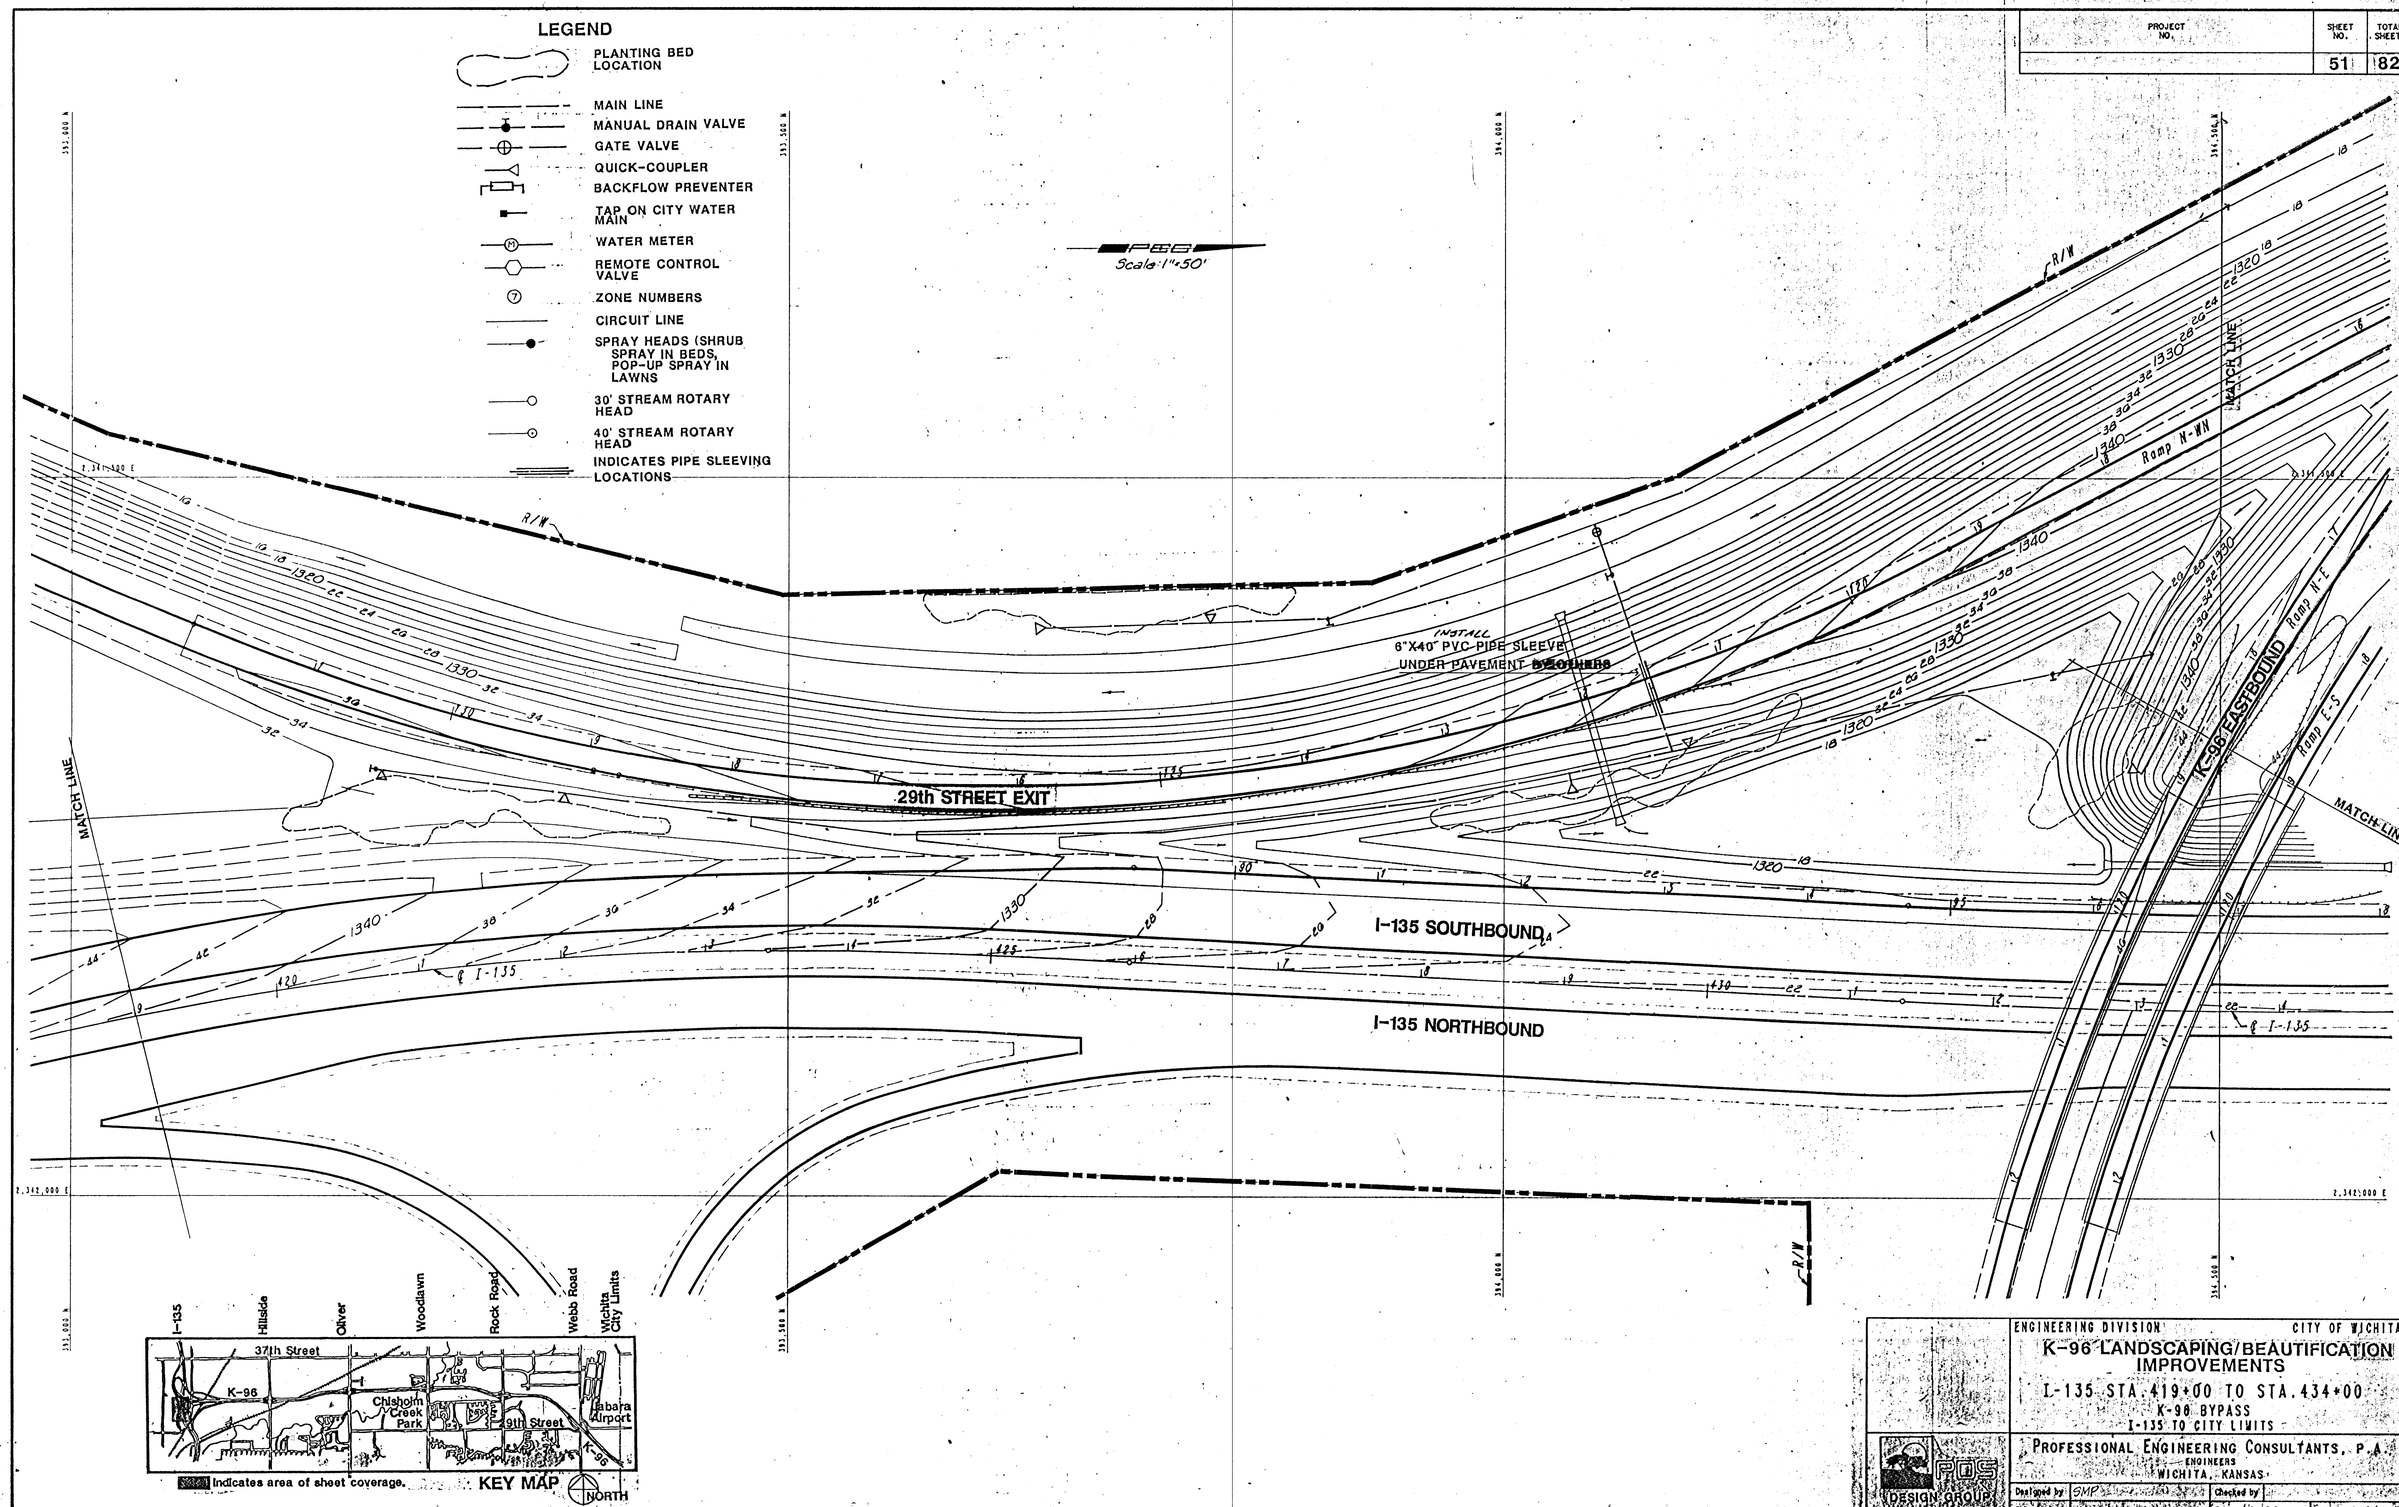

ENGINEERING DIVISION — CITY OF WICHITA

K-96 LANDSCAPING/BEAUTIFICATION IMPROVEMENTS

I-135 STA. 419+00 TO STA. 434+00

K-96 BYPASS
I-135 TO CITY LIMITS

PROFESSIONAL ENGINEERING CONSULTANTS, P.A.
ENGINEERS
WICHITA, KANSAS

POS DESIGN GROUP Wichita, Kansas

Designed by	SMP	Checked by	
Drawn by		Date 4/10/89	Job No. 3064

Rev. 8/4/89