
PROJECT NO.	SHEET NO.	TOTAL SHEETS
	52	82

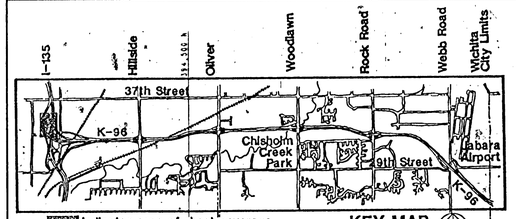

Connect to 12" A.C. Water line on E. side of Ohio St. 660' west of this point. Contractor to reimburse the City for 2 1/2" Tap and Meter. Follow north side of 33rd St. R.O.W.

Scale: 1"=50'

INSTALL 6"X40' PVC PIPE SLEEVE UNDER PAVEMENT ~~BY OTHERS~~

INSTALL 6"X40' PVC PIPE SLEEVE UNDER PAVEMENT ~~BY OTHERS~~

INSTALL 6"X40' PVC PIPE SLEEVE UNDER PAVEMENT ~~BY OTHERS~~

29th STREET EXIT

Ramp H-WN

Ramp E-S

Ramp H-E

Ramp E-N

K-96 EASTBOUND

K-96 WESTBOUND

I-135 SOUTHBOUND

I-135 NORTHBOUND

MATCH LINE

MATCH LINE

MATCH LINE

MATCH LINE

¼ Section Line

Existing R/W

R/W

R/W

395,500 N

2,342,000 E

2,341,500 E

ENGINEERING DIVISION — CITY OF WICHITA

K-96 LANDSCAPING/BEAUTIFICATION IMPROVEMENTS

I-135 STA. 434+00 TO STA. 448+00

K-96 BYPASS
I-135 TO CITY LIMITS

PUS DESIGN GROUP Wichita, Kansas

PROFESSIONAL ENGINEERING CONSULTANTS, P.A.
ENGINEERS
WICHITA, KANSAS

Designed by: SMP	Checked by	
Drawn by	Date 4/10/89 Rev. 8/4/89	Job No. 3064