PROJECT NO.	SHEET NO.	TOTAL SHEETS
	54	82

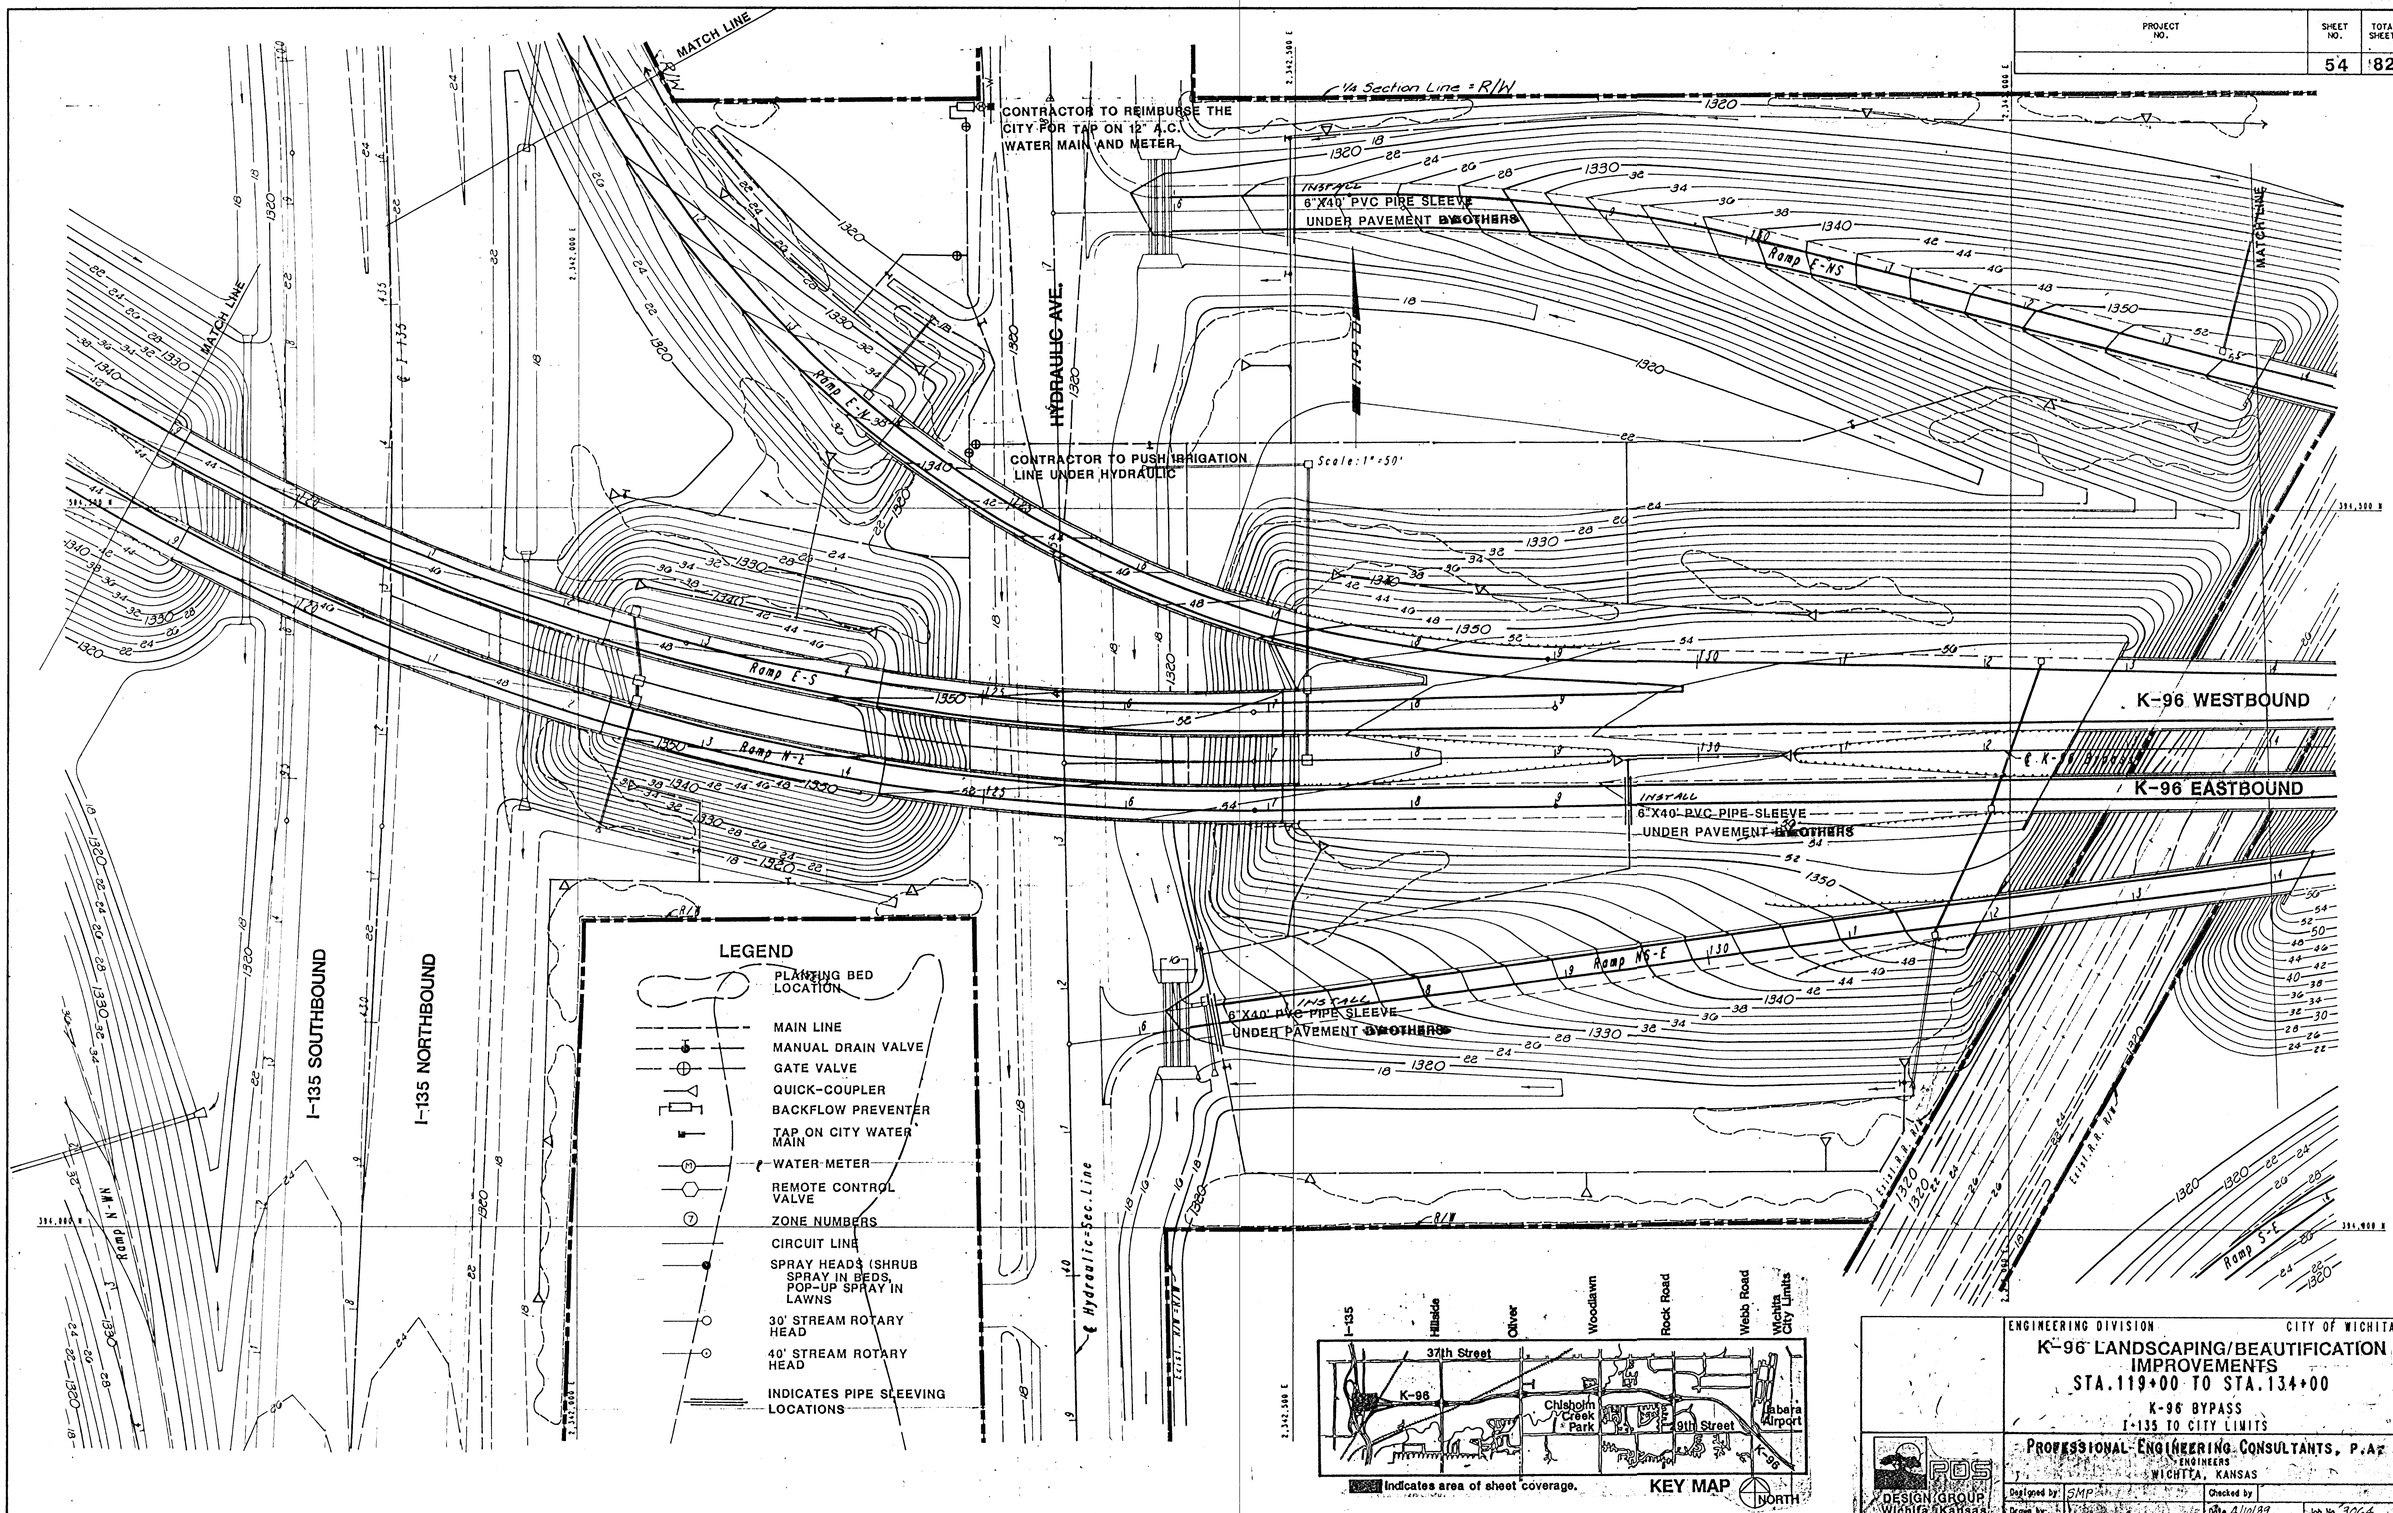

ENGINEERING DIVISION — CITY OF WICHITA

K-96 LANDSCAPING/BEAUTIFICATION IMPROVEMENTS
STA.119+00 TO STA.134+00

K-96 BYPASS
I-135 TO CITY LIMITS

PROFESSIONAL ENGINEERING CONSULTANTS, P.A.
ENGINEERS
WICHITA, KANSAS

PDS DESIGN GROUP Wichita, Kansas

Designed by: SMP	Checked by	
Drawn by	Date 4/10/89	Job No. 3064

Rev. 8/4/89