



**OUTSIDE PROJECT LIMITS**

Scale: 1"=50'

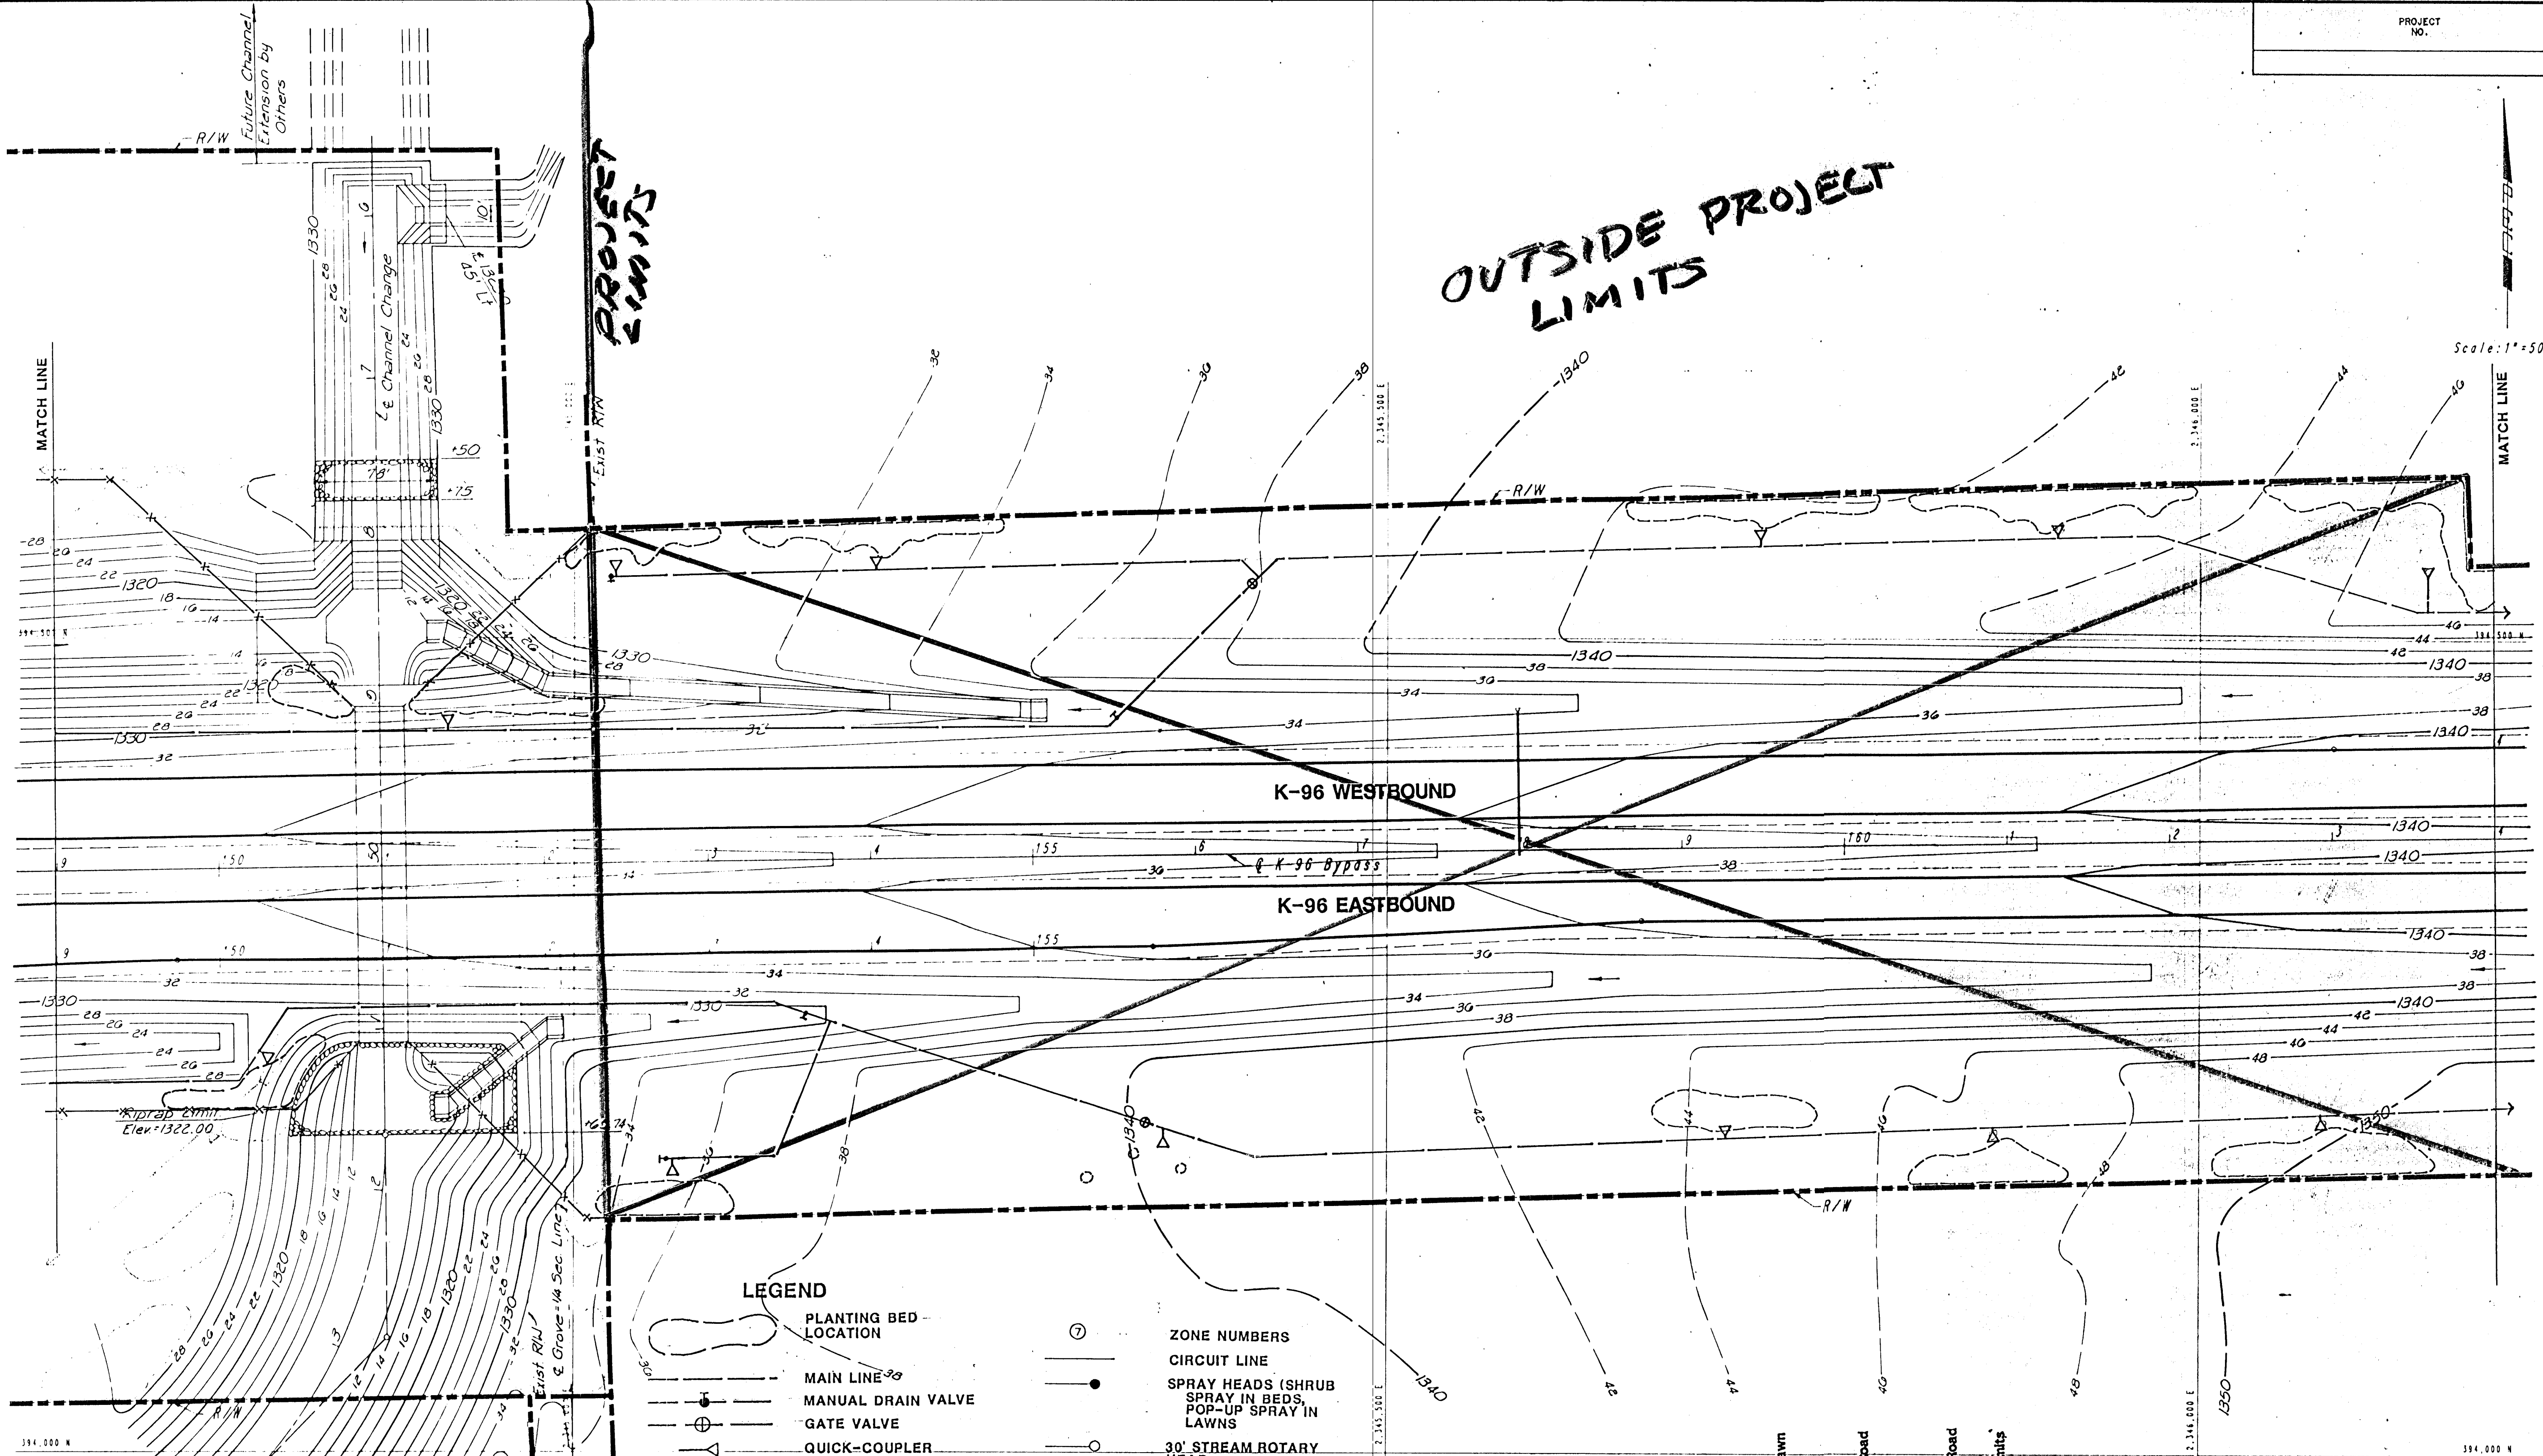

**LEGEND**

- |  |                        |  |  |
|--|------------------------|--|--|
|  | PLANTING BED LOCATION  |  | ZONE NUMBERS   |
|  | MAIN LINE              |  | CIRCUIT LINE   |
|  | MANUAL DRAIN VALVE     |  | SPRAY HEADS (SHRUB SPRAY IN BEDS, POP-UP SPRAY IN LAWNS) |
|  | GATE VALVE             |  | 30' STREAM ROTARY HEAD                                   |
|  | QUICK-COUPLER          |  | 40' STREAM ROTARY HEAD                                   |
|  | BACKFLOW PREVENTER     |  | INDICATES PIPE SLEEVING LOCATIONS                        |
|  | TAP ON CITY WATER MAIN |  |  |
|  | WATER METER            |  |  |
|  | REMOTE CONTROL VALVE   |  |  |

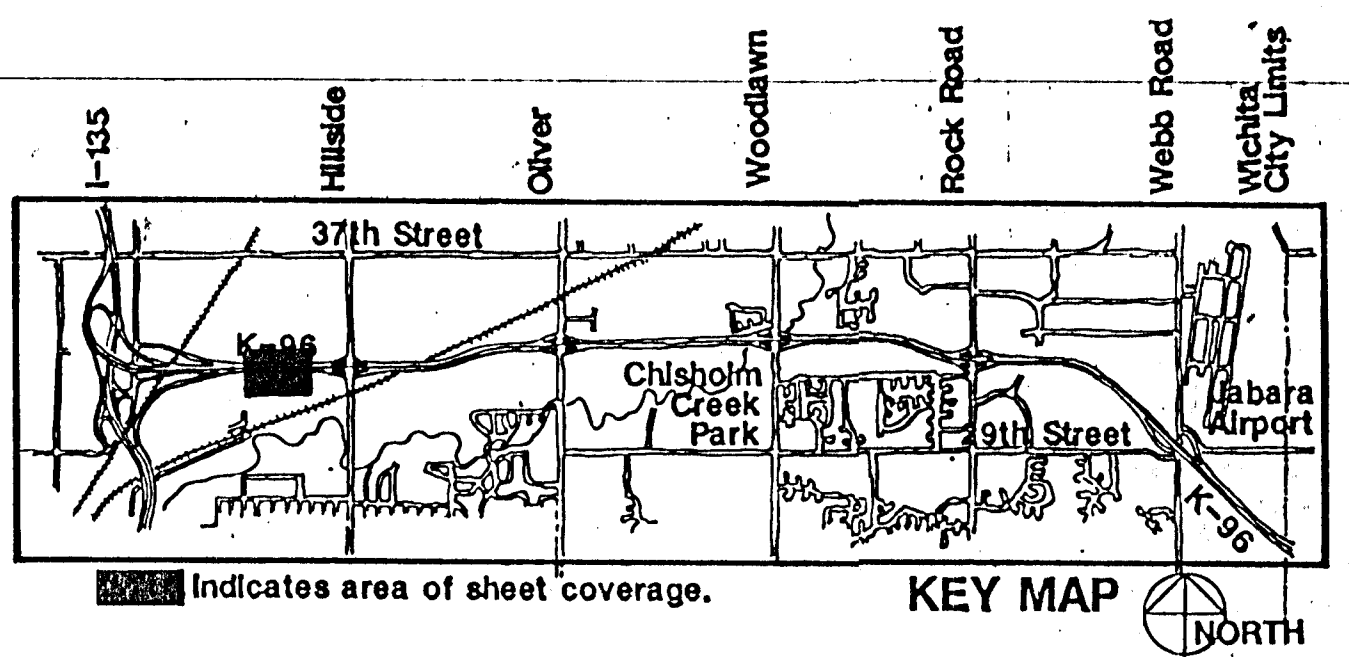

ENGINEERING DIVISION CITY OF WICHITA  
**K-96 LANDSCAPING/BEAUTIFICATION IMPROVEMENTS**  
 STA. 149+00 TO STA. 164+00  
 K-96 BYPASS  
 I-135 TO CITY LIMITS  
 PROFESSIONAL ENGINEERING CONSULTANTS, P.A.  
 ENGINEERS  
 WICHITA, KANSAS

Designed by	SMP	Checked by	
Drawn by		Date	4/10/89
		Job No.	3064
		Rev.	01/189