




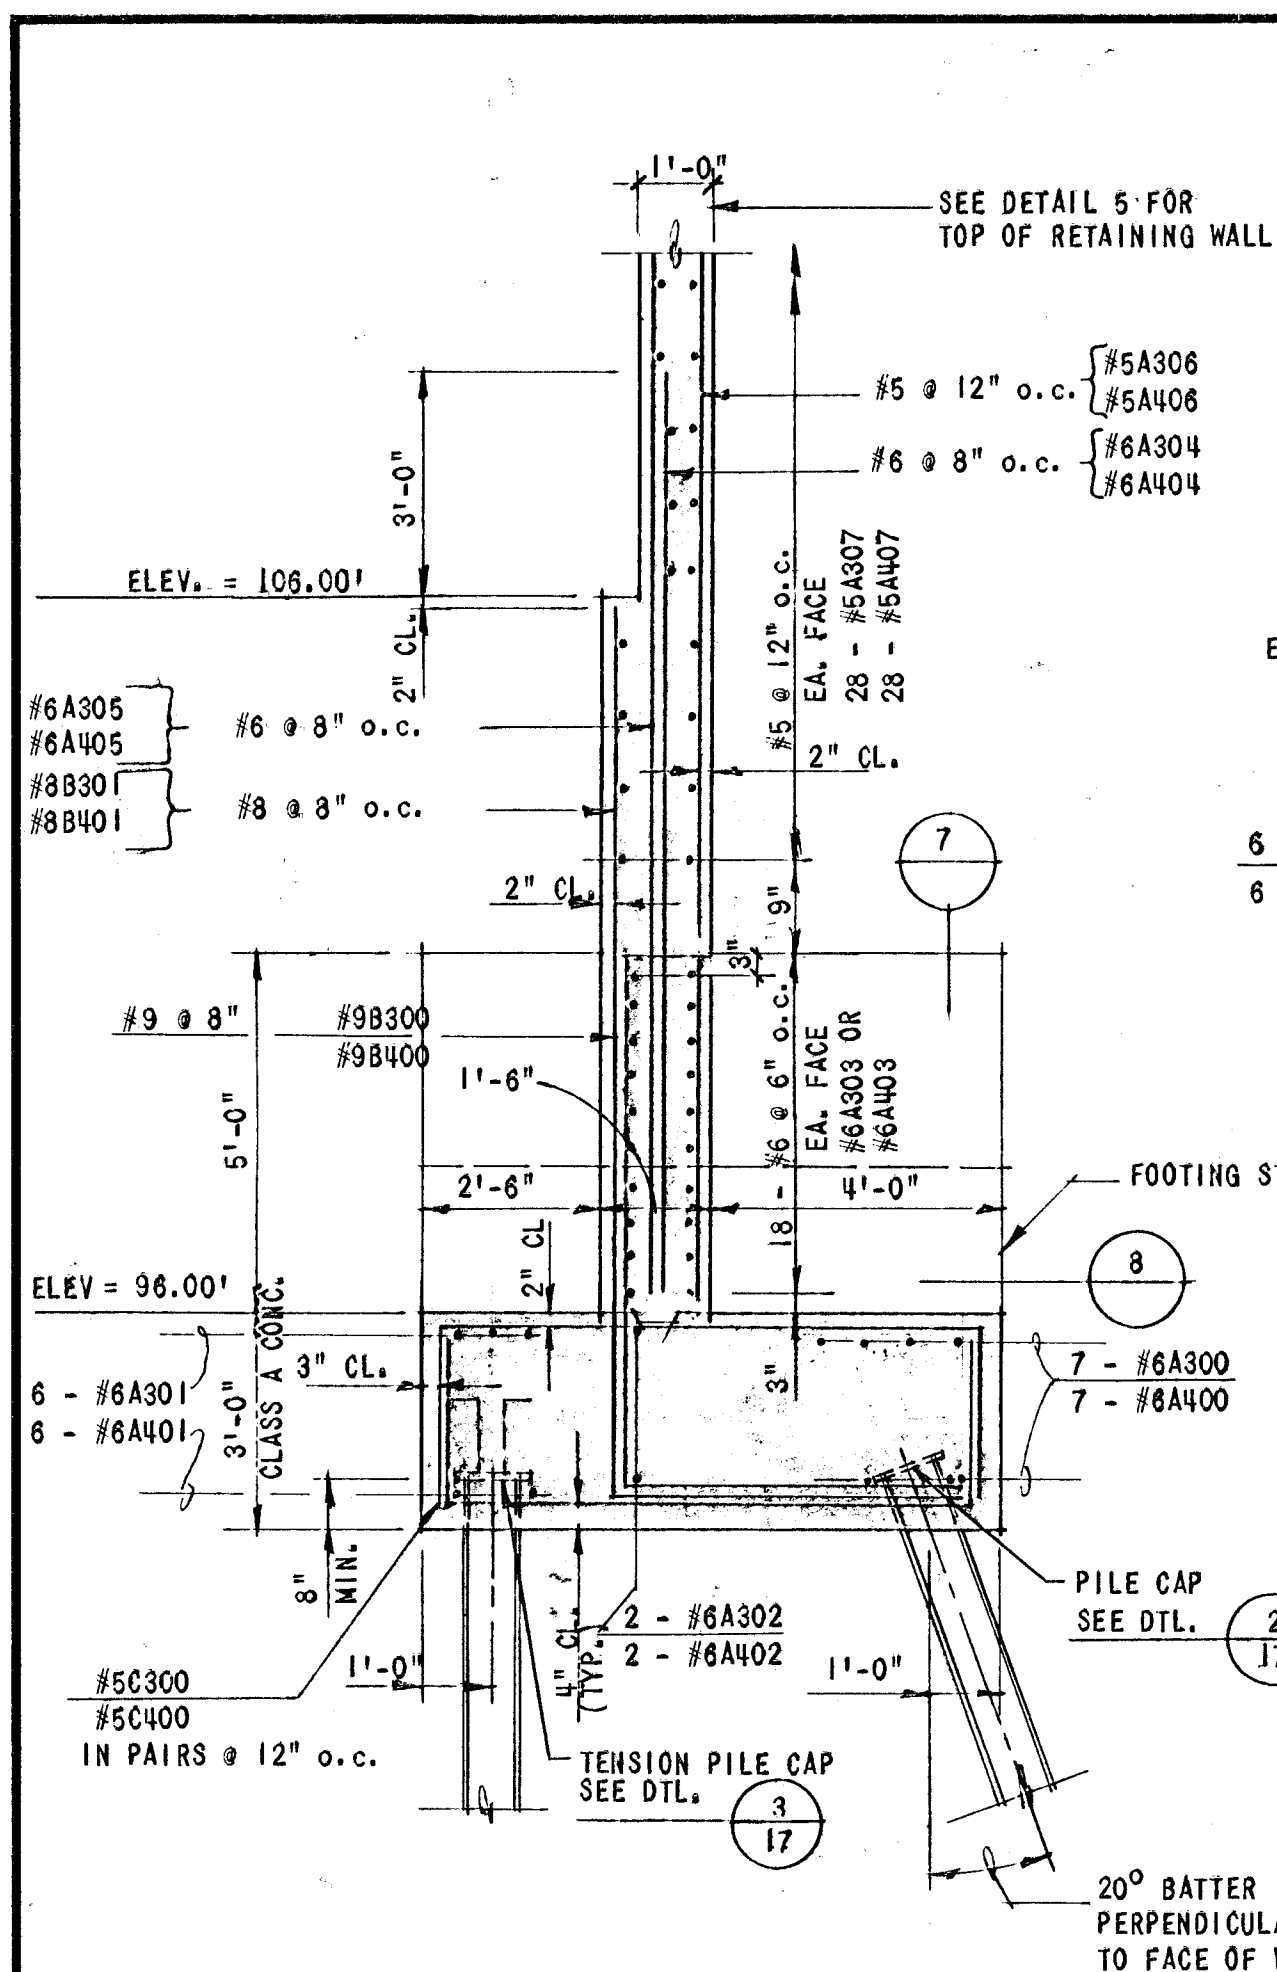


RETAINING WALL SECTION 1
3/8" = 1'-0"

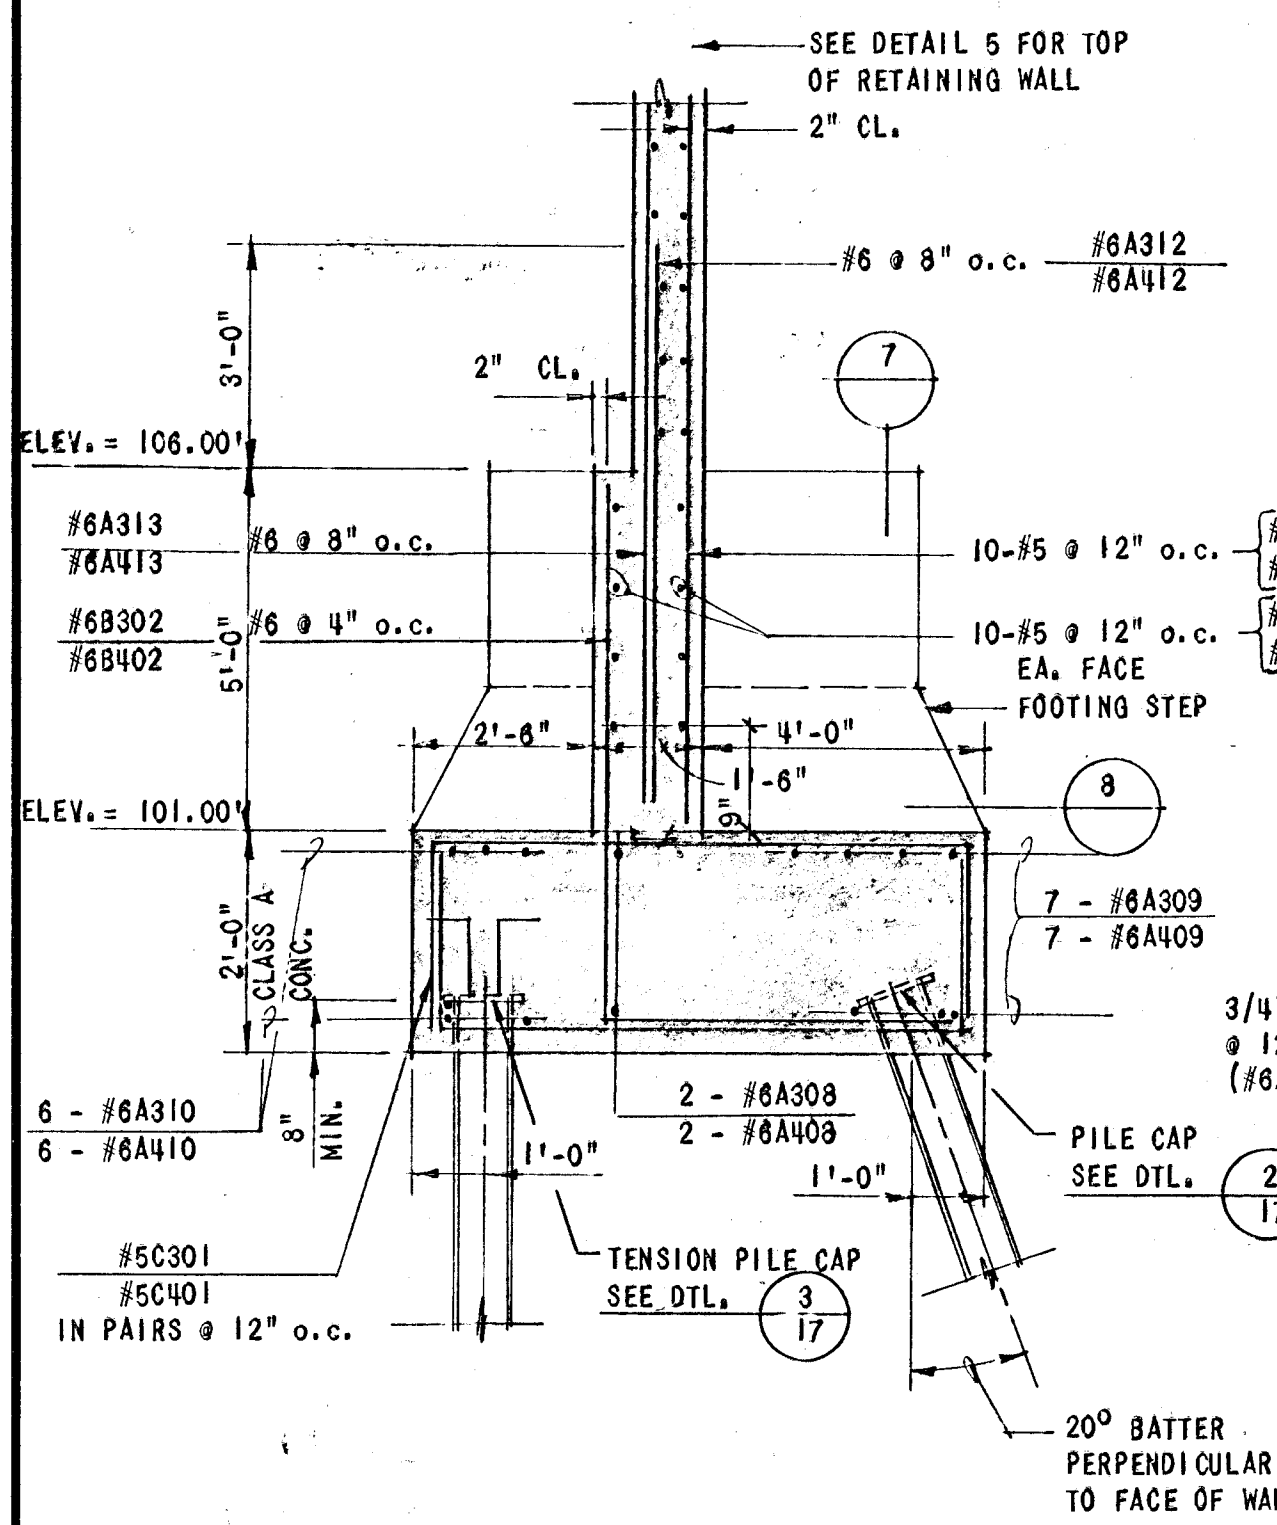


RETAINING WALL SECTION 2
3/8" = 1'-0"

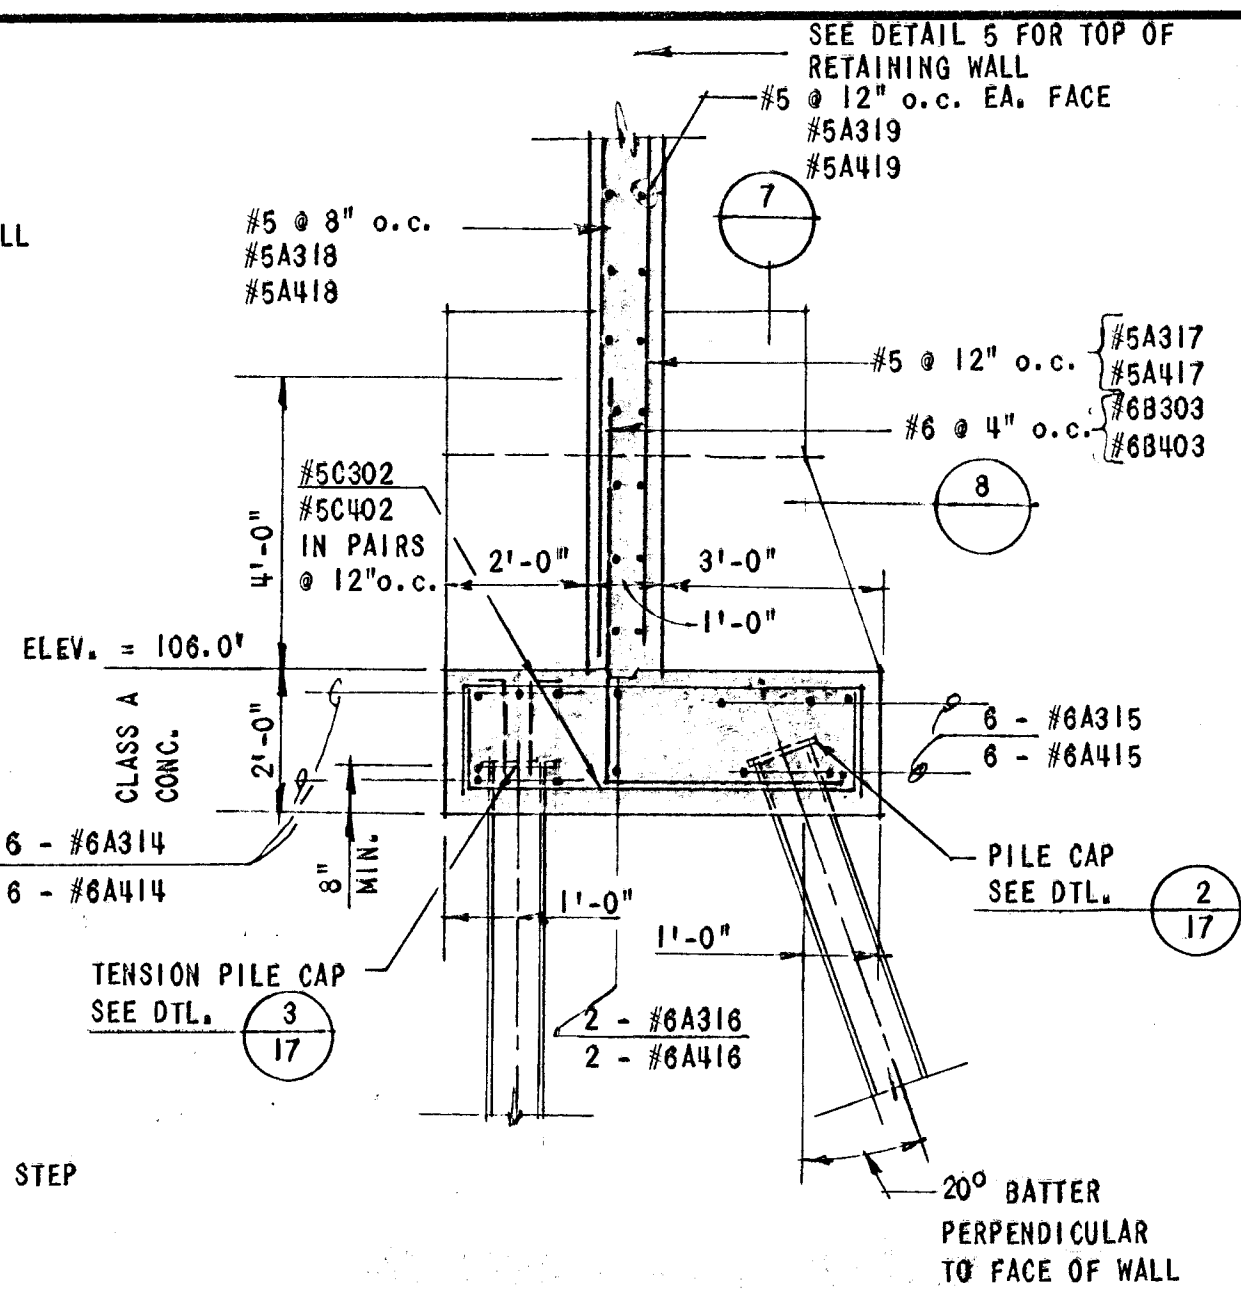


RETAINING WALL SECTION 3
3/8" = 1'-0"

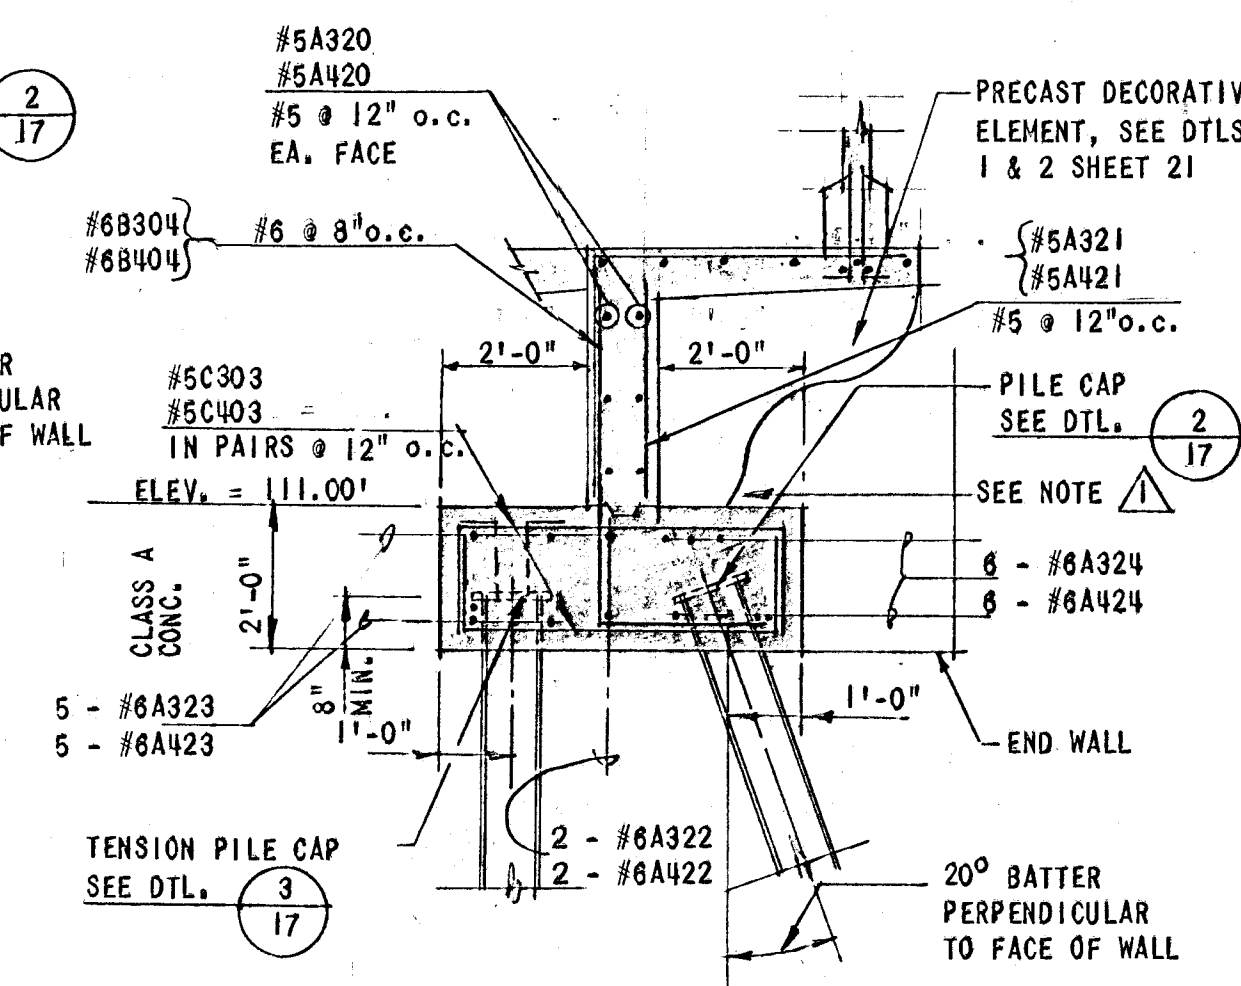


RETAINING WALL SECTION 4
3/8" = 1'-0"

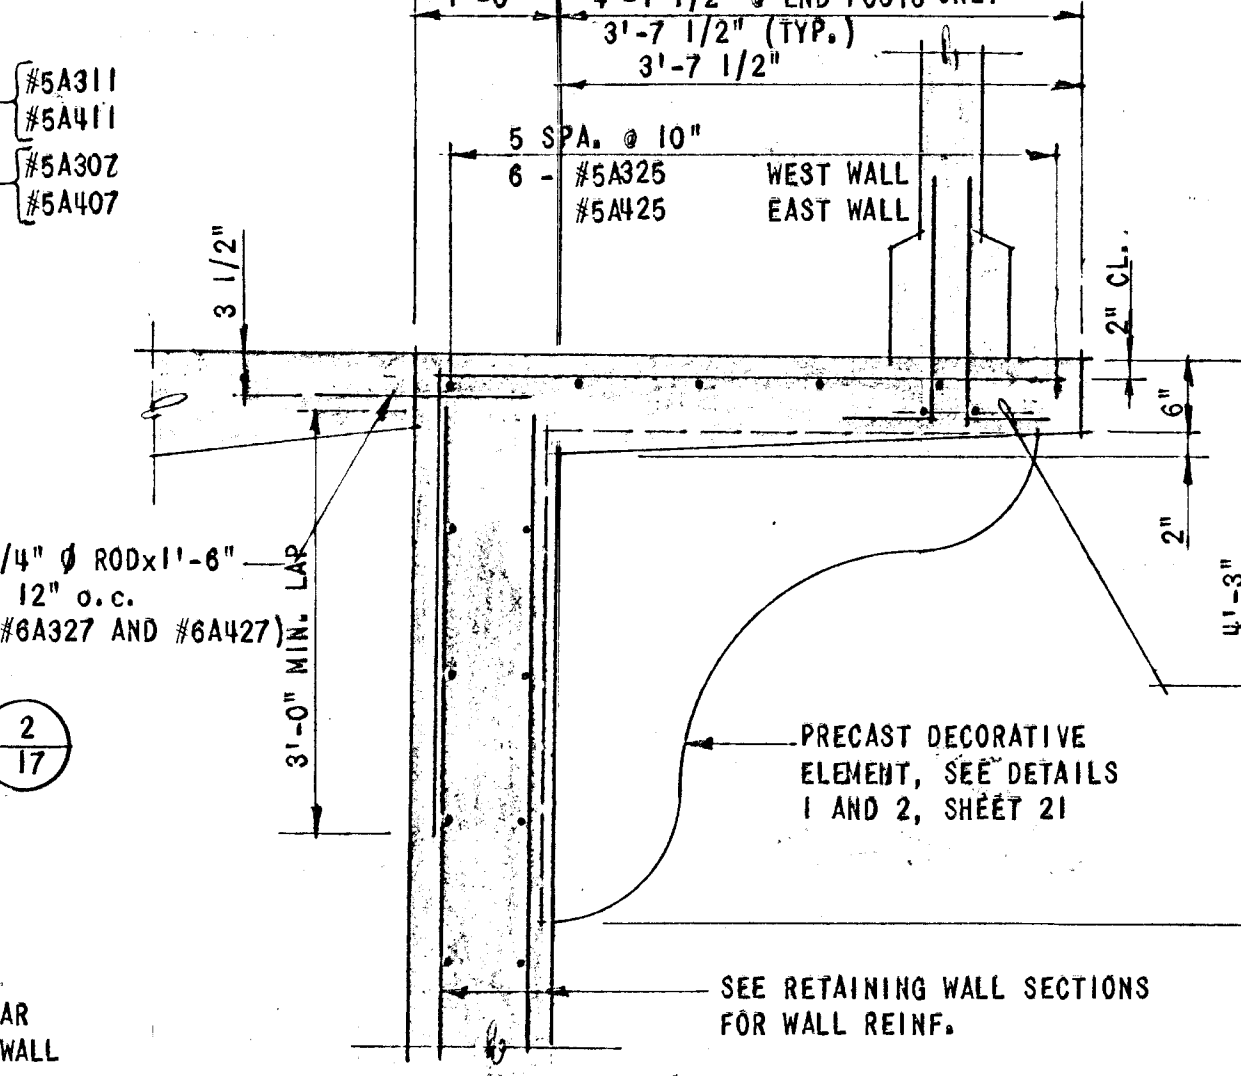


SIDEWALK ON RETAINING WALL DETAIL 5
3/4" = 1'-0"

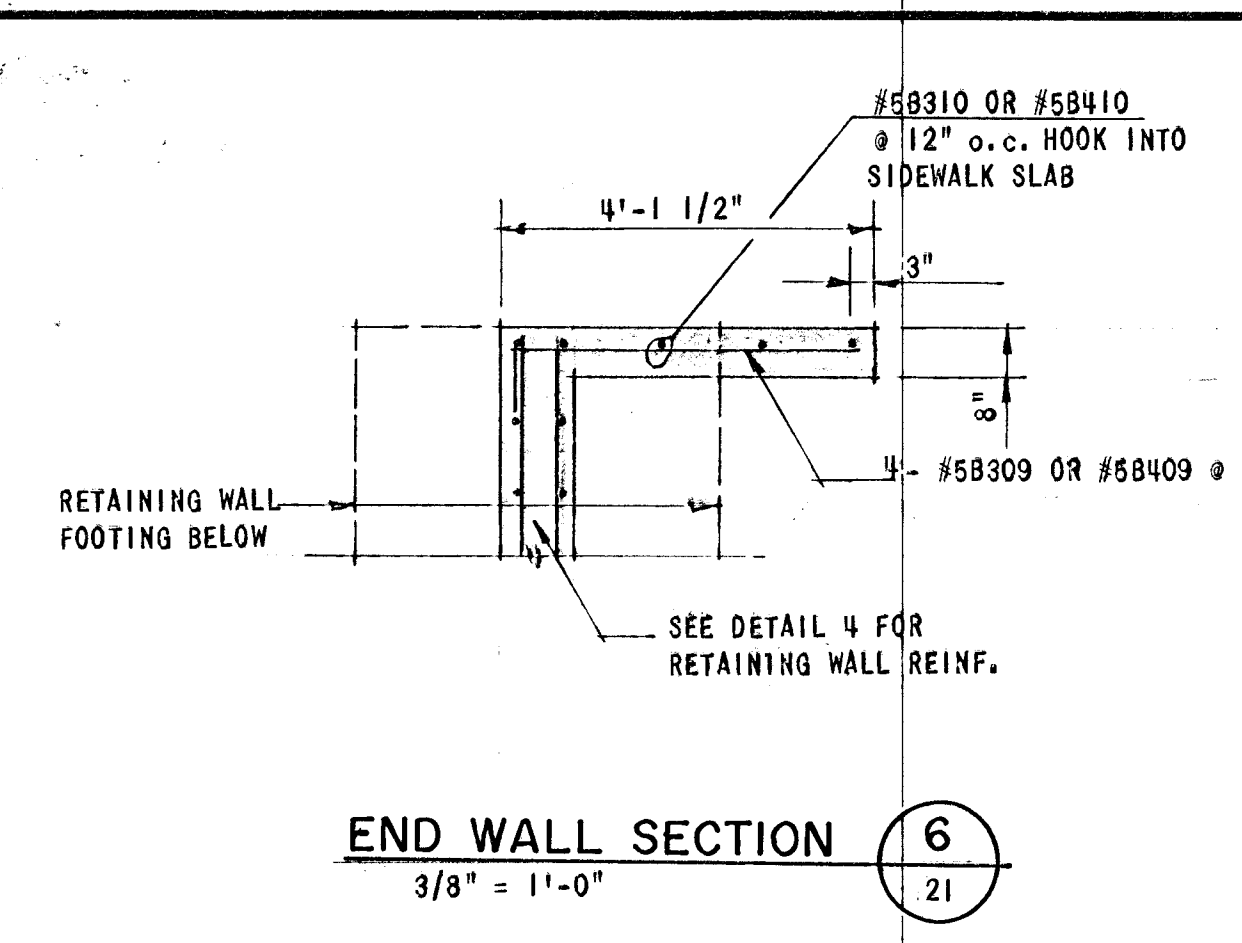

END WALL SECTION 6
3/8" = 1'-0"

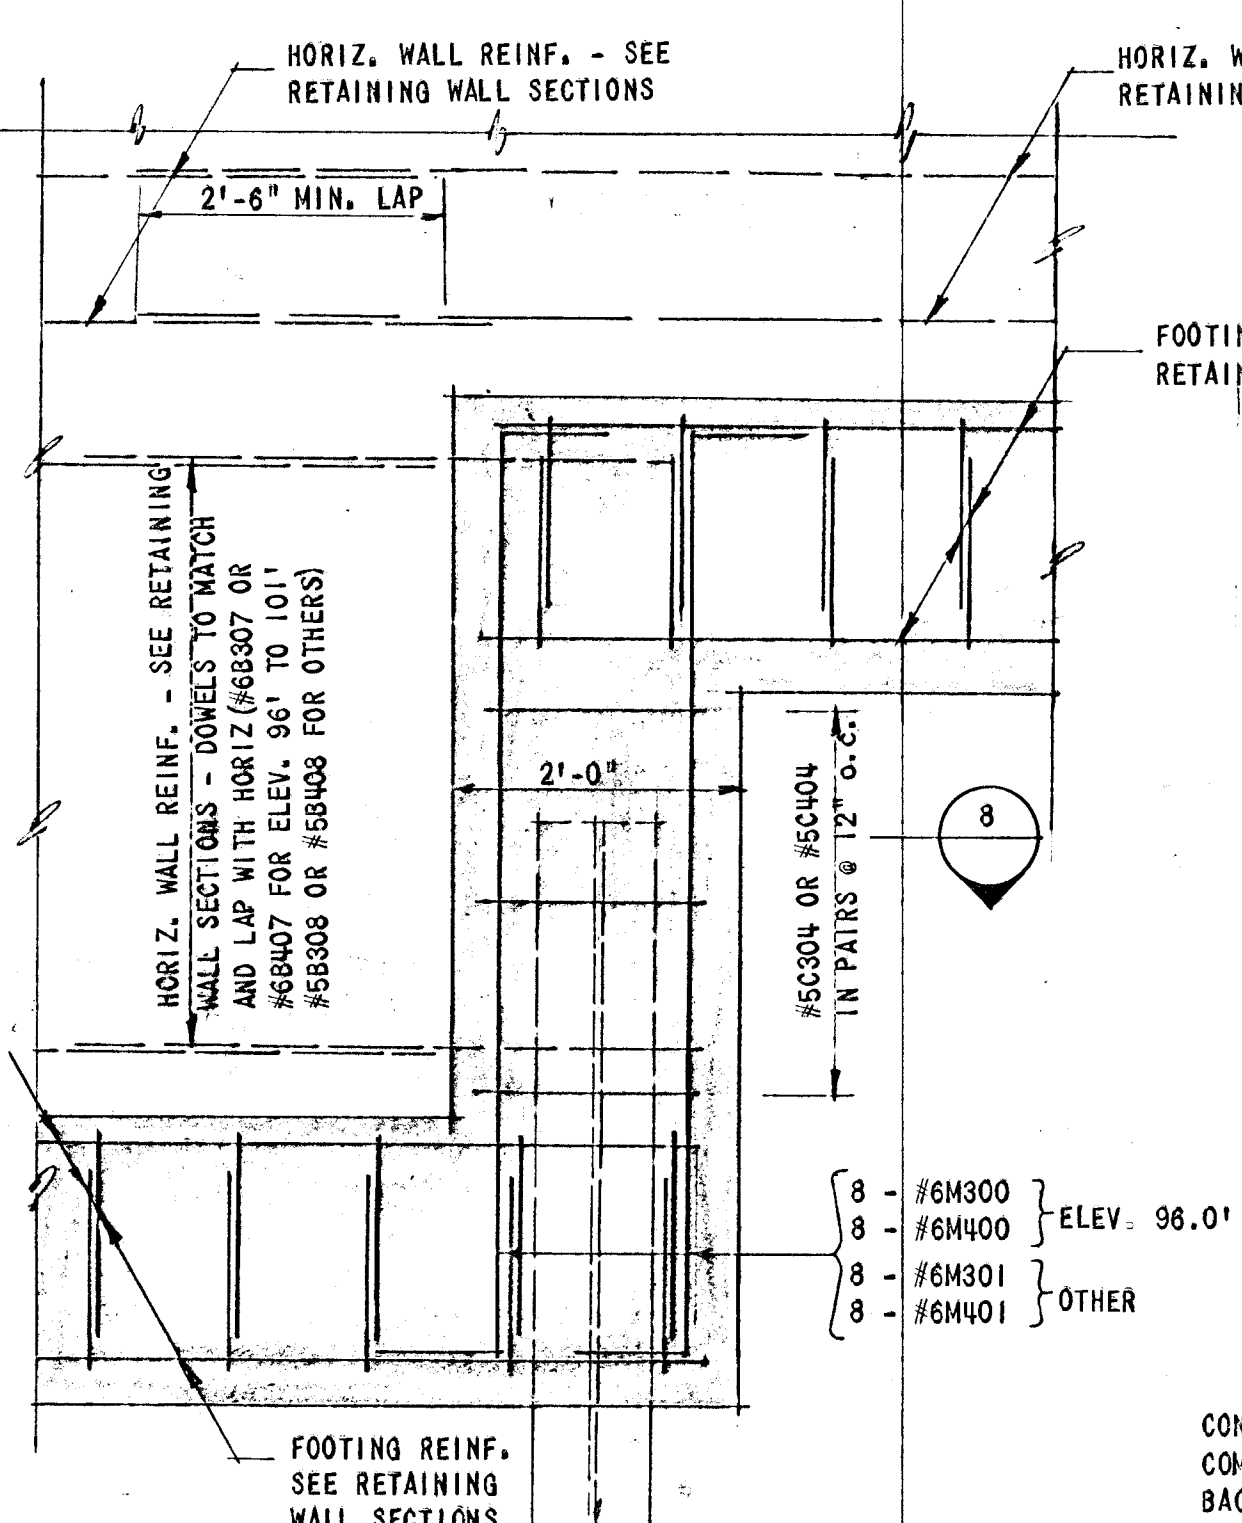

RETAINING WALL STEPPED FOOTING SECTION 7
3/4" = 1'-0"

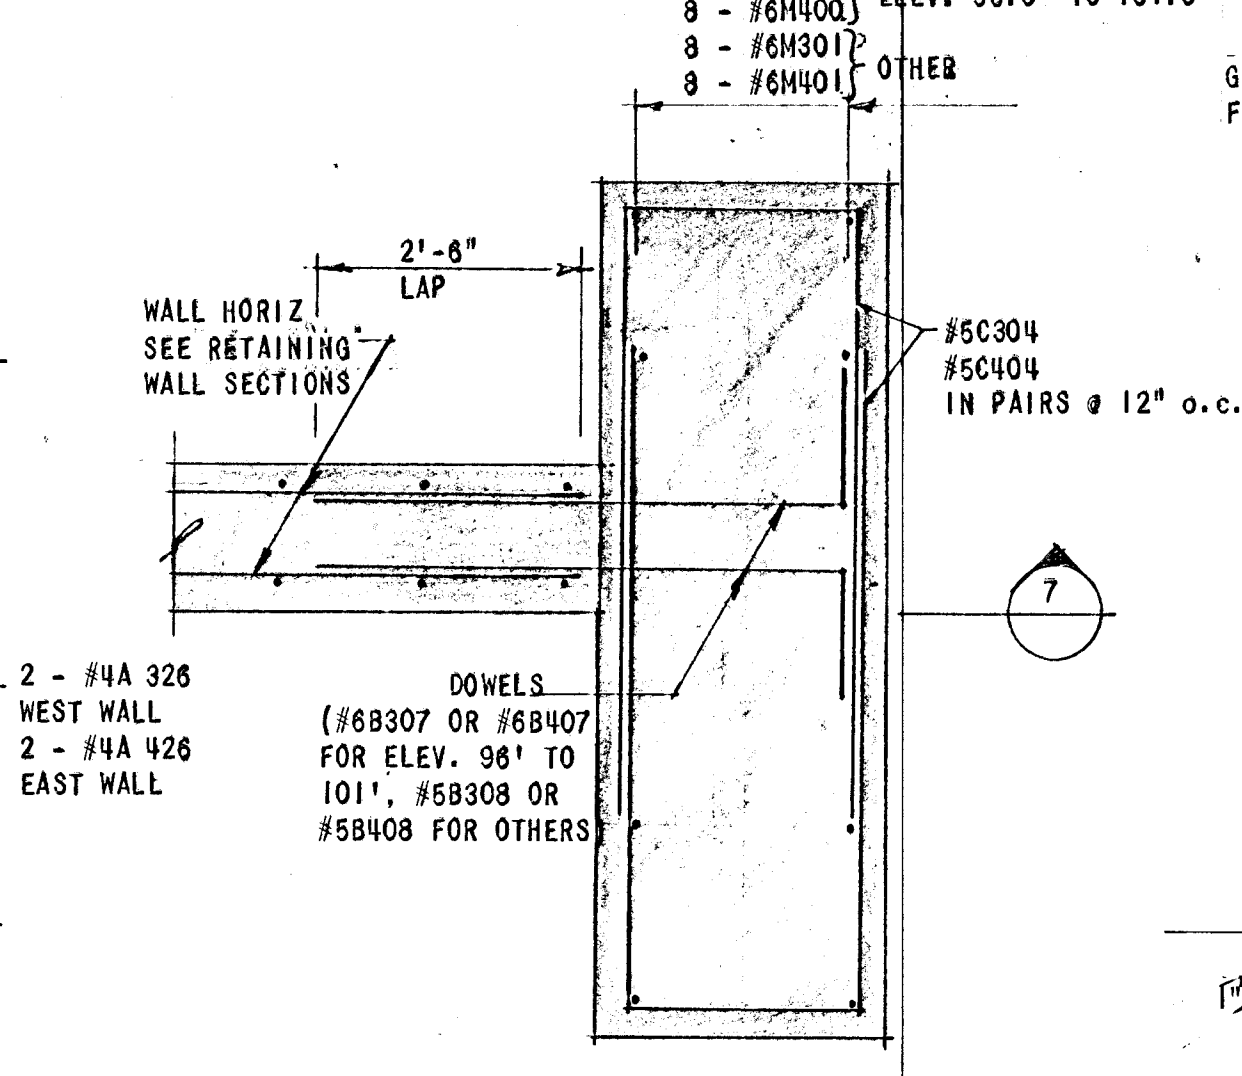

STEPPED FOOTING SECTION 8
3/4" = 1'-0"

- 26" O.D. x 24" O.D. .375" W.T. WELDING REDUCER
- 24" O.D. x 42" LONG .375" W.T. STEEL PIPE
- 24" 150 LB. FLAT FACED FORGED STEEL SLIP-ON FLANGE, FACE OF FLANGE TO BE GROUNDED SMOOTH.
- 24" D.I. FLANGED BASE 90° BEND
- 8" SCH. 40 PE STEEL PIPE WITH TWO 8" 150 LB FLAT FACED SLIP ON FLANGES. FACE OF FLANGE TO BE GROUNDED SMOOTH (LENGTH TO BE DETERMINED IN FIELD)
- 24" O.D. .375 W.T. STEEL PIPE (LENGTH TO BE DETERMINED IN FIELD)
- 24" O.D. FL. x PE x 33 1/2" LONG.

