


FHWA REGION NO.	STATE	PROJECT NO.	YEAR	SHEET NUMBER	TOTAL SHEETS
7	KANSAS	01-87 K-5985-01	1997	13	18

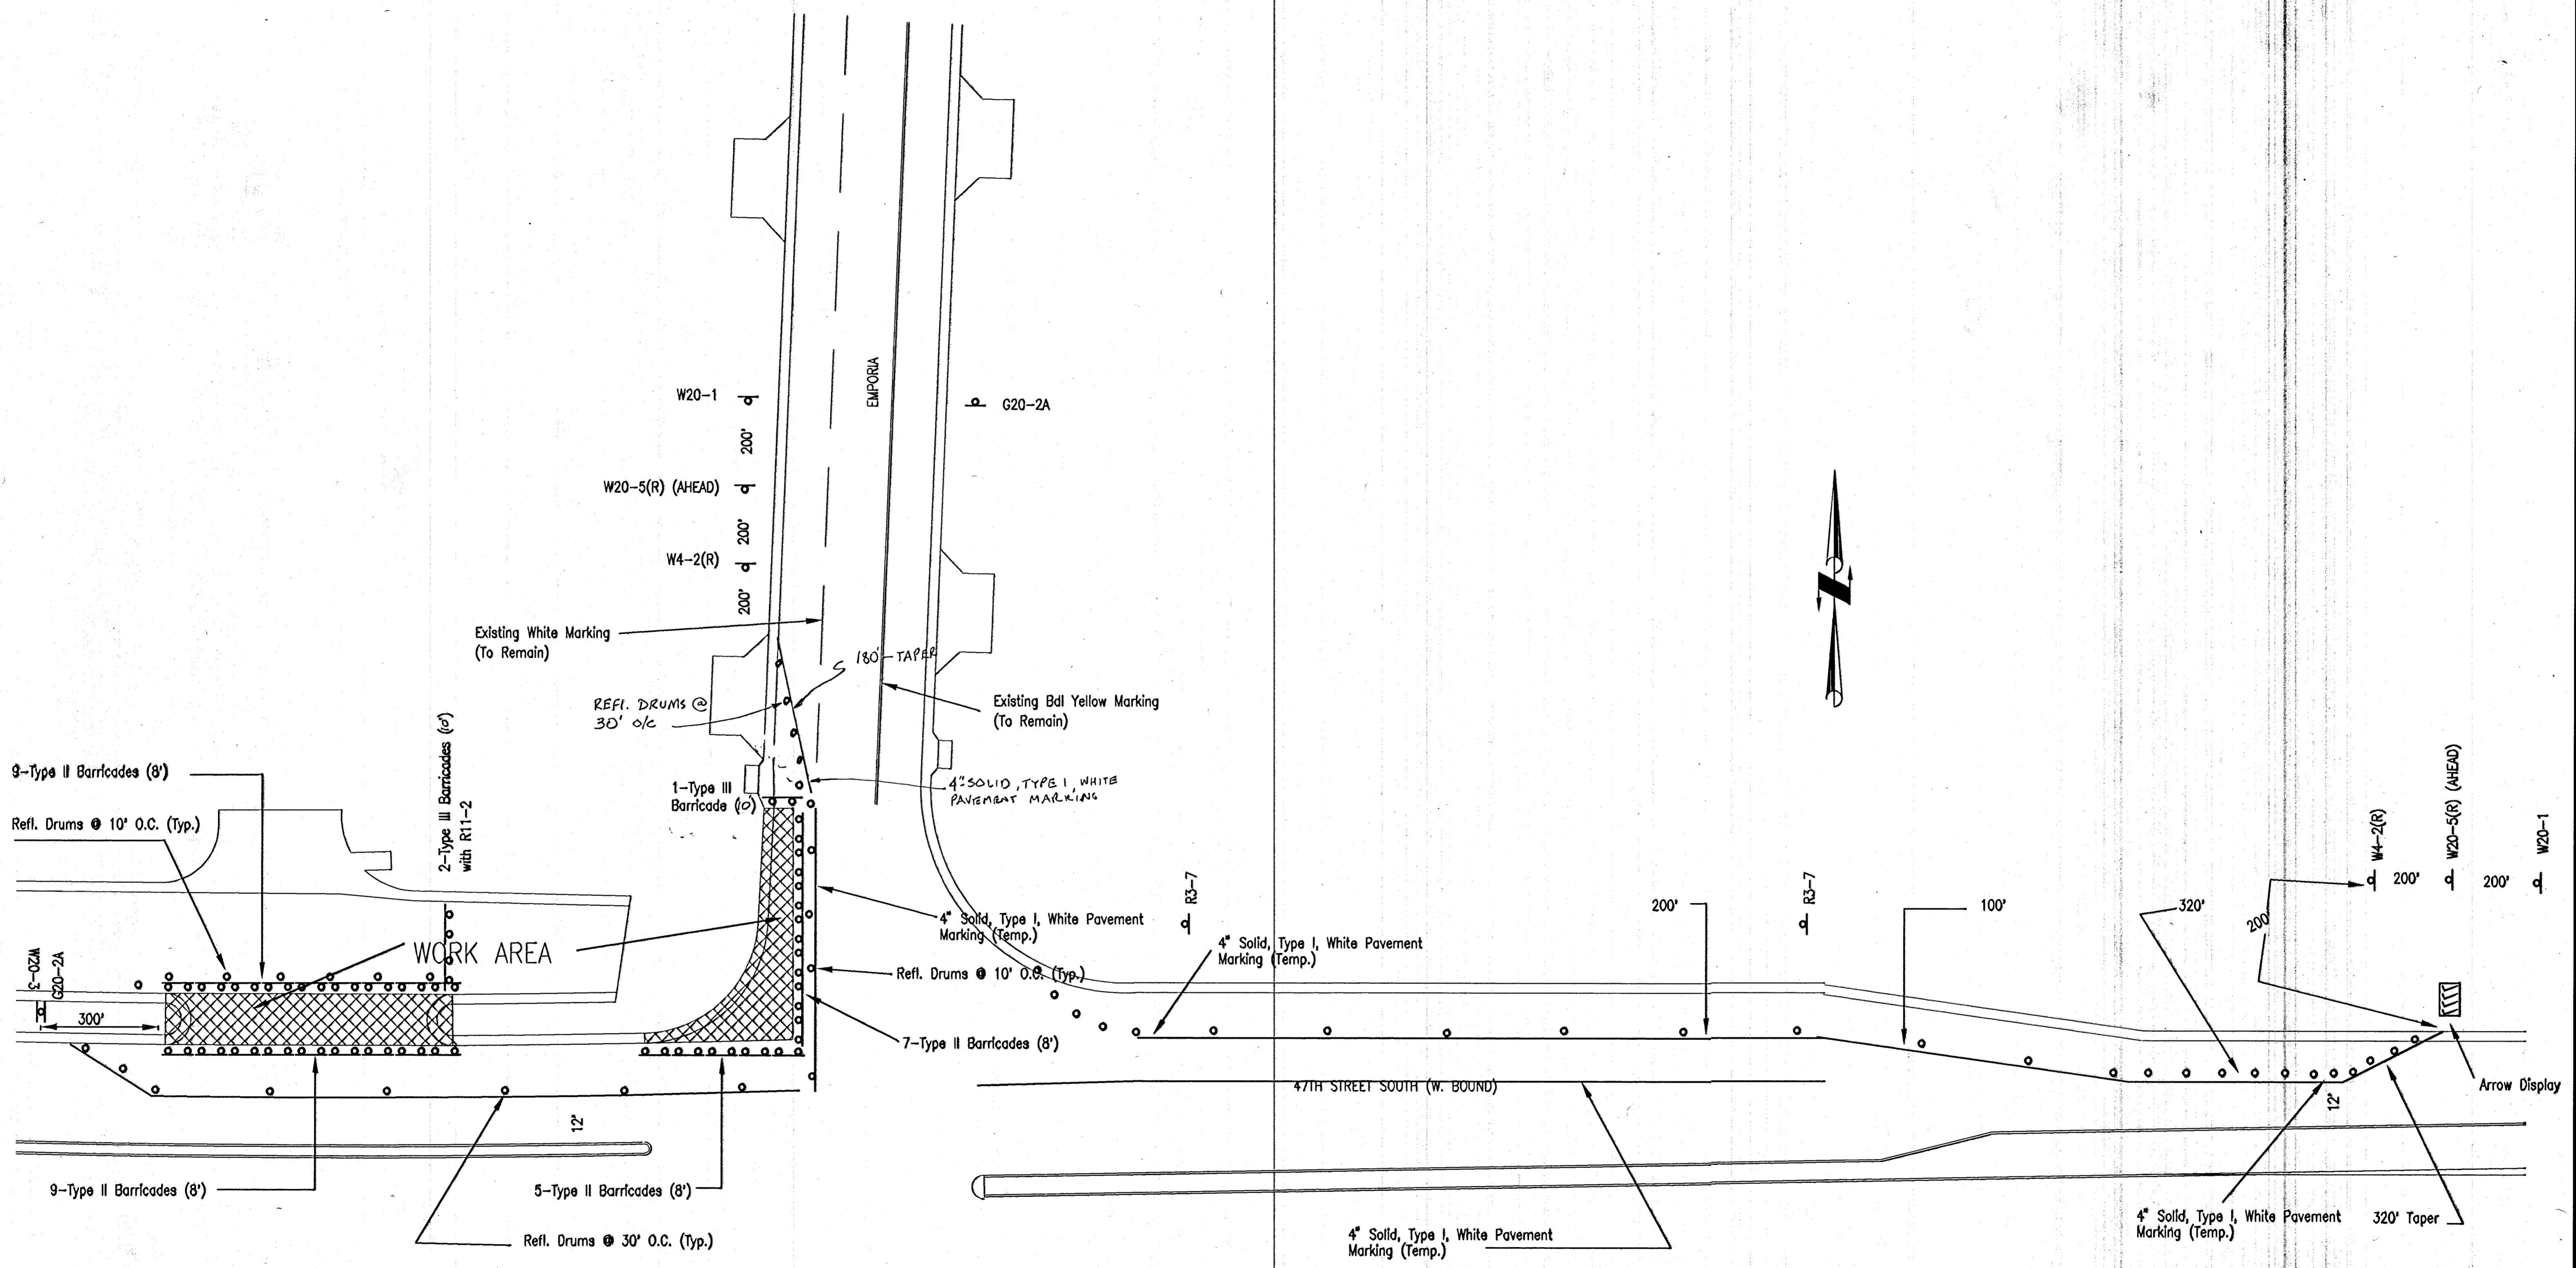

**47TH STREET SOUTH & EMPORIA
CONSTRUCTION TRAFFIC CONTROL PLAN**

SCALE:	APPROVED:	DRAWN BY:
DATE:	CHECKED:	SHEET NO.:
PROJECT NO.:		

MUNICIPAL ENGINEERS
208 - LAURA, SUITE 201
VICTORIA, KANSAS 67511
318 - 208 - 3011

W20-1

G20-2A