

STATE	PROJECT NO.	YEAR	SHEET NO.	TOTAL SHEETS
KANSAS	472-83537	2003	15	73

GENERAL NOTE

Combined curb and gutter or gutter adjoining concrete pavement may, at the contractor's option, be poured either monolithically or separately, using either the mix used in the concrete pavement or Grade 25 Concrete (AE). The combined curb and gutter or gutter shall have the same section as shown on the plans. If poured monolithically, dowel bars may be omitted from the combined curb and gutter or gutter, but the wire mesh shall be extended to 150 mm or less from the back of the curb or gutter. Pavement joints shall be continued through curb or gutter and no other planes of weakness will be required. Joints in the combined curb and gutter or gutter are to be filled with the same material as used for the pavement joints.

Expansion joints in the combined curb and gutter are to be placed opposite expansion joints in the pavement.

Where combined curb and gutter does not abut concrete pavement or concrete base course, omit tie bars and longitudinal construction joint and place a 25 mm pre-moulded Expansion Joint Filler (Nonextruding, Type B) cut to the dimensions of the combined curb and gutter or gutter, at a spacing not to exceed 75 m and at the ends of curb returns.


Where combined curb and gutter or gutter is adjacent to bituminous construction, planes of weakness shall be constructed at 6 m intervals.

A 1 200 mm length of transition from normal gutter section to the tapered gutter section shall be used at the ends of each run of gutter except where the gutter abuts a curb, such as at the end of a bridge. Inlets shall be located so as not to fall within this transition section.

Where pressure relief joint (Urethane Foam) is placed across the pavement, and gutter or curb and gutter is continued on for more than 3 m, use Type B, nonextruding, joint filler through gutter section, shaped to fit gutter or curb and gutter. Material may be solid Type B, approximately 100 mm thick, or other thickness pieces (Type B), bonded together with cold mastic or other material, as approved by the Engineer.


For expansion joint treatment where combined curb and gutter or gutter abuts a bridge wing on a U type abutment see bridge drawings.

Longitudinal joints shall be sawed and sealed with joint sealant. See Special Provisions for type.

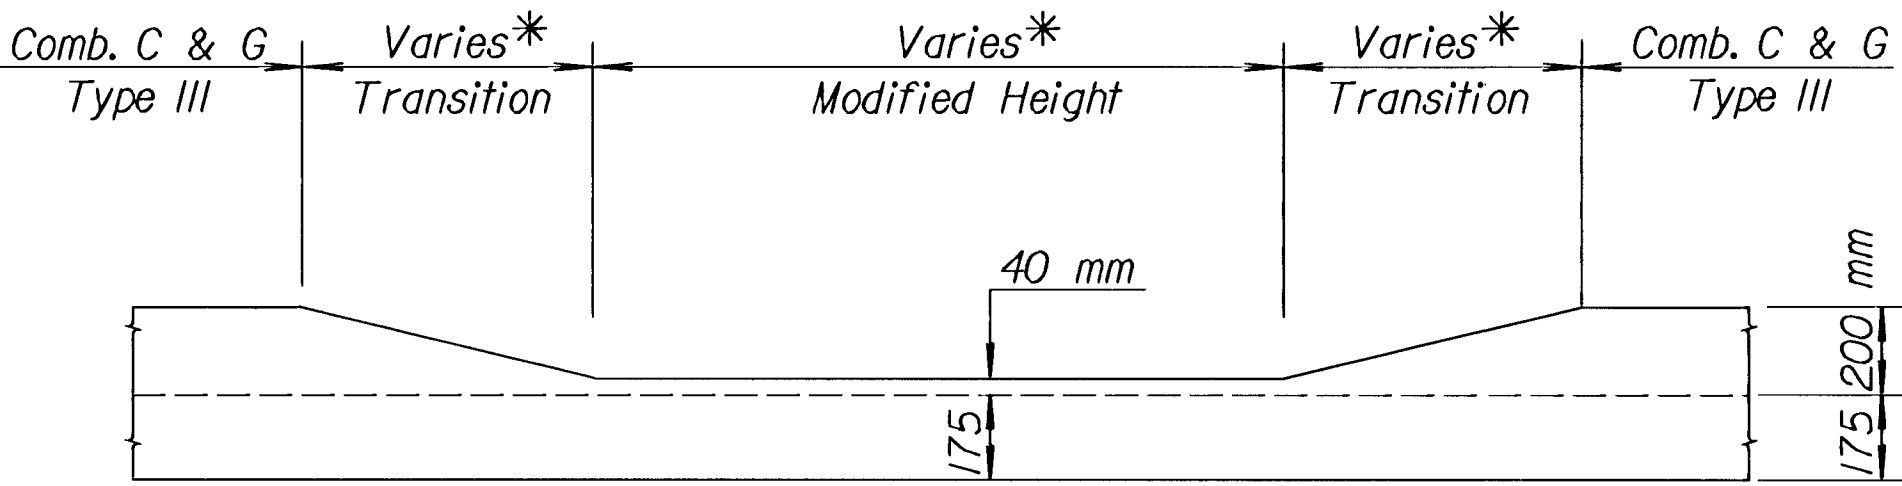


COMBINED CURB AND GUTTER TYPE III
TRANSITION AT MEDIAN NOSE


* See Plan Sheet for Transition locations

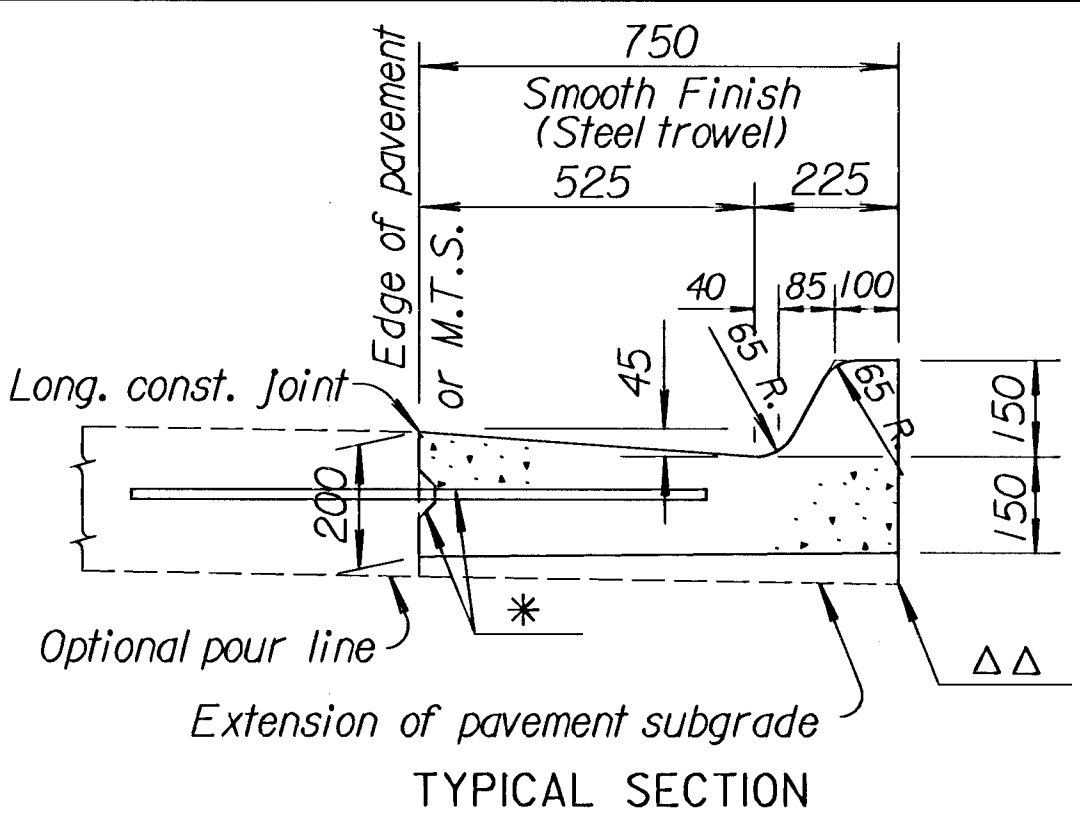

COMBINED CURB & GUTTER - TYPE I (750 mm WIDTH)

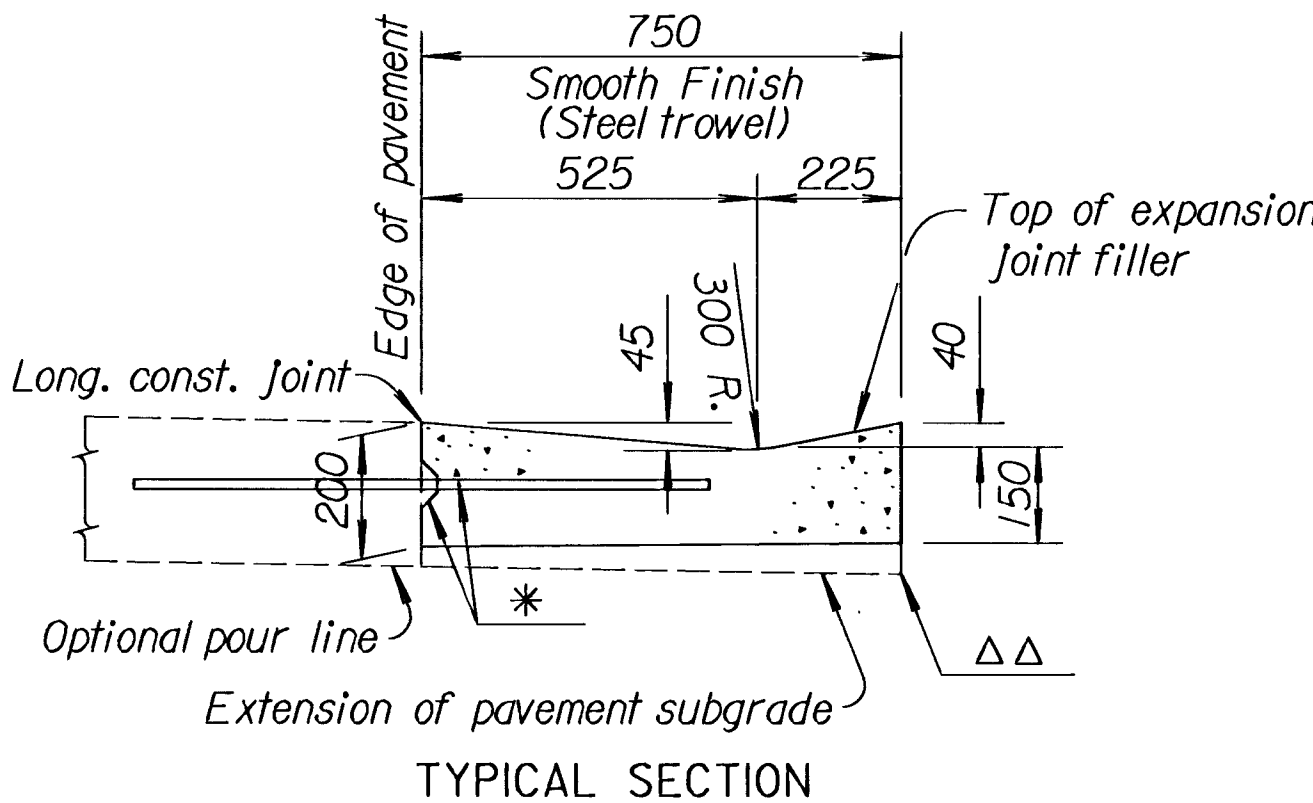

COMBINED CURB & GUTTER - TYPE II (750 mm WIDTH)

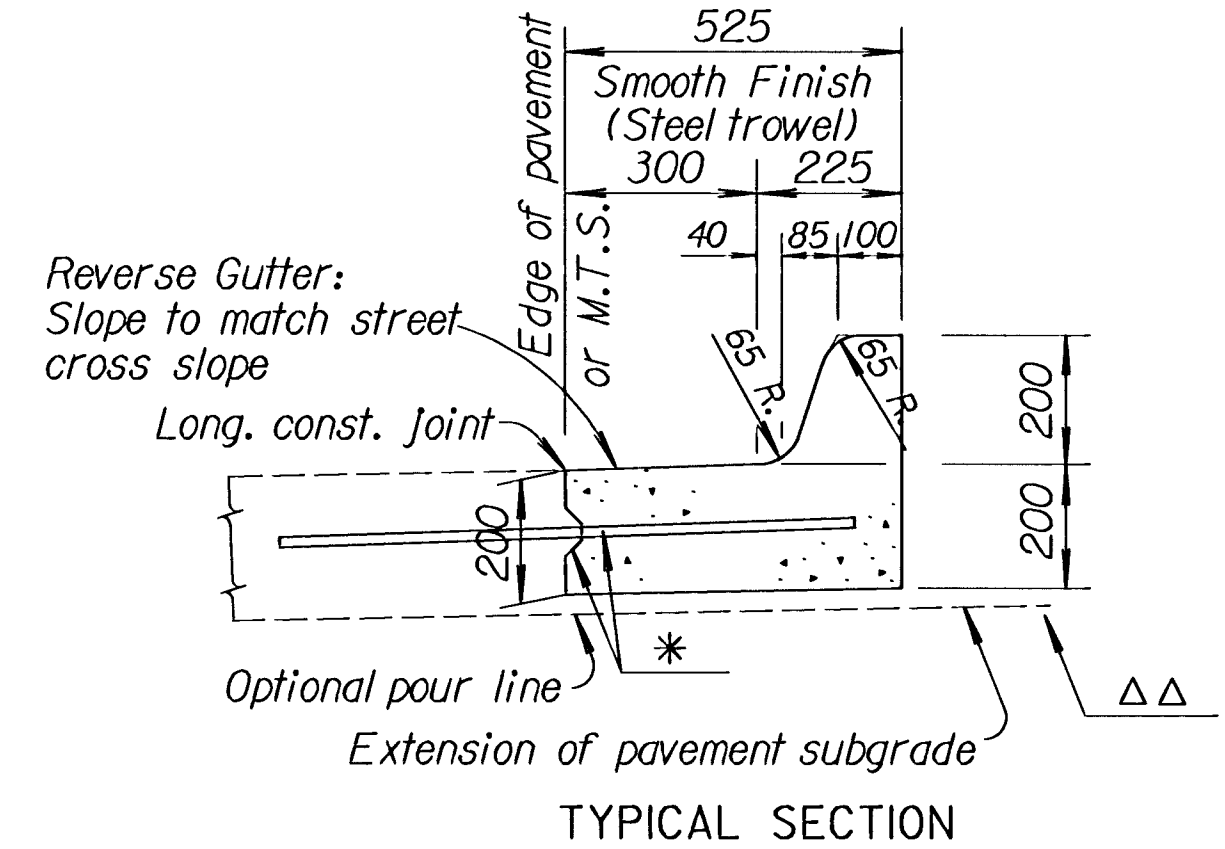


COMBINED CURB & GUTTER - TYPE III (525 mm WIDTH)

* Longitudinal construction joint and #16 x 900 mm bars @ 750 mm ctrs., where concrete pavement is constructed.

△△ Contractor has the option of thickening the curb and gutter as shown.

"D" = Pavement thickness

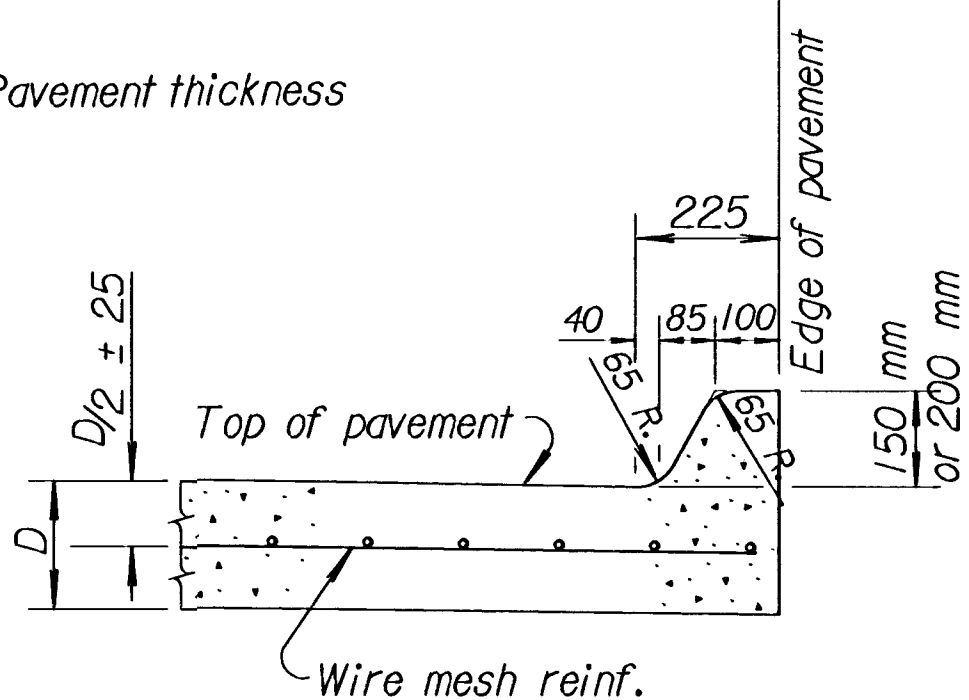


TYPICAL SECTION

150 mm OR 200 mm EDGE CURB
(MONOLITHIC)

Note: Planes of weakness are to be constructed over the contraction joints in the concrete pavement.
A 25 mm pre-moulded Expansion Joint Filler (Nonextruding, Type B) cut to the dimensions of the Edge Curb shall be used over the expansion joints in the concrete pavement.

EDGE CURB

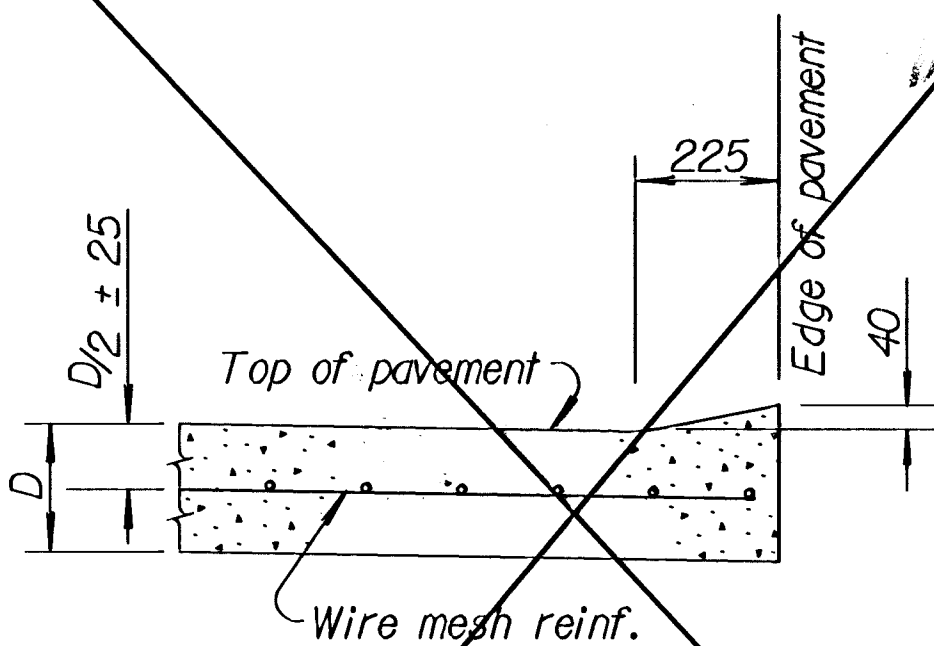


TYPICAL SECTION

40 mm EDGE CURB
(MONOLITHIC)

NO.	DATE	REVISIONS	BY	APP'D
5	4-30-02	Rev. concrete from Class to Grade.	S.W.K.	J.O.B.
3	12-16-97	Revised Protection Curb Width	R.J.S.	J.O.B.
2	1-27-97	Revised Rebar Designation	R.J.S.	J.O.B.

KANSAS DEPARTMENT OF TRANSPORTATION			
CURB, GUTTER AND COMBINED CURB & GUTTER			
RD740-SI		15	
DESIGNED	5-01-02	APP'D. James O. Brewer	
DESIGN CK.	DETAIL CK.	QUANTITIES	TRACED BOWSER
		QUAN. CK.	TRACE CK. Seitz

Drawn By: mark
Plotted: 04/30/03
File: H:\CIVIL\01053\06\WR0740SI.DGN

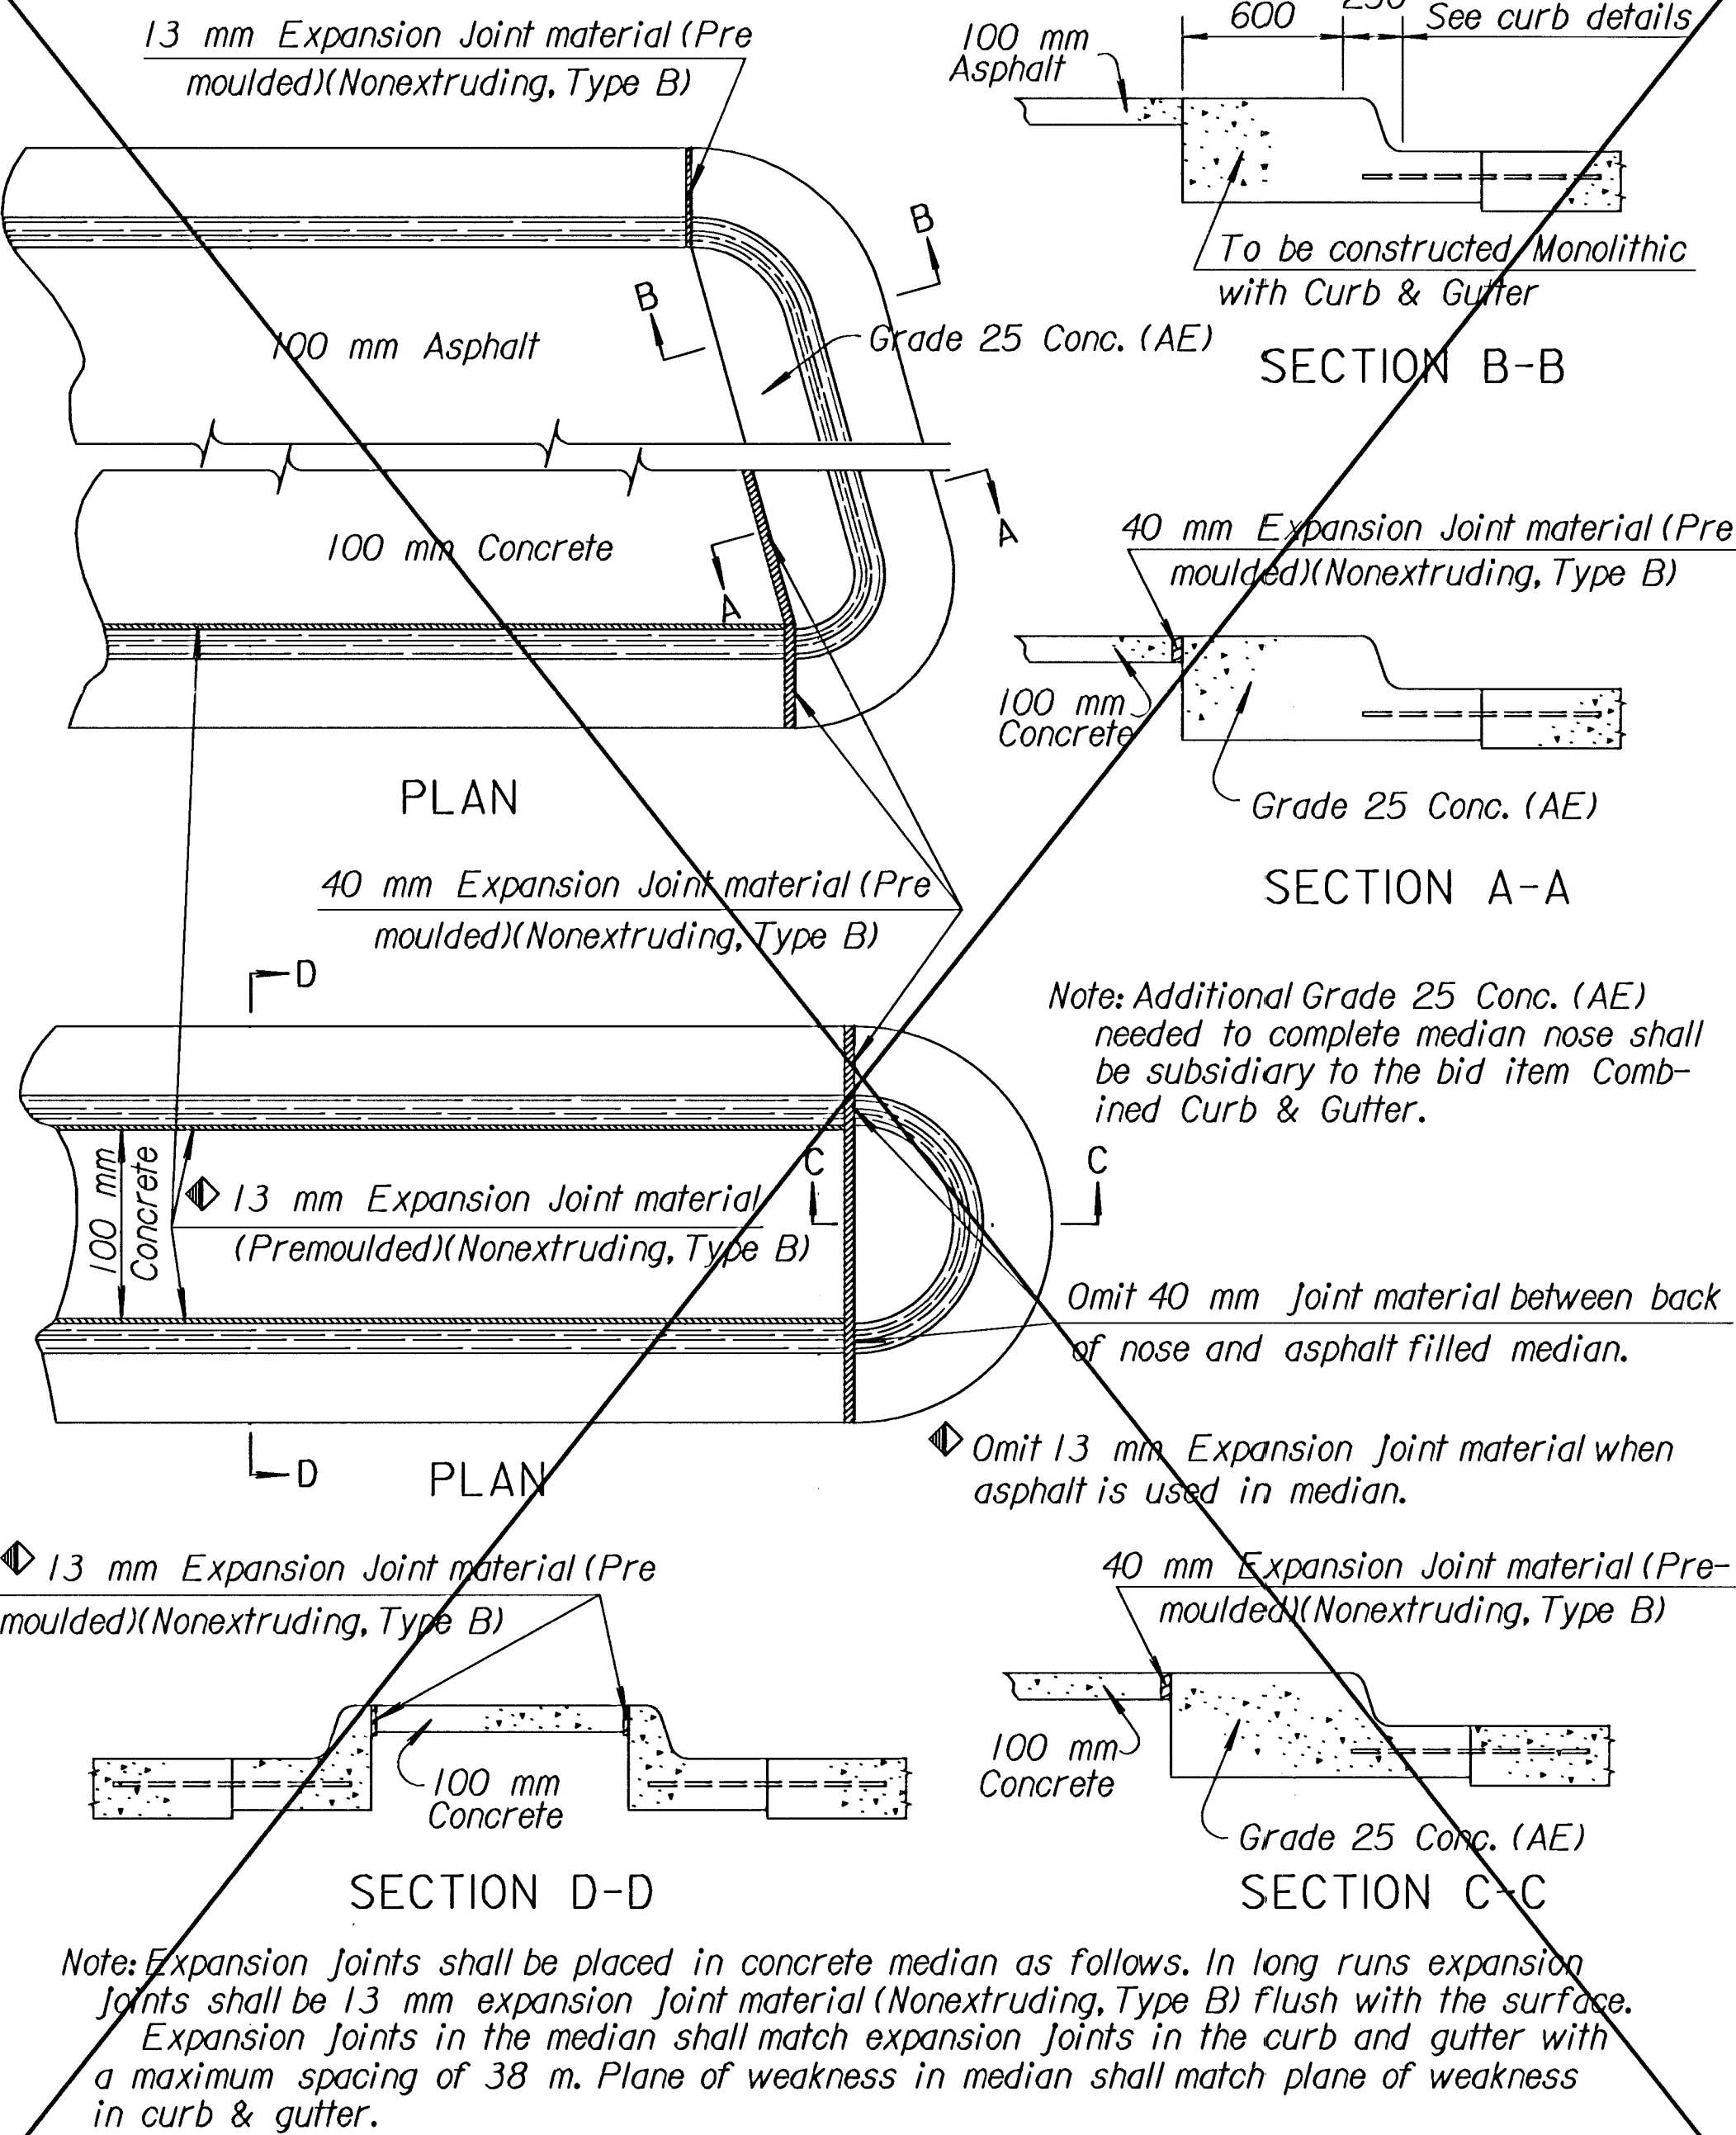

TYPICAL NOSE DETAILS FOR RAISED MEDIANS

COMBINED CURB & GUTTER - TYPE III (525 mm WIDTH)
MODIFIED HEIGHT