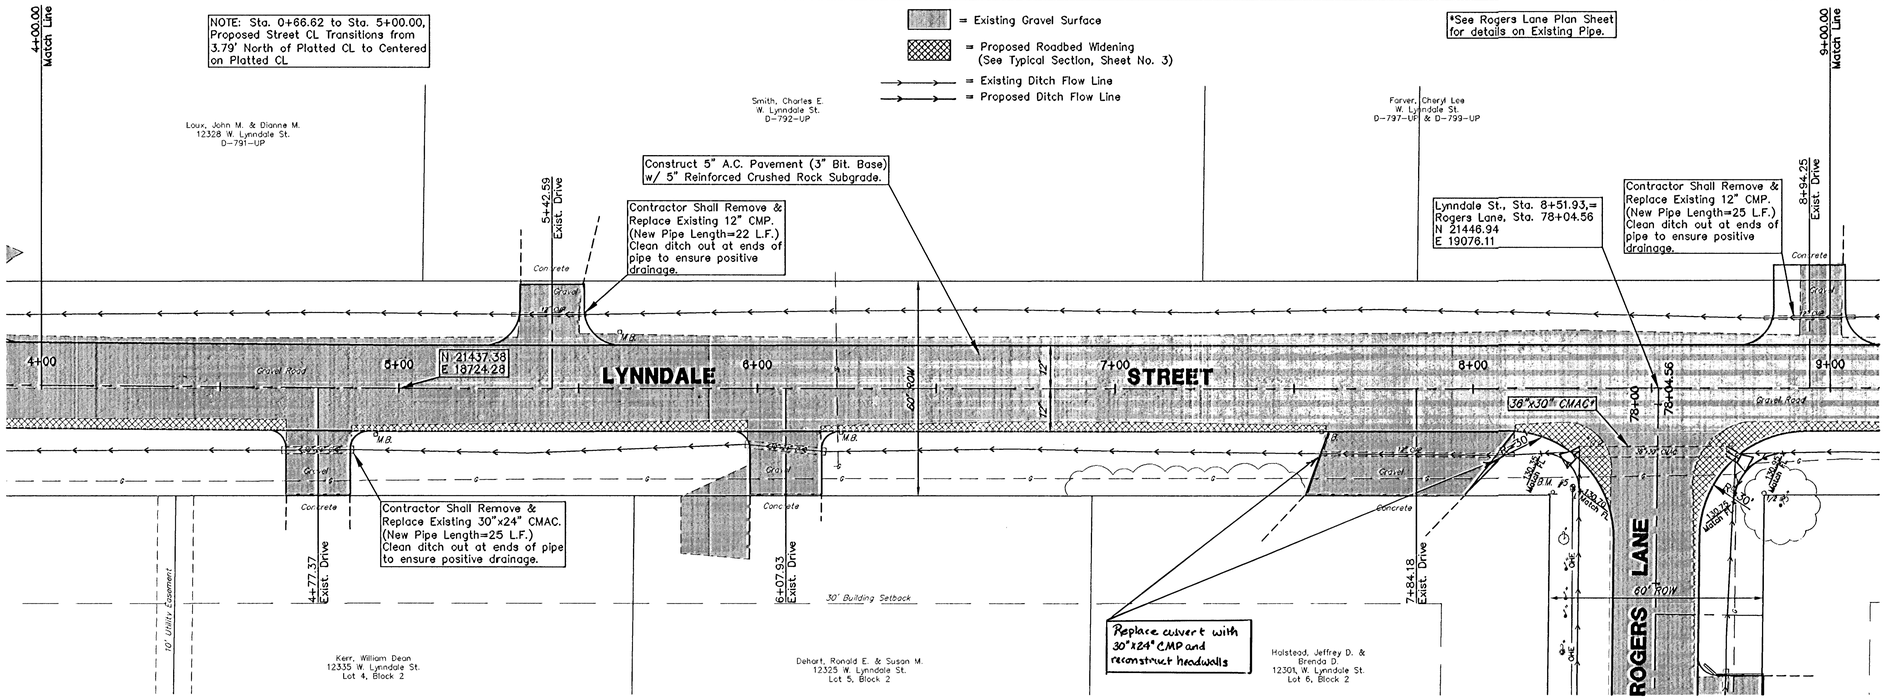


C. PATE ADDITION TO WHEATRIDGE
WICHITA, SEDGWICK COUNTY, KANSAS

GRAPHIC SCALE

20 0 10 20 40

(IN FEET)
1 inch = 20 ft.


LEGEND

G = GAS MAIN
W = WATER MAIN
SS = SANITARY SEWER
SWS = STORM WATER SEWER
UGE = UNDER GROUND ELECTRIC
UGT = UNDER GROUND TELEPHONE

- B.M. . . . . BENCH MARK
- T.P. . . . . TELEPHONE PEDESTAL
- F.H. . . . . FIRE HYDRANT
- G.A. . . . . GUY ANCHOR
- G.P. . . . . GUARD POST
- H.L.P. . . . . HIGH LINE POLE
- L.P. . . . . LIGHT POLE
- M.B. . . . . MAIL BOX
- P.P. . . . . POWER POLE
- SH . . . . . SPRINKLER HEAD
- SIGN . . . . . SIGN
- WELL . . . . . WATER WELL
- W.V. . . . . WATER VALVE
- SS M.H. . . . . SANITARY SEWER MANHOLE

UTILITIES SHOWN REPRESENT THE BEST INFORMATION AVAILABLE FOR DESIGN. ADDITIONAL UTILITIES MAY BE PRESENT ON THIS PROJECT. THE CONTRACTOR SHALL BE RESPONSIBLE FOR DETERMINING THE EXACT LOCATION, DEPTH AND SIZE OF ALL UNDERGROUND UTILITIES PRIOR TO CONSTRUCTION. THE CONTRACTOR SHALL BE LIABLE FOR ANY DAMAGE CAUSED BY THE FAILURE TO DO SO.

SURVEY DISCLAIMER:
TOPOGRAPHIC SURVEY AND CONTOUR MAP USED IN PREPARING PLANS WAS PROVIDED BY SAVOY COMPANY, P.A., 535 S. EMPORIA, SUITE 104, WICHITA, KS. ENGINEER DOES NOT GUARANTEE SURVEY ELEVATIONS FOR ACCURACY. CONTRACTOR SHALL VERIFY ELEVATIONS AND NOTIFY ENGINEER OF ANY DISCREPANCIES.

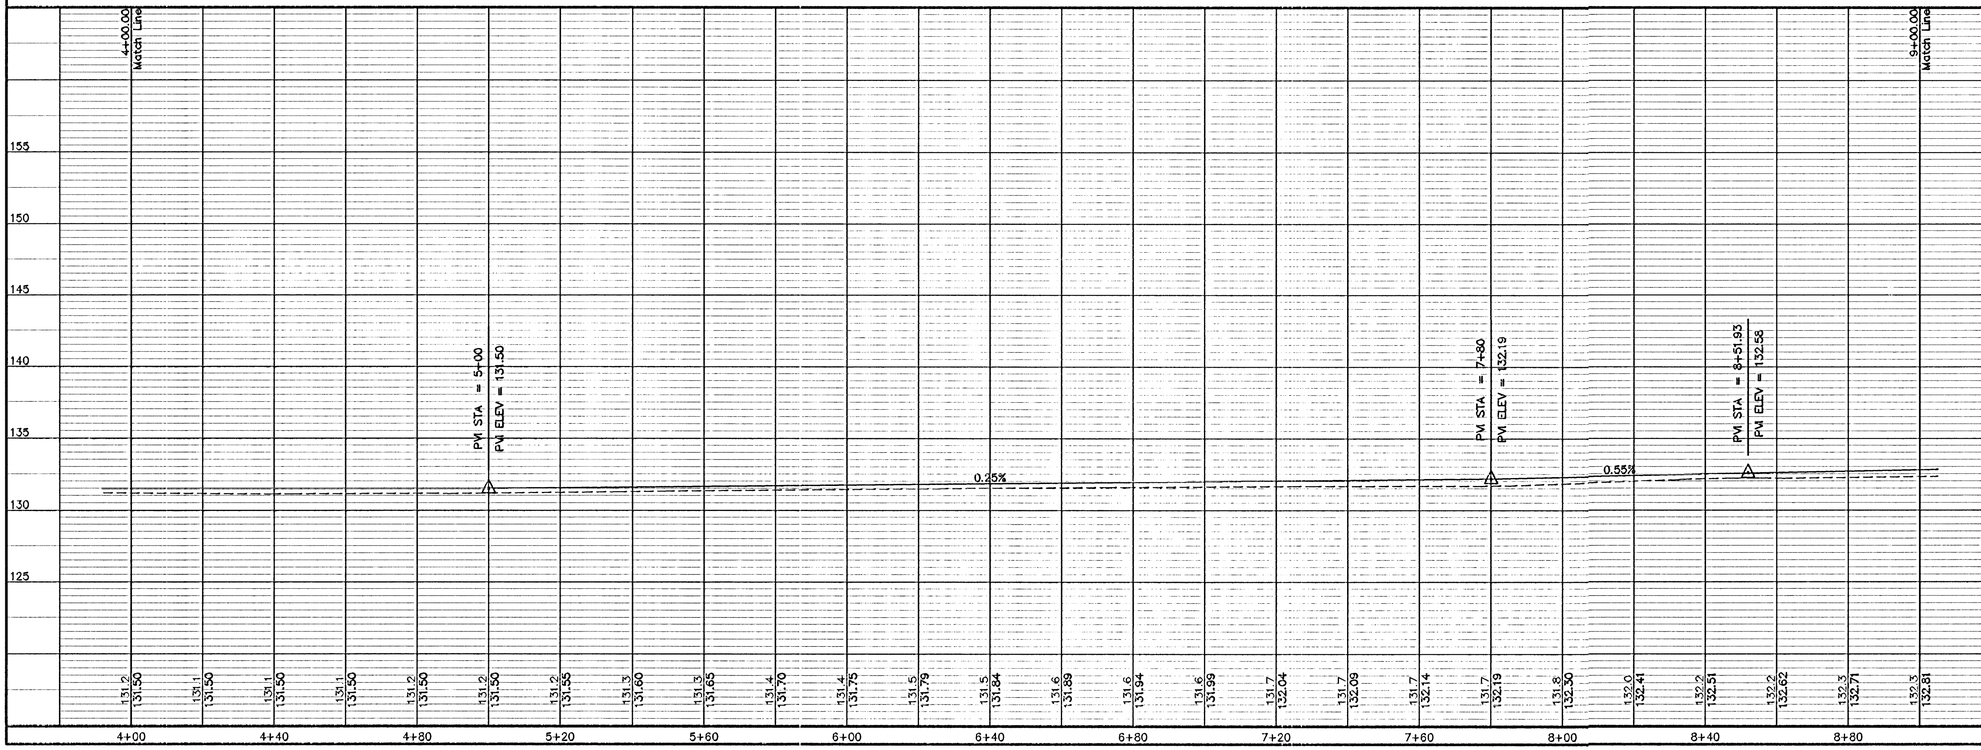

PAVING PLANS FOR
LYNNDALE STREET
WICHITA, SEDGWICK COUNTY, KANSAS
CED PRO. NO.: 20030988

CERTIFIED ENGINEERING DESIGN, P.A.
810 WEST DOUGLAS, SUITE C
WICHITA, KANSAS 67203
PH.(316)262-8808 FAX.(316)262-1669

DESIGNED: HDF	SCALE: 1"=20'	SHEET 5
DRAWN: CKW	DATE: 6/03	
CHECKED: HDF	CED FILE: Wheat-Base.dwg	TOTAL 43