BENCHMARKS:
City of Wichita Disc at Southwest Corner of 135th St. W. & 13th St. N
30.00'± S. of ℄
35.00'± W. of ℄
Elev. = 1355.65 NGVD29

Small Railroad Spike in 2nd HLP W. of 135th St. W. on South Side of 13th St. N., (N. Face of HLP).
Elev. = 1359.50 NGVD29

Small Railroad Spike in 4th HLP W. of 135th St. W. on South Side of 13th St. N., (N. Face of HLP).
Elev. = 1366.64 NGVD29

Sta. 27+46.5, Line 1
Match Point

CO# 1

Sta. 29+17.8 to Sta. 29+76.8
Install 59.0 L.F. Flowable Fill
Per City Specifications.
Fill to Elev. 1368.00

Proposed 8" Wtr Line Crossing

Sta. 31+04.4, Line 1
Construct Standard Manhole.
Top Elev. = 1372.60

Sta. 33+98.4, Line 1
Construct Standard Manhole.
Top Elev. = 1374.60

Sta. 36+82.6, End Line 1
Construct Standard Manhole. 1-4" Stub (NW)
Top Elev. = 1376.20

BLACKSTONE ADDITION

BLACKSTONE CT.

LINE 1

RES. "A"
RES. "B"
RES. "C"
RES. "D"
RES. "E"
RES. "F"
RES. "G"

Prop. 8" Water Line
Prop. 6" Water Line
Proposed AC Paving

SCALE:
1" = 40' HORIZONTAL
1" = 5' VERTICAL
• = IRON

The Contractor shall be required to backfill trench with sand from Sta. 27+46.5 to Sta. 36+82.6, Line 1 excluding locations where Flowable Fill is called out. To be bid as "L.F. Sand Backfill Jetted and Vibrated"

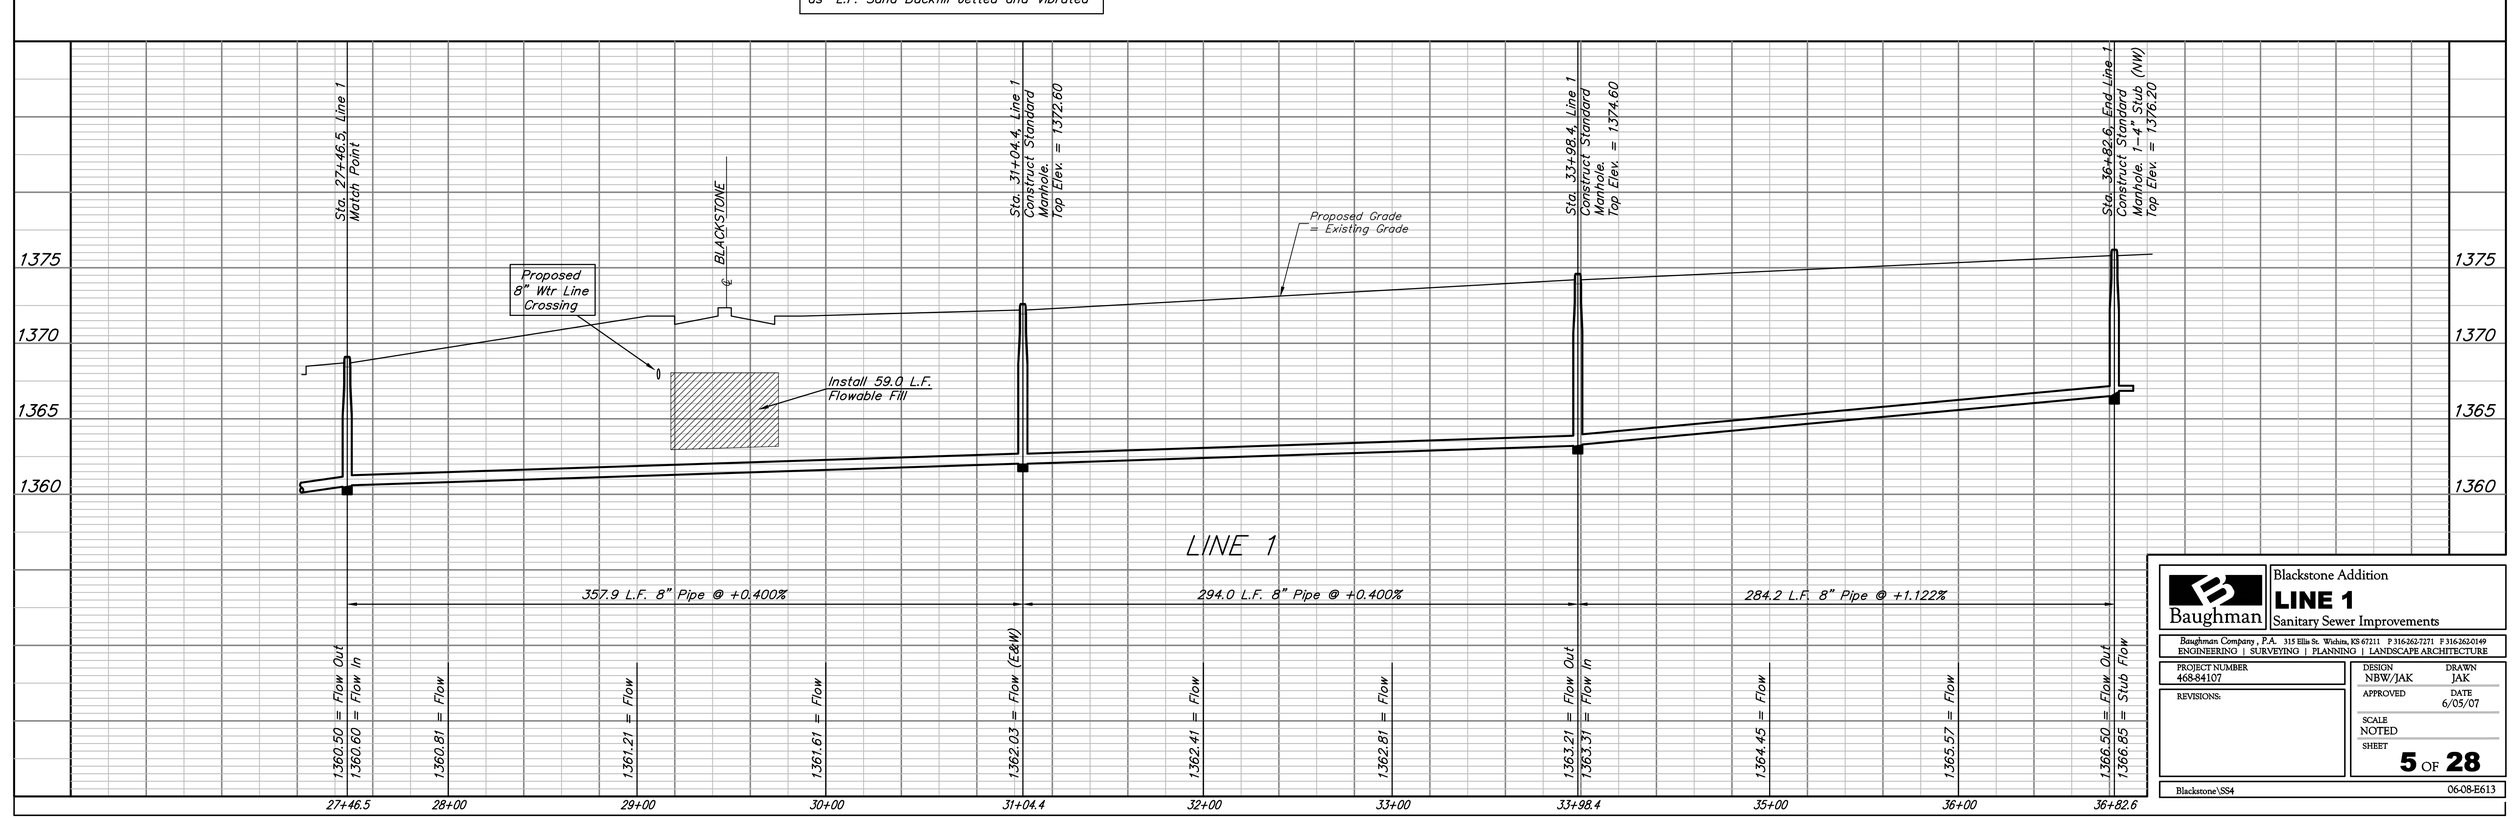

Baughman

Blackstone Addition
LINE 1
Sanitary Sewer Improvements

Baughman Company, P.A. 315 Ellis St. Wichita, KS 67211 P 316-262-7271 F 316-262-0149
ENGINEERING | SURVEYING | PLANNING | LANDSCAPE ARCHITECTURE

PROJECT NUMBER 468-84107	DESIGN NBW/JAK — DRAWN JAK
REVISIONS:	APPROVED — DATE 6/05/07
	SCALE NOTED
	SHEET **5** OF **28**

Blackstone\SS4 — 06-08-E613