


File: i:\1995\95088\revised\dougan2.dgn
 drawn by: jpr/wll/ras
 plotted by: ras 2-10-99



Note: See Sheet C2 for Utility Information.

LEGEND
 Brick

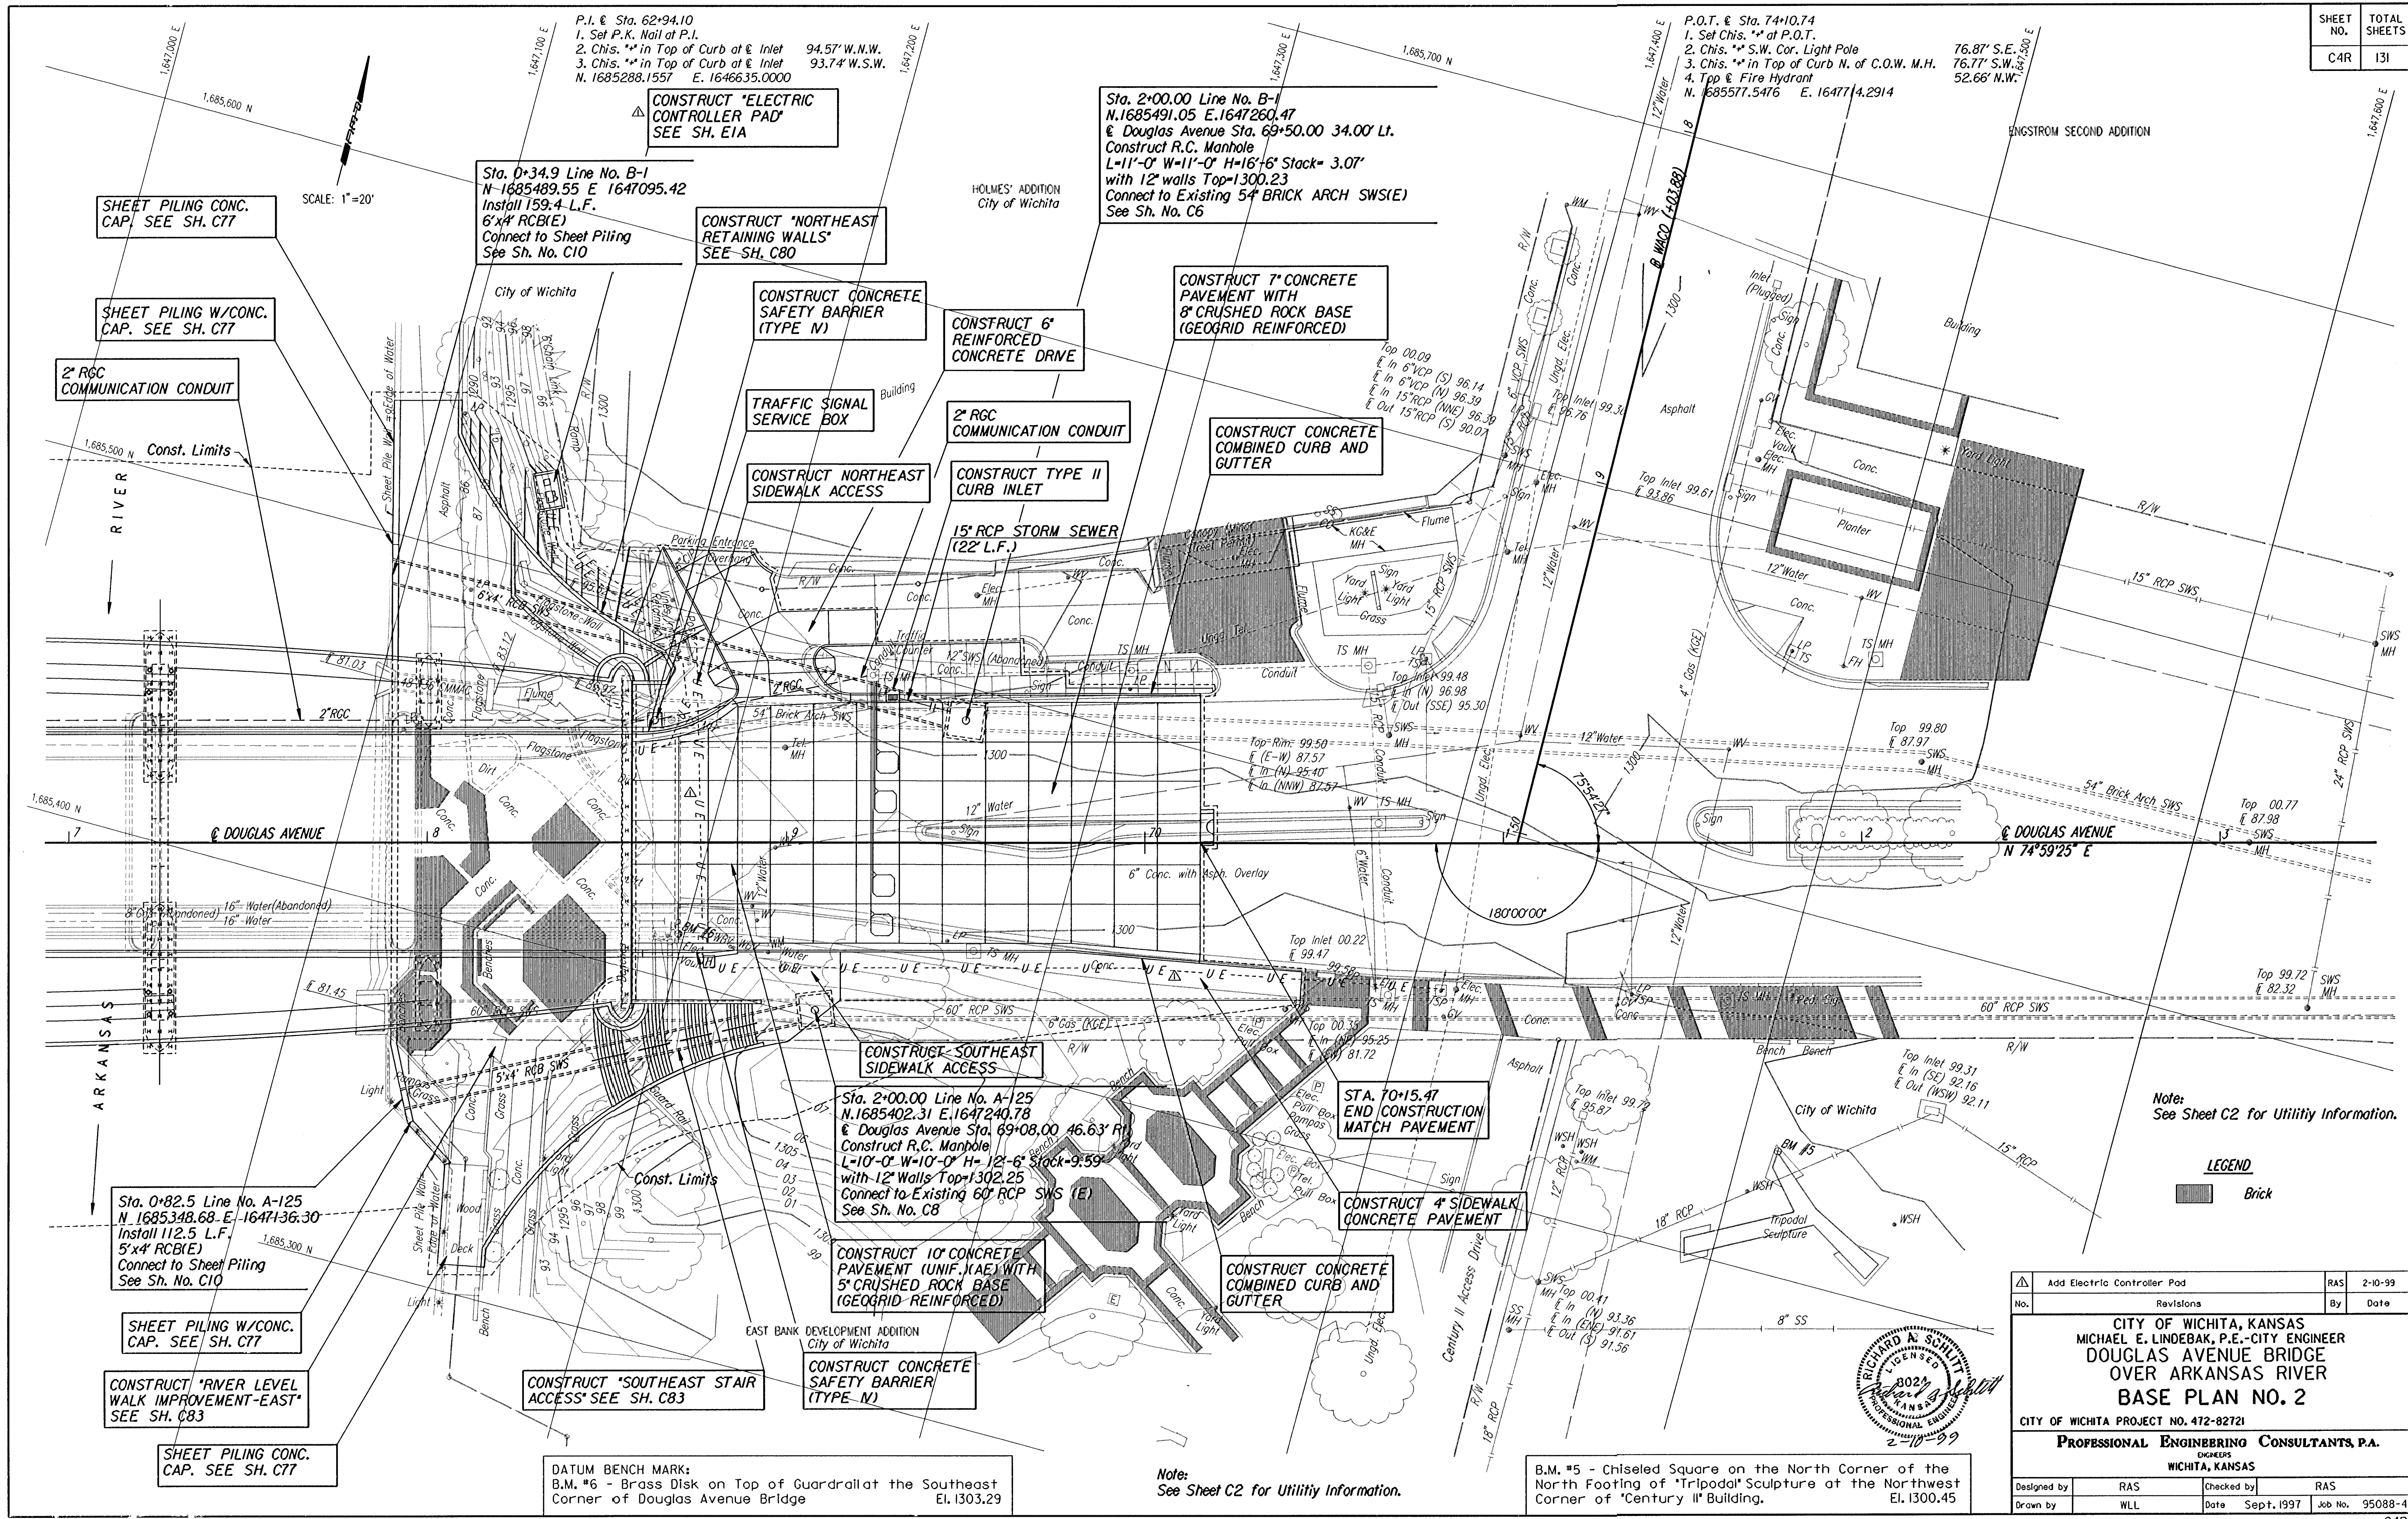

Add Electric Controller Pad		RAS	2-10-99
No.	Revisions	By	Date
CITY OF WICHITA, KANSAS MICHAEL E. LINDEBAK, P.E. - CITY ENGINEER DOUGLAS AVENUE BRIDGE OVER ARKANSAS RIVER BASE PLAN NO. 2 CITY OF WICHITA PROJECT NO. 412-82721 PROFESSIONAL ENGINEERING CONSULTANTS, P.A. ENGINEERS WICHITA, KANSAS			
Designed by	RAS	Checked by	RAS
Drawn by	WLL	Date	Sept. 1997
		Job No.	95088-4

B.M. #5 - Chiseled Square on the North Corner of the North Footing of 'Tripodal' Sculpture at the Northwest Corner of 'Century II' Building. El. 1300.45

Note: See Sheet C2 for Utility Information.

DATUM BENCH MARK:
 B.M. #6 - Brass Disk on Top of Guardrail at the Southeast Corner of Douglas Avenue Bridge El. 1303.29